

ASPEN RIDGE MULTI-FAMILY DEVELOPMENT


ASPEN RIDGE, LLC

ASPEN RIDGE AT BUCKHORN VALLEY P.U.D.
 A RESUBDIVISION OF TRACT D, BUCKHORN VALLEY EXEMPTION
 ALL UTILITIES & AS BUILT TOPO

GUERDON HOMES MODEL NUMBERS

- A=4TS-3034-01
- B=4TS-3046-01 C=4TS-3032-01
- D=2TS-1554-02 E=2TS-1556-01

UTILITY LEGEND:	
Property Lines	Natural Gas Line
Phase Construction Line	Electric Conduit 2" & 4" (Elec. services)
Easement Lines	Single Phase Transformer
Edge of Pavement	Wood Post Utility Marker (PUC)
Curb & Gutter Flow Line	Light Pole
Sanitary Sewer Manhole	Electric, Telephone & Television Line
Sanitary Sewer Service (4" SDR35)	Telephone Pedestal
Sanitary Sewer Line	Telephone Handhold Box
Storm Sewer Manhole	Fire Hydrant Assembly
Storm Sewer Line	Water Service (3/4" copper) w/ Curb Stop
Storm Sewer TYPE 13 INLET	Water Line
Flowline Direction Arrow	Water Valve
Dimensions (center manhole to center manhole)	Air Release Valve
Electric Manhole	Irrigation Line
Natural Gas Service w/ Marker	Irrigation Valve

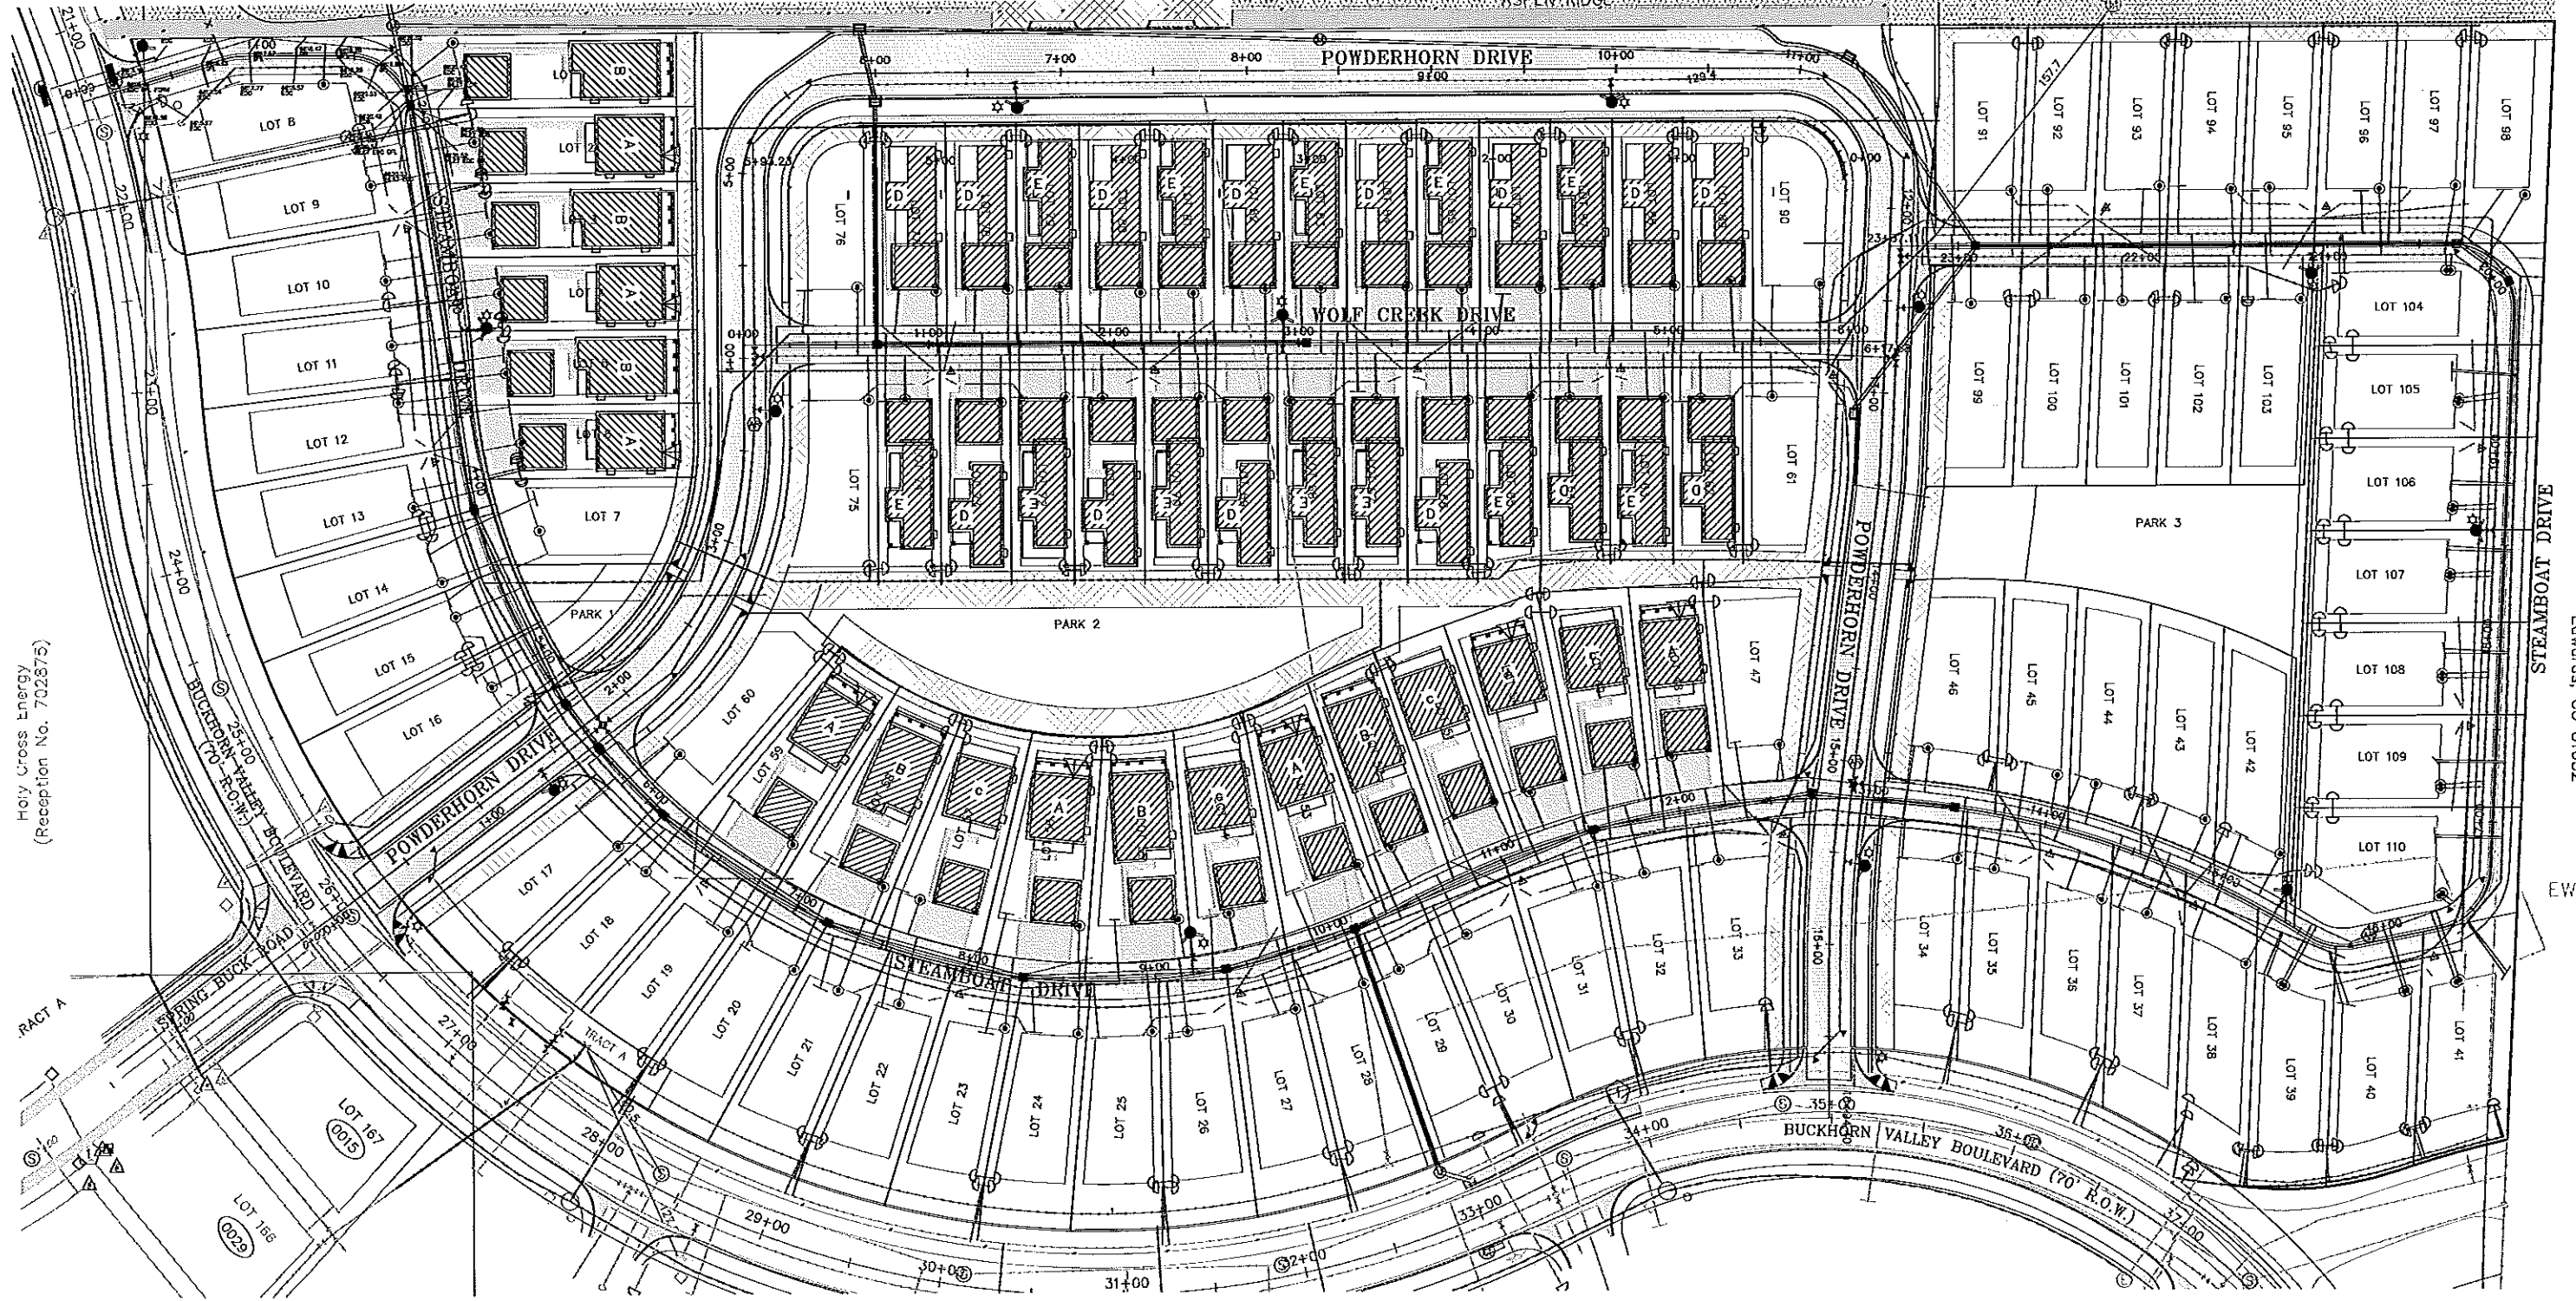

Holy Cross Energy
 (Reception No. 702875)

STEAMBOAT DRIVE
 EWI
 700105, U 010074