


LOTS 3,5,7 & 8

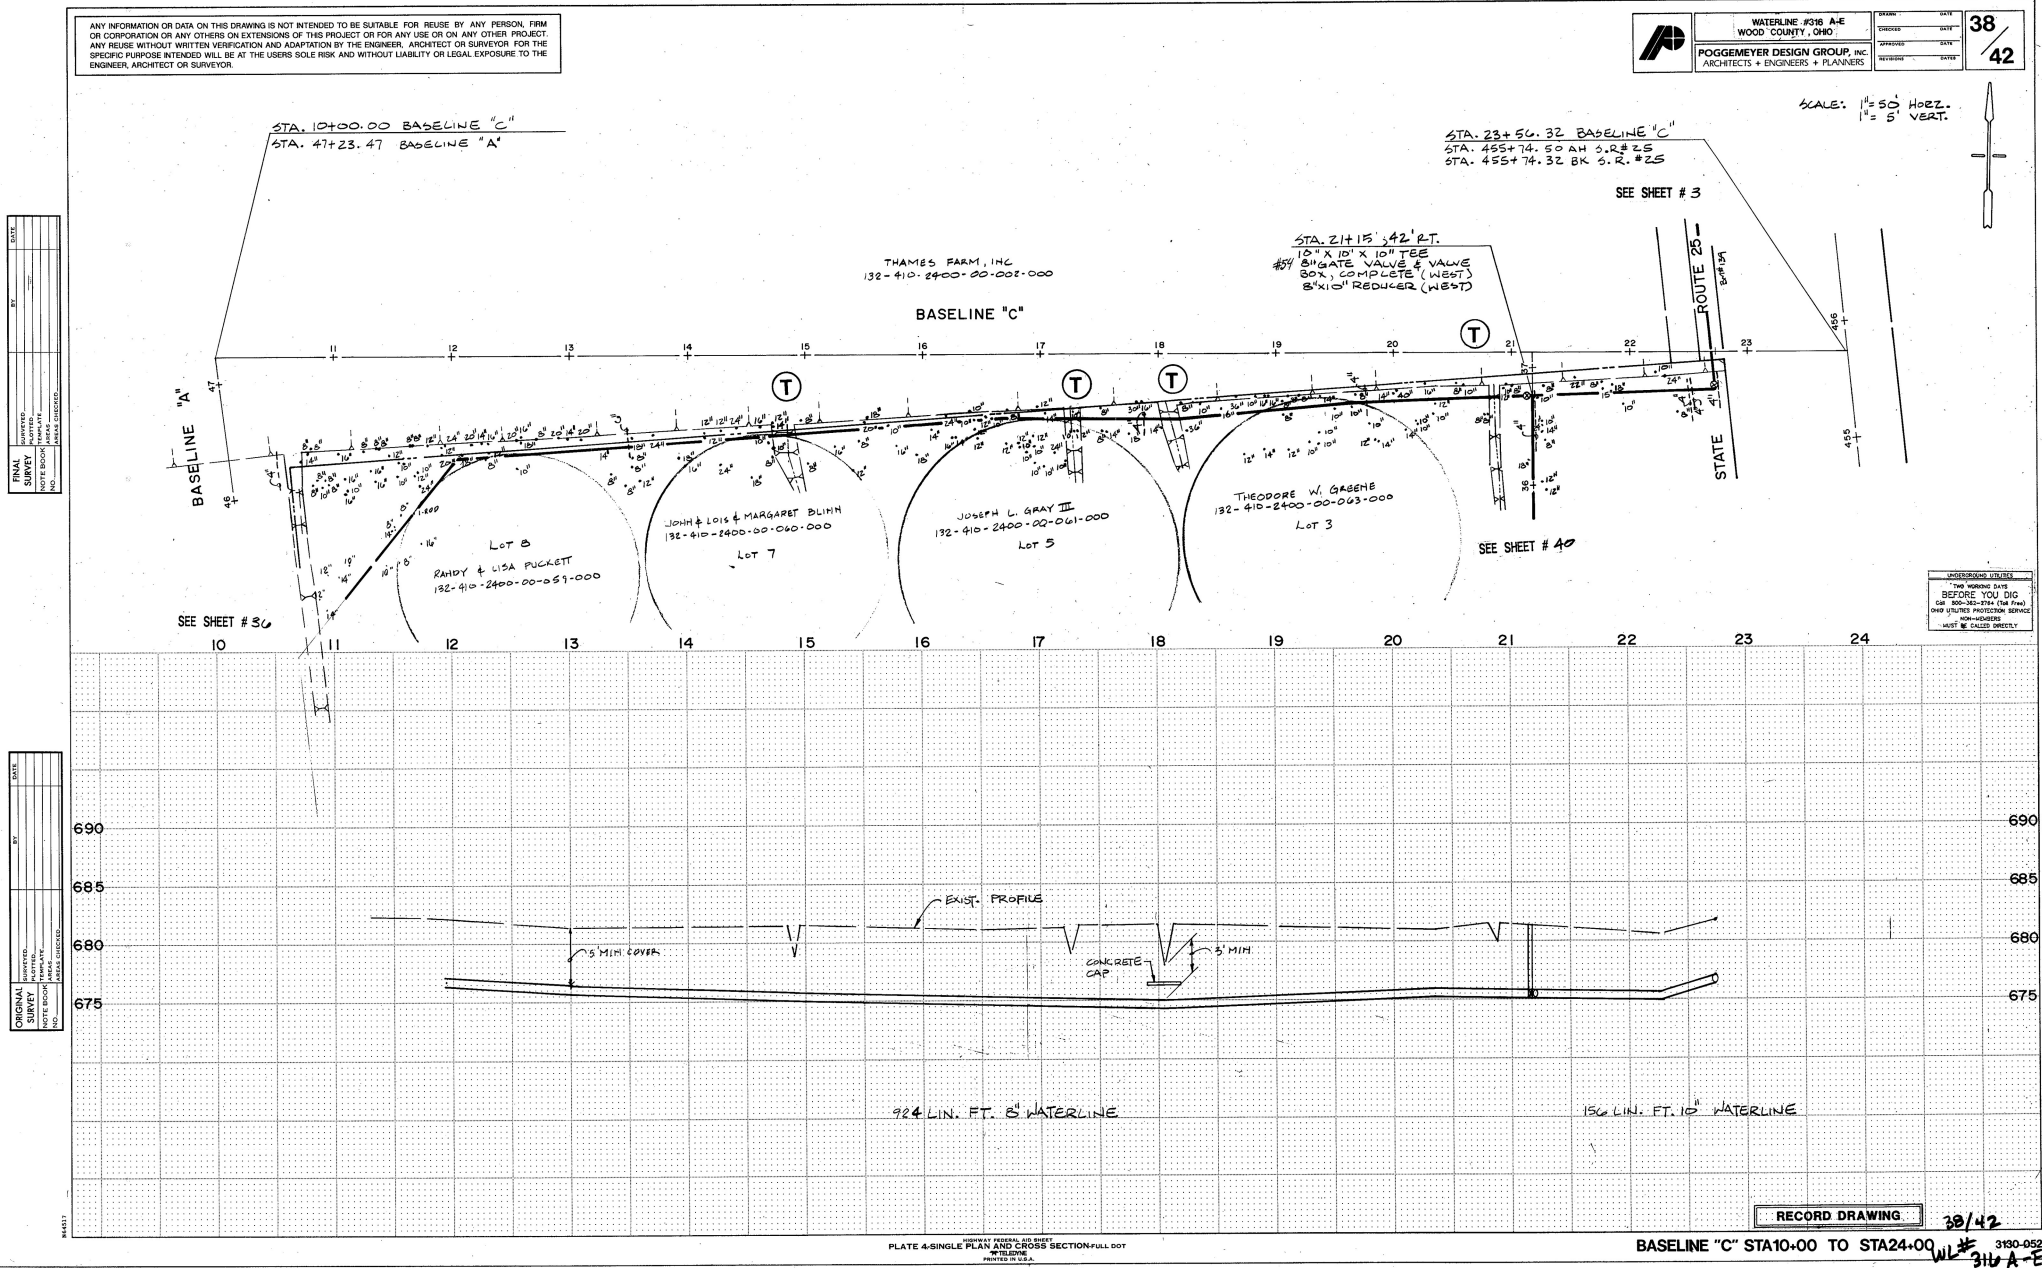

LOTS 9 - 14

ANY INFORMATION OR DATA ON THIS DRAWING IS NOT INTENDED TO BE SUITABLE FOR REUSE BY ANY PERSON, FIRM OR CORPORATION OR ANY OTHERS ON EXTENSIONS OF THIS PROJECT OR FOR ANY USE OR ON ANY OTHER PROJECT. ANY REUSE WITHOUT WRITTEN VERIFICATION AND ADAPTATION BY THE ENGINEER, ARCHITECT OR SURVEYOR FOR THE SPECIFIC PURPOSE INTENDED WILL BE AT THE USERS SOLE RISK AND WITHOUT LIABILITY OR LEGAL EXPOSURE TO THE ENGINEER, ARCHITECT OR SURVEYOR.



WATERLINE #316 A-E
WOOD COUNTY, OHIO

POGGEMEYER DESIGN GROUP, INC.
ARCHITECTS + ENGINEERS + PLANNERS



$$\frac{36}{42}$$

SCALE: $1'' = 50'$ HORIZ.
 $1'' = 5'$ VERT.

LOLA B. JUDSON
132-410-2400-00-003-000

THAMES FARM, INC.
132-410-2400-00-002-000

UNDERGROUND UTILITIES
TWO WORKING DAYS
BEFORE YOU DIG
Call 800-362-2784 (Toll Free)
OHIO UTILITIES PROTECTION SERVICE
NON-MEMBERS
MUST BE CALLED DIRECTLY

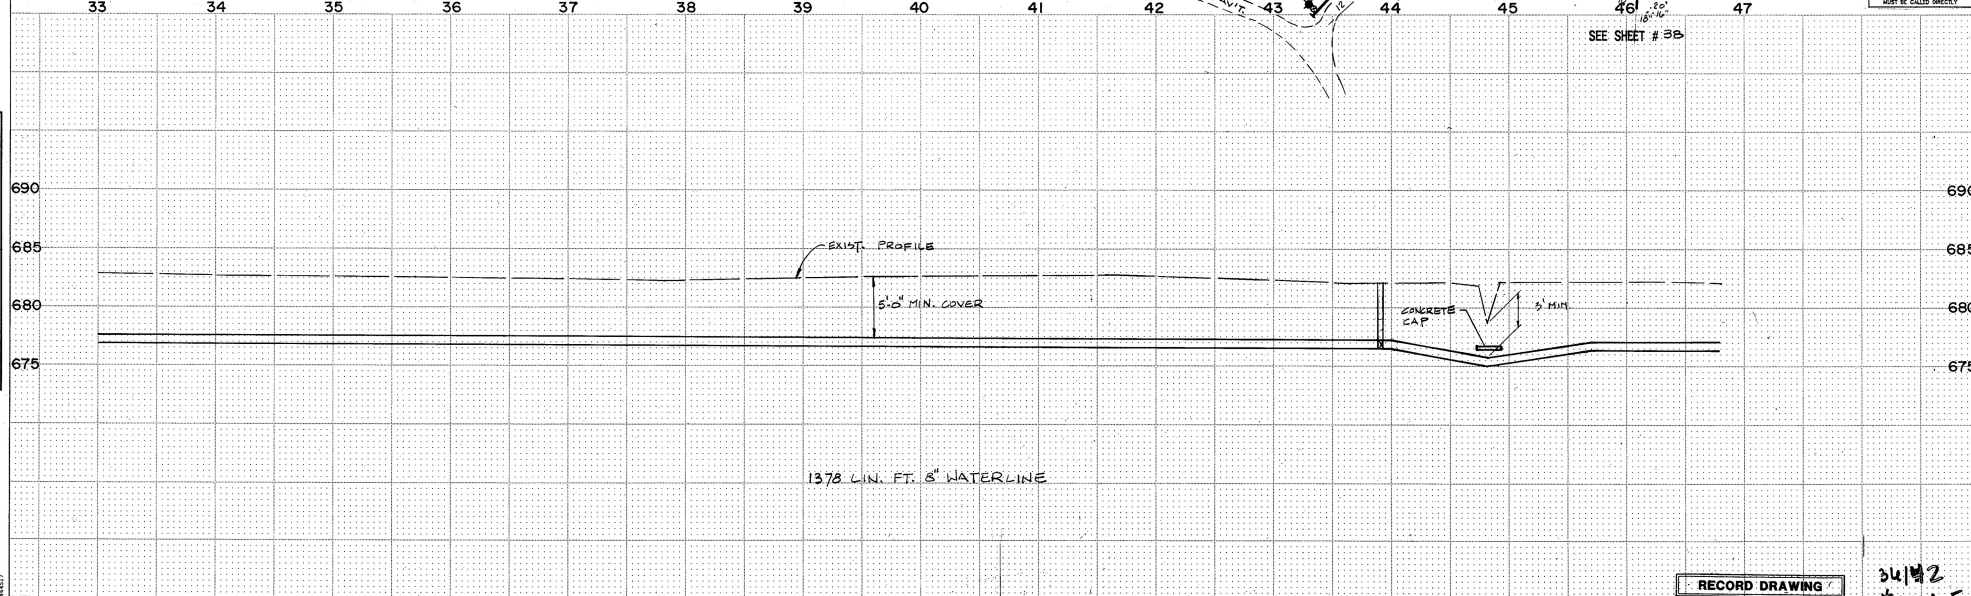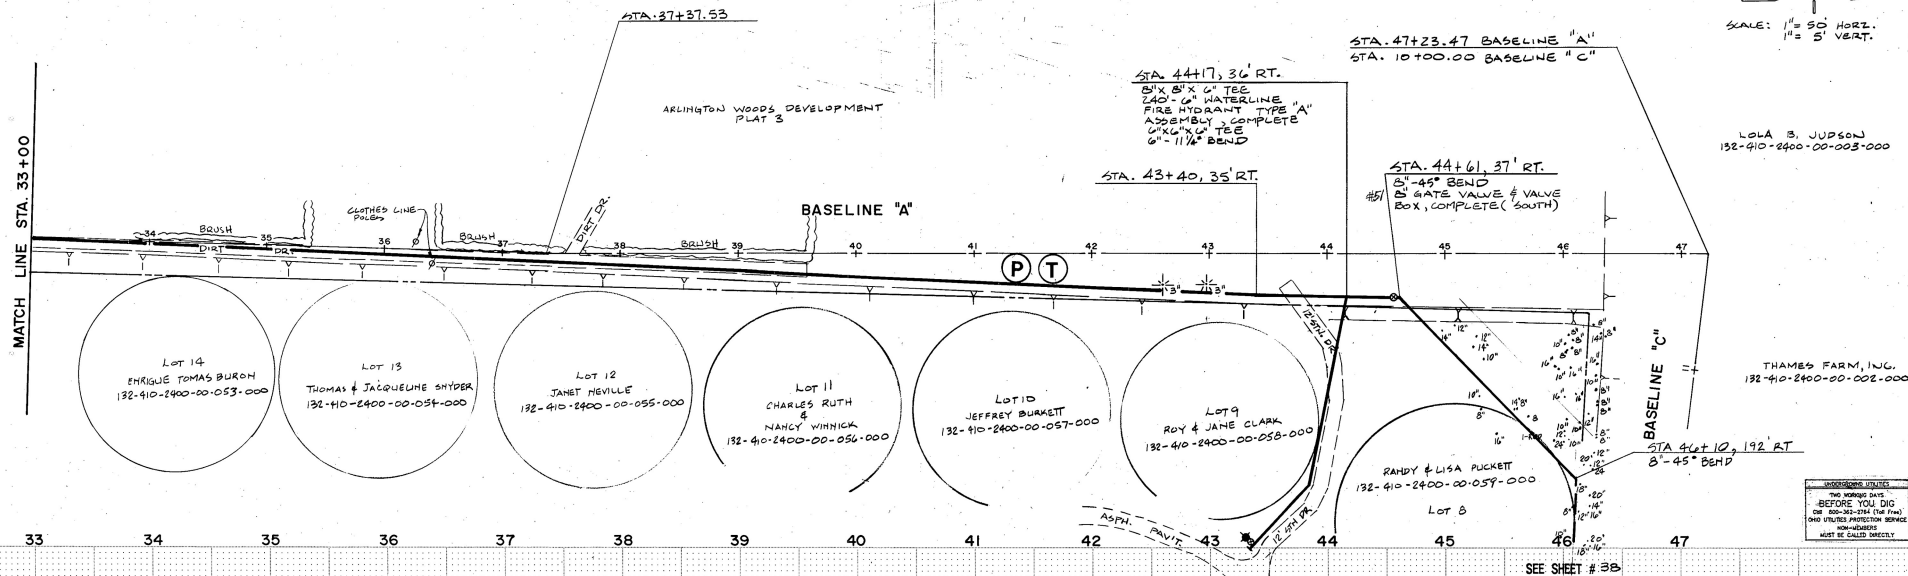

RECORD DRAWING

34142
#310A-E

BASELINE "A" STA33+00 TO STA47+00 #310 A-E
3130-052

PLATE 4-SINGLE PLAN AND CROSS SECTION-FULL DOT

LOT 15

ANY INFORMATION OR DATA ON THIS DRAWING IS NOT INTENDED TO BE SUITABLE FOR REUSE BY ANY PERSON, FIRM OR CORPORATION OR ANY OTHERS ON EXTENSIONS OF THIS PROJECT OR FOR ANY USE OR ON ANY OTHER PROJECT. ANY REUSE WITHOUT WRITTEN VERIFICATION AND ADAPTATION BY THE ENGINEER, ARCHITECT OR SURVEYOR FOR THE SPECIFIC PURPOSE INTENDED WILL BE AT THE USER'S SOLE RISK AND WITHOUT LIABILITY OR LEGAL EXPOSURE TO THE ENGINEER, ARCHITECT OR SURVEYOR.



WATERLINE #316 A-E
WOOD COUNTY, OHIO
POGGENMEYER DESIGN GROUP, INC.
ARCHITECTS + ENGINEERS + PLANNERS

35/42
DATE: _____
CHECKED: _____
APPROVED: _____
DESIGNED: _____

SCALE: 1" = 50' HORIZ.
1" = 5' VERT.

NOTE: SANITARY SEWER FORCE MAINS IN THE AREA OF THE EXISTING 12" STONE DRIVE SHALL BE FIELD LOCATED PRIOR TO ANY EXCAVATION IN THIS AREA. OTHER UNDERGROUND UTILITIES MAY ALSO BE LOCATED IN OR NEAR THIS AREA.


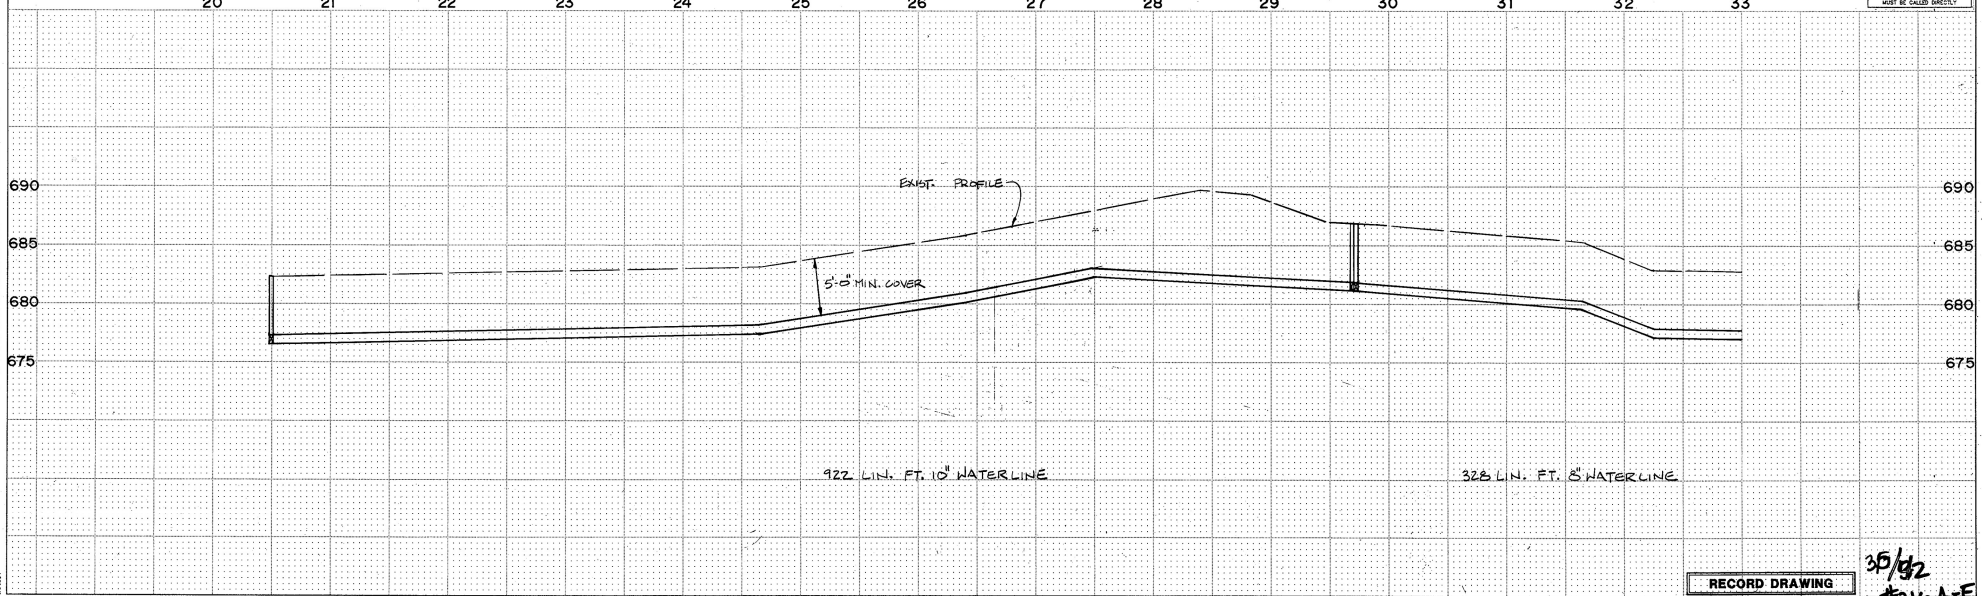


PLATE 4-SINGLE PLAN AND CROSS SECTION FULL DOT
PRINTED IN U.S.A.

RECORD DRAWING
BASELINE "A" STA20+00 TO STA33+00
316 A-E
316-052

LOTS 16 - 20

ANY INFORMATION OR DATA ON THIS DRAWING IS NOT INTENDED TO BE SUITABLE FOR REUSE BY ANY PERSON, FIRM OR CORPORATION OR ANY OTHERS ON EXTENSIONS OF THIS PROJECT OR FOR ANY USE OR ON ANY OTHER PROJECT. ANY REUSE WITHOUT WRITTEN VERIFICATION AND ADAPTATION BY THE ENGINEER, ARCHITECT OR SURVEYOR FOR THE SPECIFIC PURPOSE INTENDED WILL BE AT THE USER'S SOLE RISK AND WITHOUT LIABILITY OR LEGAL EXPOSURE TO THE ENGINEER, ARCHITECT OR SURVEYOR.

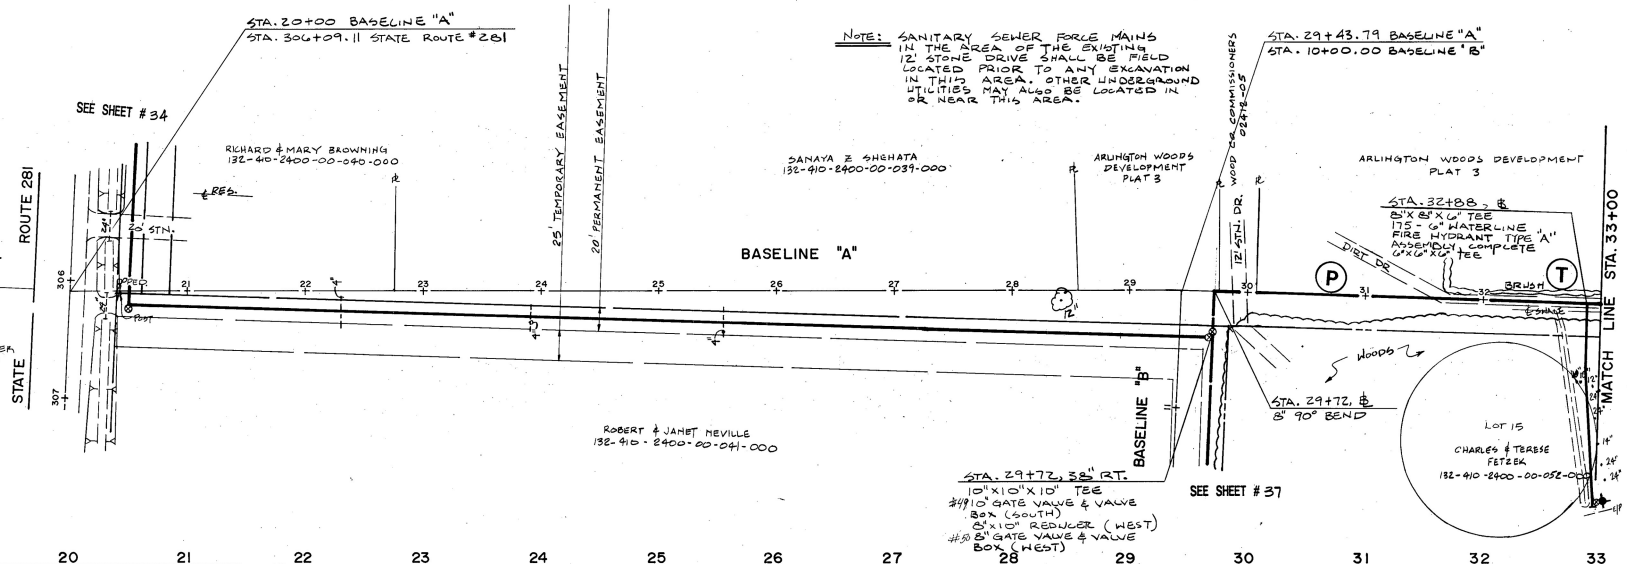

WATERLINE #318 A-E
WOOD COUNTY, OHIO
POGGEMEYER DESIGN GROUP, INC.
ARCHITECTS + ENGINEERS + PLANNERS

37/42

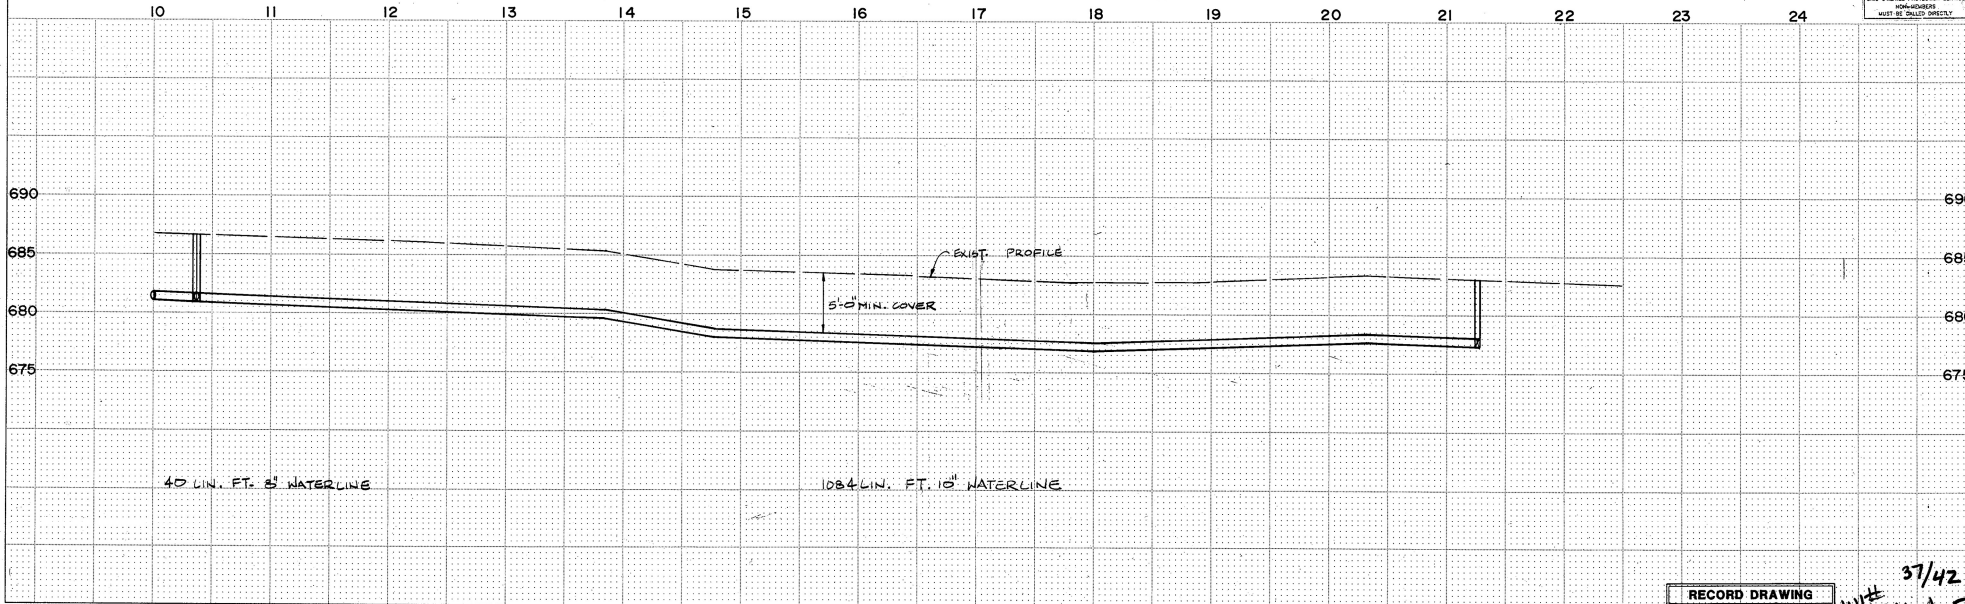
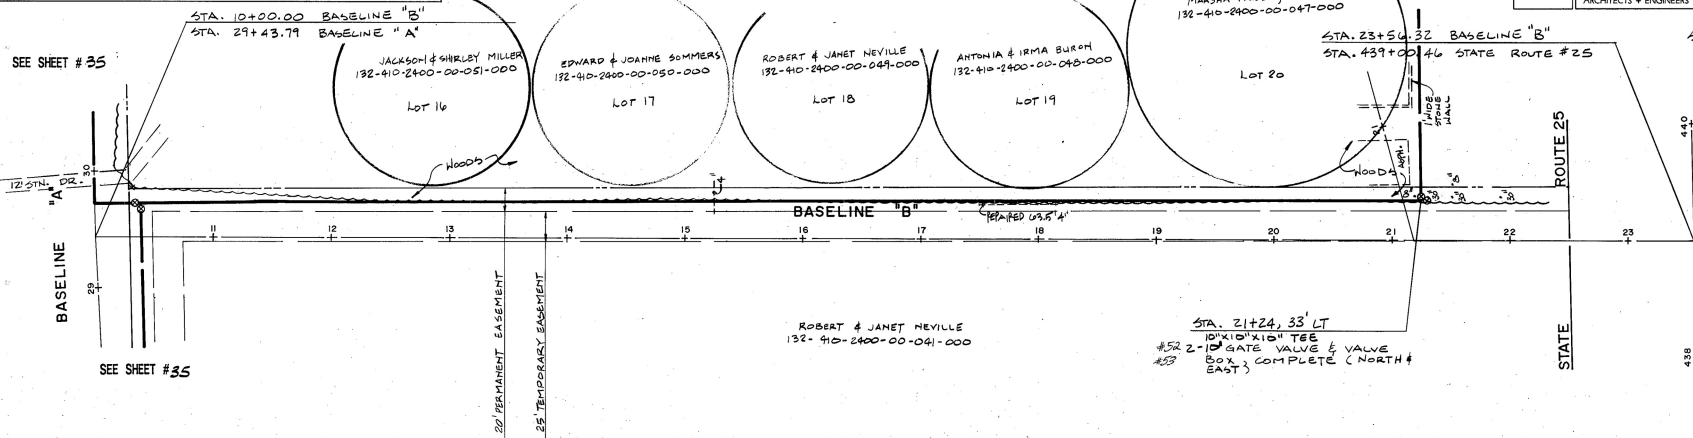


PLATE 4-SINGLE PLAN AND CROSS SECTION-FULL DOT
PRINTED IN U.S.A.

RECORD DRAWING

BASELINE "B" STA10-00 TO STA24-00

37/42
W/ 310 A-E
3130-052