



# McInroe Consulting

## gmcinroe@mcinroeconsulting.com

### Example Interactive Document Set

# SHEET INDEX

## ARCHITECTURAL


G001	COVER SHEET
A001	SITE PLAN
A002	ACCESSIBILITY SITE PLAN
A003	DETAILS
D101	DEMOLITION PLAN BUILDING A AN B
D102	DEMOLITION PLAN BUILDING C AN D
D103	DEMOLITION PLAN BUILDING E AN F
D104	DEMOLITION PLAN BUILDING G
A101	FLOOR PLAN BUILDING BUILDING A AN B
A102	FLOOR PLAN BUILDING BUILDING C AN D
A103	FLOOR PLAN BUILDING BUILDING E AN F
A104	FLOOR PLAN BUILDING BUILDING G
A201	REFLECTED CEILING PLAN BUILDING A AND B
A202	REFLECTED CEILING PLAN BUILDING C AND D
A203	REFLECTED CEILING PLAN BUILDING E AND F
A204	REFLECTED CEILING PLAN BUILDING G
A301	EXTERIOR ELEVATION BUILDING A AND C
A401	EXTERIOR ELEVATION BUILDING B AND D
A402	EXTERIOR ELEVATION BUILDING B AND D
A403	EXTERIOR ELEVATION BUILDING E
A404	EXTERIOR ELEVATION BUILDING F
A405	EXTERIOR ELEVATION BUILDING F
A406	EXTERIOR ELEVATION BUILDING F
A407	EXTERIOR ELEVATION BUILDING F
A408	EXTERIOR ELEVATION BUILDING F
A501	BUILDING SECTION - BUILDING A, B, C, AND D
A502	BUILDING SECTION - BUILDING E AND F
A503	BUILDING SECTION - BUILDING G
A611	TYPICAL CLASSROOM ENLARGED PLAN AND INT. ELEVATIONS
A612	KINDERGARTEN ENLARGED PLAN AND INT. ELEVATIONS
A613	COMPUTER LAB ENLARGED PLAN AND INT. ELEVATIONS
A621	BUILDING A&B RESTROOMS ENLARGED PLAN&INT ELEVATIONS.

For Example:  
Click on Sheet  
A103 Floor Plan  
Building E and F


Note: All Plans would be linked to Index this example, is just using A103.






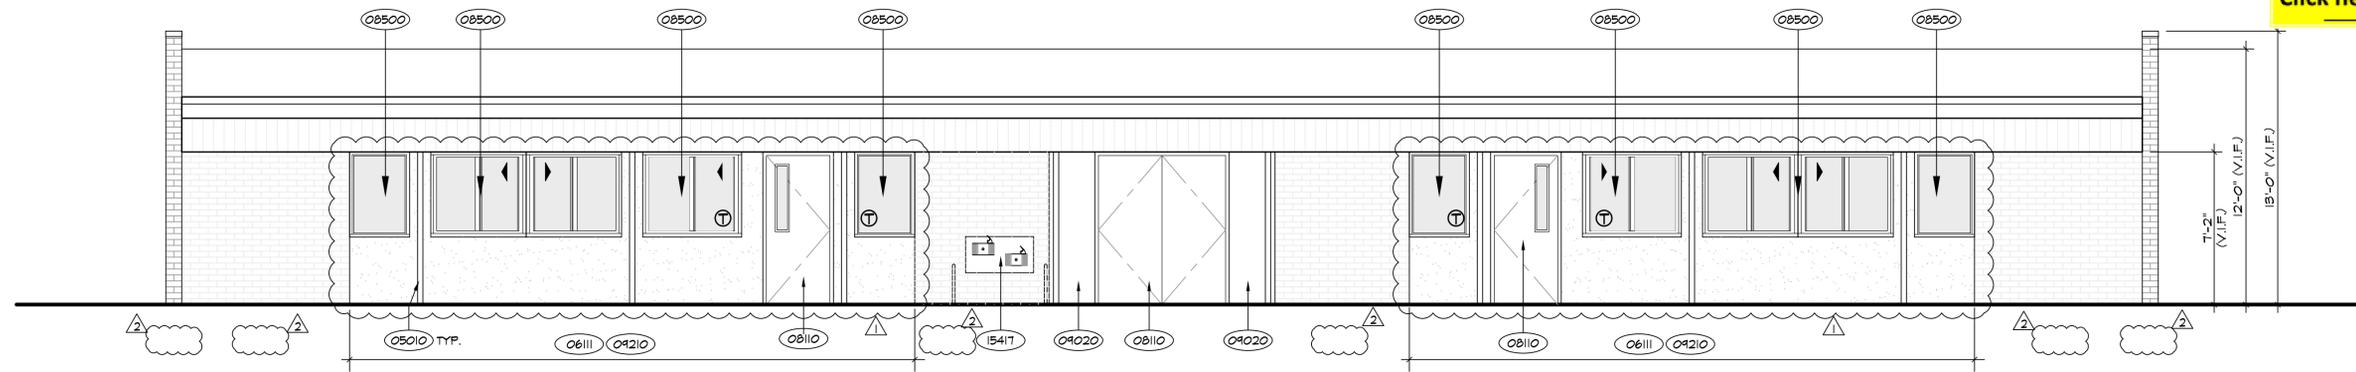


BUILDING "E" - SOUTH ELEVATION ①  
1/4"=1'-0"

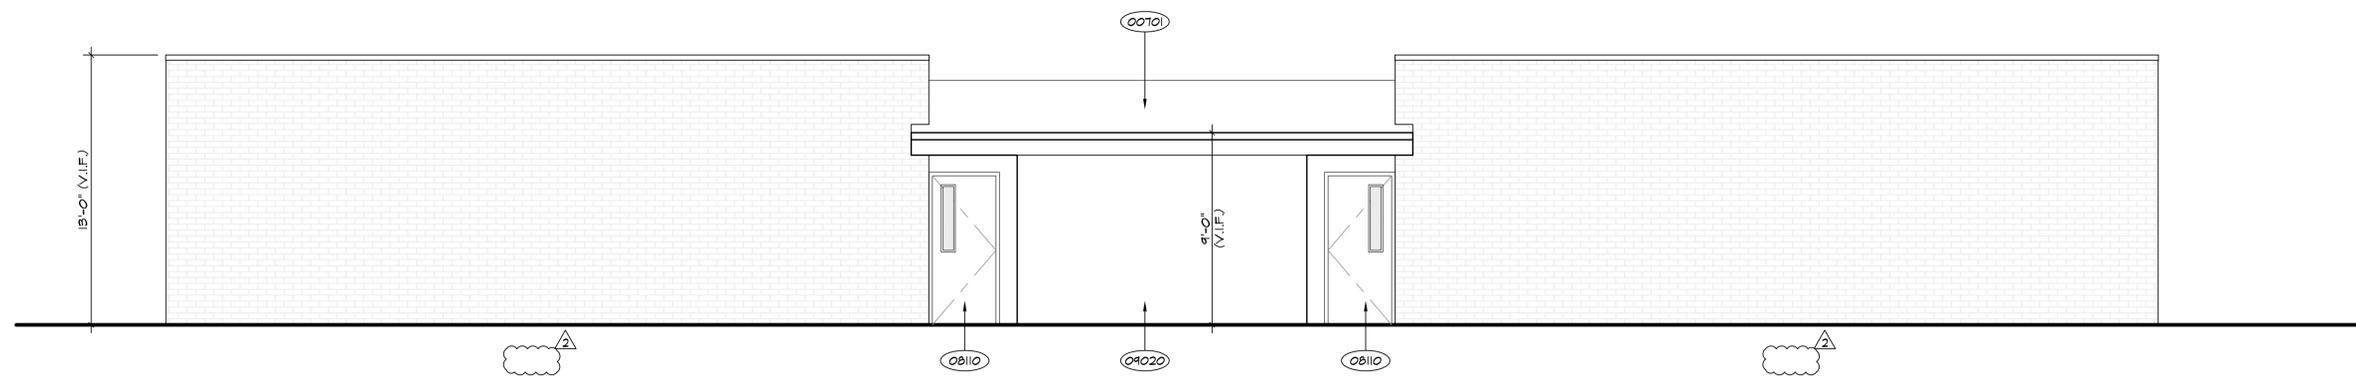

BUILDING "E" - NORTH ELEVATION ②  
1/4"=1'-0"

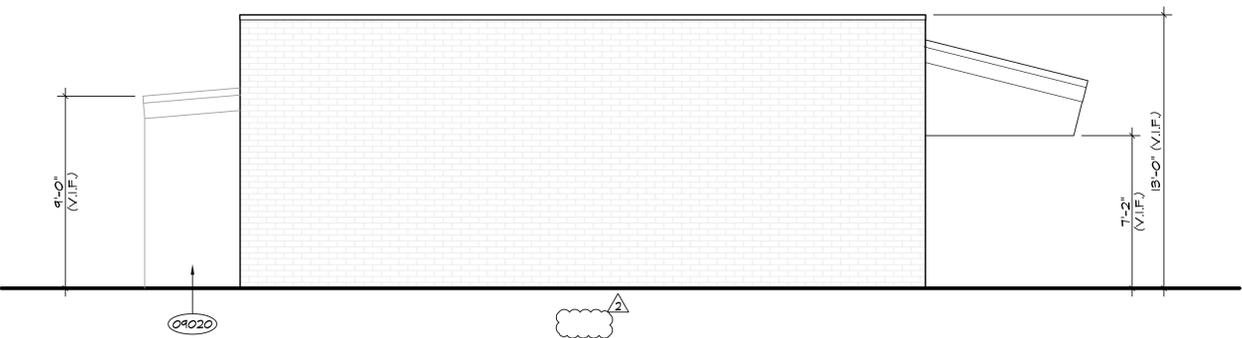

BUILDING "E" - EAST ELEVATION ③  
1/4"=1'-0"

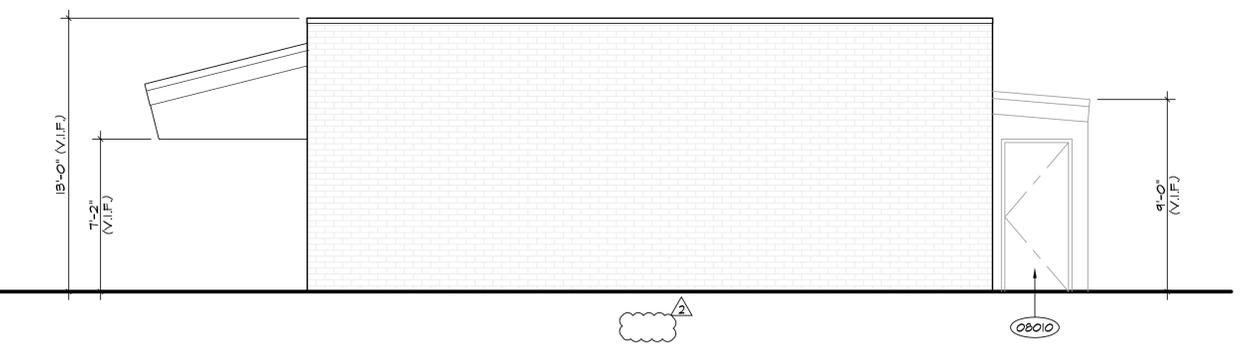

BUILDING "E" - WEST ELEVATION ④  
1/4"=1'-0"

**KEYNOTES**

- 00701 EXISTING ROOFING TO REMAIN
- 04010 CLEAN EXISTING BRICK MASONRY WALL. PATCH AND REPAIR AS NECESSARY
- 05010 EXISTING STEEL COLUMN
- 06111 REMOVE EXISTING NON-BEARING WOOD STUD WALL/WINDOW SYSTEM AND REPLACE WITH NEW WOOD STUD WALL FRAMINGS. SEE DETAIL 5/A852
- 08010 EXISTING DOOR AND FRAME TO REMAIN
- 08110 DOOR PER DOOR SCHEDULE
- 08500 WINDOW PER WINDOW SCHEDULE
- 04020 EXISTING PLASTER TO REMAIN - PATCH AND REPAIR WHERE OPENED/REMOVED FOR NEW WORK
- 04210 NEW PLASTER FINISH, SEE 11, 12/A851 & 17, 19/A861
- 15417 ACCESSIBLE "HI-LOW" DRINKING FOUNTAIN IN NON-ALCOVE WING WALL PER 5&8/A811. PATCH AND REPAIR ANY DAMAGE TO ADJACENT FINISHES FROM DEMOLITION.

NOTE:  
"WHEREVER CONDUITS ARE EXPOSED ON THE OUTSIDE OF BUILDINGS A NEW FRAMED STUCCO ENCLOSURE SHALL BE BUILT TO CONCEAL THE CONDUITS"

**GENERAL NOTES**

1. WHEREVER ANY SURFACE IS DAMAGED BY NEW WORK OR DEMOLITION, THE SURFACE SHALL BE REPAIRED TO MATCH EXISTING SURFACE MATERIAL AND CONDITIONS.
2. IN ADDITION TO NEW PAINTED SURFACES, ALL EXISTING PAINTED SURFACES SHALL BE REPAIRED/PATCHED, CLEANED, PREPARED AND REPAINTED. SEE SPEC SECTION 09900 FOR PAINTING EXECUTION.
3. WHERE MASONRY REQUIRES REPAIRING, PATCH HOLES OR VOIDS WITH COLORED CONCRETE TO MATCH EXISTING BRICK. PROVIDE IN-PLACE MOCK-UP FOR ARCHITECT'S APPROVAL.
4. REPAIR EXISTING WINDOWS, DOORS, FRAMES, LOUVERS AND TRIMS AS NECESSARY PRIOR TO PAINTING.
5. REPAIR EXISTING PLASTER TO MATCH ADJACENT EXISTING SURFACE PRIOR TO PAINTING.
6. NO EXTERIOR WORK AT PORTABLES.
7. REPAIR AND REFINISH AS NECESSARY ALL EXPOSED INTERIOR AND EXTERIOR FINISHES TO MATCH ADJACENT SIMILAR FINISHES. SEE GENERAL NOTES ON SHEET A701 FOR ADDITIONAL INFORMATION.



KEY MAP



SHEET TITLE:  
**BUILDING E  
EXTERIOR ELEVATIONS**  
SHEET NO.:

A405


OF:

KEYNOTES


- 00701 EXISTING ROOFING TO REMAIN
- 05010 EXISTING STEEL COLUMN
- 06111 REMOVE EXISTING NON-BEARING WOOD STUD WALL/WINDOW SYSTEM AND REPLACE WITH NEW WOOD STUD WALL FRAMING. SEE DETAIL 8/A832
- 08110 DOOR PER DOOR SCHEDULE
- 08502 EXISTING WINDOW TO REMAIN
- 09020 EXISTING PLASTER TO REMAIN - PATCH AND REPAIR WHERE OPENED/REMOVED FOR NEW WORK
- 09210 NEW PLASTER FINISH, SEE II, 12/A851 & 17, 19/A861

GENERAL NOTES


1. WHEREVER ANY SURFACE IS DAMAGED BY NEW WORK OR DEMOLITION, THE SURFACE SHALL BE REPAIRED TO MATCH EXISTING SURFACE MATERIAL AND CONDITIONS.
2. IN ADDITION TO NEW PAINTED SURFACES, ALL EXISTING PAINTED SURFACES SHALL BE REPAIRED/PATCHED, CLEANED, PREPARED AND REPAINTED. SEE SPEC SECTION 0900 FOR PAINTING EXECUTION.
3. WHERE MASONRY REQUIRES REPAIRING, PATCH HOLES OR VOIDS WITH COLORED CONCRETE TO MATCH EXISTING BRICK. PROVIDE IN-PLACE MOCK-UP FOR ARCHITECT'S APPROVAL.
4. REPAIR EXISTING WINDOWS, DOORS, FRAMES, LOUVERS AND TRIMS AS NECESSARY PRIOR TO PAINTING.
5. REPAIR EXISTING PLASTER TO MATCH ADJACENT EXISTING SURFACE PRIOR TO PAINTING.
6. NO EXTERIOR WORK AT PORTABLES.
7. REPAIR AND REFINISH AS NECESSARY ALL EXPOSED INTERIOR / EXTERIOR FINISHES TO MATCH ADJACENT SIMILAR FINISHES. SEE GENERAL NOTES ON SHEET A701 FOR ADDITIONAL INFORMATION

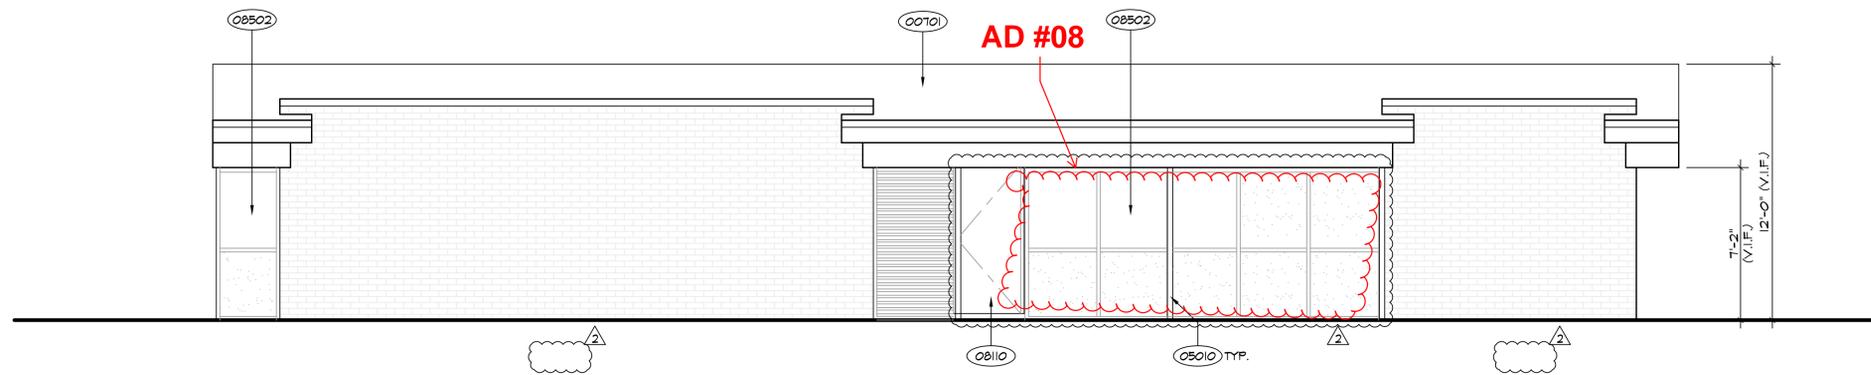

BUILDING "F" - EAST ELEVATION ①  
1/4"=1'-0"

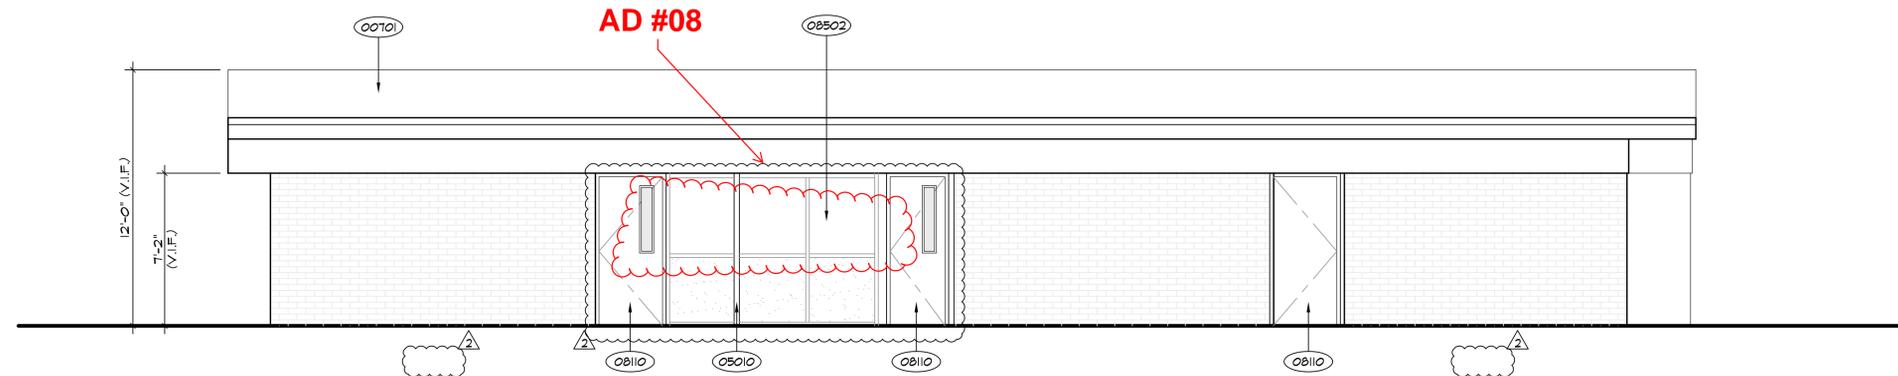


BUILDING "F" - WEST ELEVATION ②  
1/4"=1'-0"

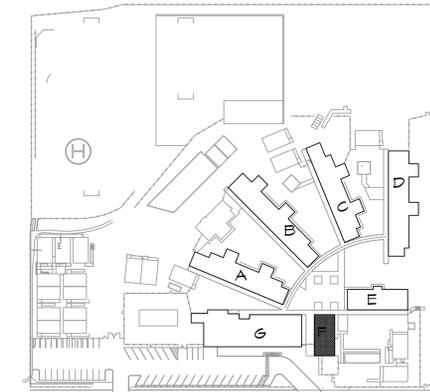


ELM AVENUE

KEY MAP

N.T.S.

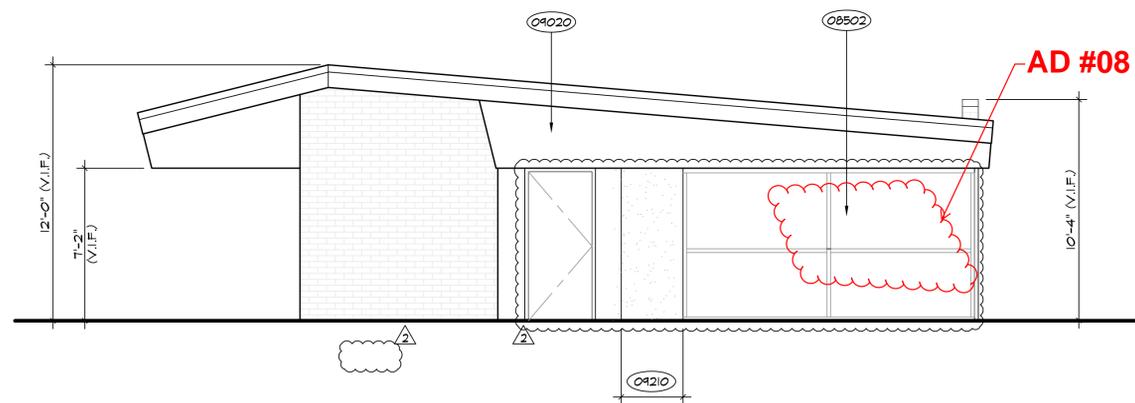

BUILDING "F" - SOUTH ELEVATION ③  
1/4"=1'-0"

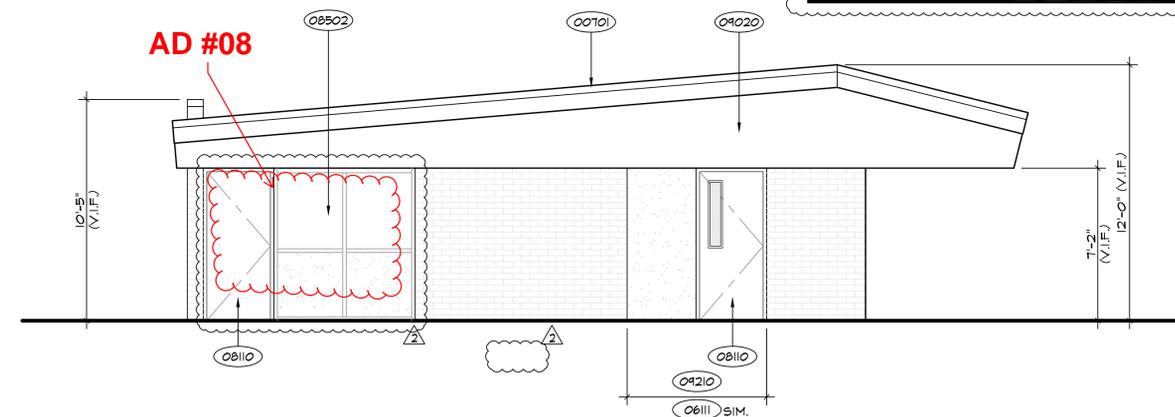

BUILDING "F" - NORTH ELEVATION ④  
1/4"=1'-0"

NOTE:  
"WHEREVER CONDUITS ARE EXPOSED ON THE OUTSIDE OF BUILDINGS A NEW FRAMED STUCCO ENCLOSURE SHALL BE BUILT TO CONCEAL THE CONDUITS"

SHEET TITLE:


BUILDING F EXTERIOR ELEVATIONS

SHEET NO.


A406

OF:




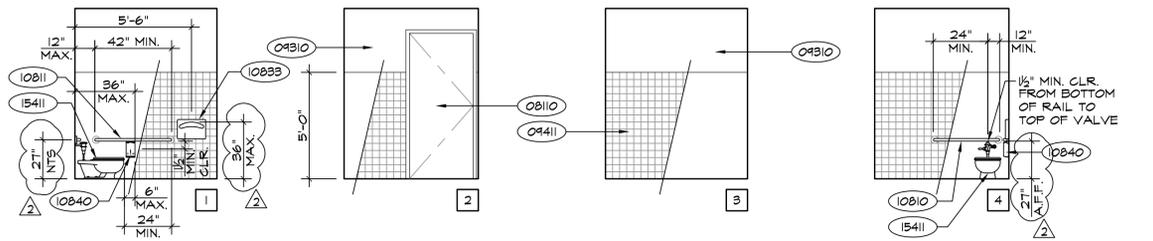

TOILET INTERIOR ELEVATIONS (A)  
1/4"=1'-0"

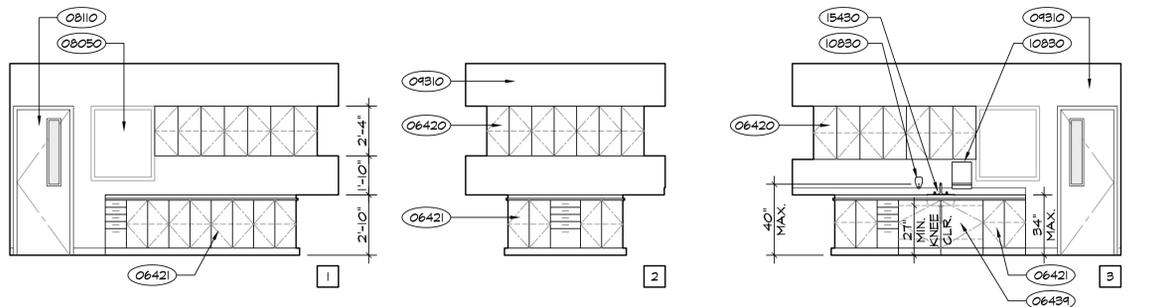

TEACHER ROOM - INTERIOR ELEVATIONS (B)  
1/4"=1'-0"

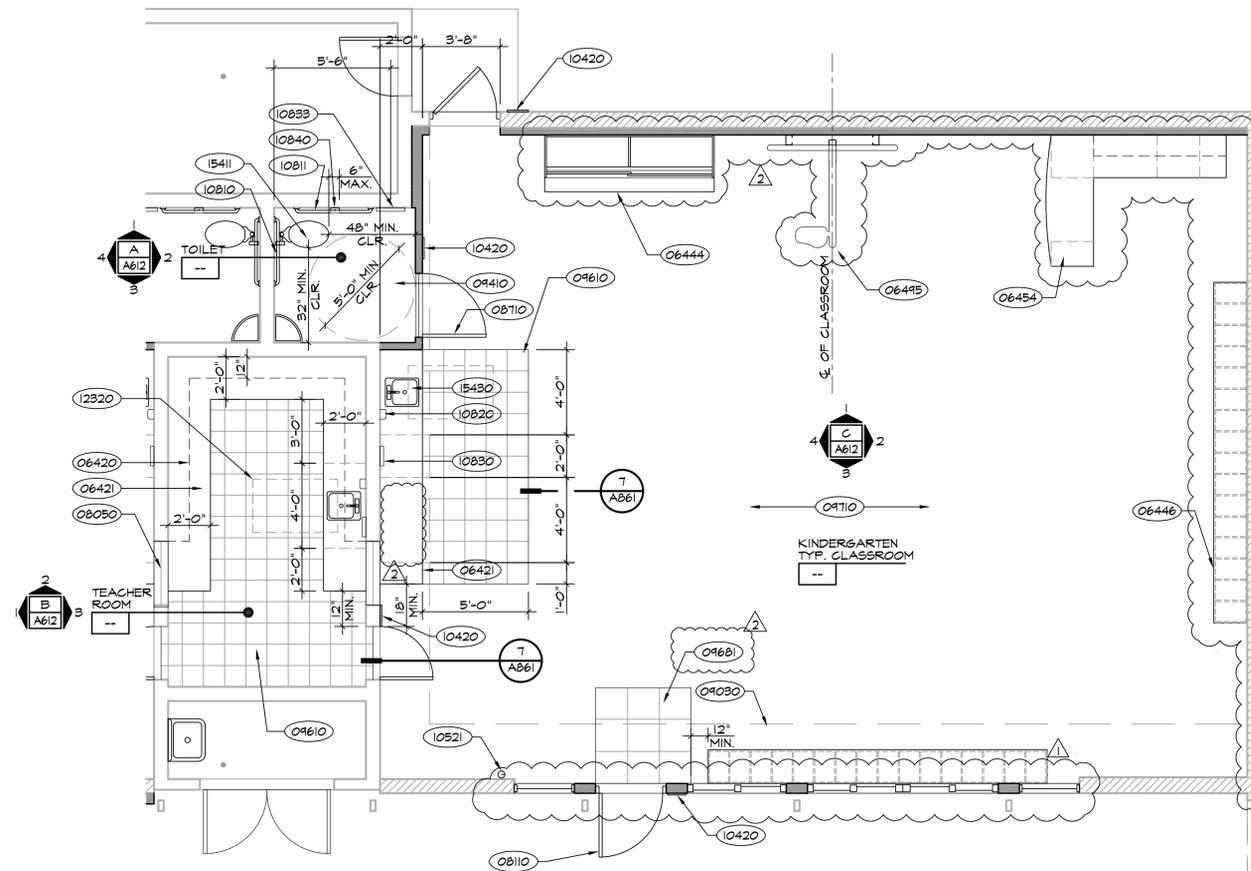

BUILDING E KINDERGARTEN CLASSROOM,  
TEACHER ROOM, AND TOILET - ENLARGED PLAN  
1/4"=1'-0"

GENERAL NOTES


KEYNOTES

- IN ADDITION TO KEYNOTED ITEMS, ALL EXISTING PAINTED SURFACES THAT ARE TO REMAIN EXPOSED ARE TO BE REPAIRED, PREPARED AND PAINTED.
- WHEREVER ANY SURFACE IS DAMAGED BY NEW WORK OR DEMOLITION, THE SURFACE SHALL BE REPAIRED AS NECESSARY TO MATCH EXISTING SURFACE MATERIAL AND CONDITIONS.
- WHERE EXISTING CONCRETE SLAB IS DAMAGED OR HAS BEEN DAMAGED DUE TO DEMOLITION WORK WHETHER INTENTIONALLY OR UNINTENTIONALLY, REPAIR AS NECESSARY TO FORM AN EVEN UNDERLAYMENT FOR NEW FLOOR FINISH.
- ACCESSORIES AT SINK FURNISHED BY SCHOOL DISTRICT AND INSTALLED BY CONTRACTOR.
- CLEAN EXISTING BRICK WALLS & REGROUT AS NECESSARY.
- CONTRACTOR IS RESPONSIBLE FOR FIELD VERIFYING ALL CABINET DIMENSIONS.
- FLOOR FINISH TO BE INSTALLED WALL TO WALL, UNDER ALL CASEWORK AND FIXTURES, UNO.
- FOR TYPICAL DIMENSIONS AND MOUNTING HEIGHTS OF ACCESSIBLE FIXTURES, ACCESSORIES AND TYPICAL ACCESSIBILITY REQUIREMENTS SEE SHEET A011.
- FOR TYPICAL RESTROOM TILE PATTERN SEE SHEET A701.
- AT TOILET ROOM, PROVIDE IN-PLACE MOCK-UP OF TYPICAL WALL PREPARATION AND FINISHES FOR ARCHITECT'S APPROVAL PRIOR TO CONTINUING WORK ON REMAINING TOILET ROOMS. INCLUDE SKIM COAT, LIGHT ORANGE PEEL FINISH AND PAINT.


- 06420 WALL CABINET PER 6/A060
- 06421 BASE CABINET WITH PLASTIC LAMINATE COUNTERTOP PER 2/A060
- 06439 CABINET DOORS WITH ATTACHED TOE-KICK PER 2/A061
- 06444 TEACHING WALL UNIT PER 20/A060
- 06446 BOOK CASE/ CUBICLES PER DETAIL 1/A060
- 06454 TEACHER DESK PER 20/A061
- 06495 INTERACTIVE WHITEBOARD W/ PROJECTOR (NIC) (PROVIDE 80" MIN. HEAD CLEARANCE A.F.F.)
- 08050 EXISTING WINDOW TO REMAIN REPAINT FRAME
- 08110 DOOR PER DOOR SCHEDULE
- 08500 WINDOW PER WINDOW SCHEDULE
- 08710 PROVIDE 90 DEGREE DOOR SWING LIMITER
- 09030 EXISTING GYPSUM BOARD SOFFIT TO REMAIN. PATCH AND REPAIR PRIOR TO PAINTING
- 09310 SKIM COAT ENTIRE WALL PRIOR TO PAINTING.
- 09410 TERRAZZO TILE
- 09411 4x4 CERAMIC TILE AT WALL WAINSCOTE
- 09410 VCT PER FINISH SCHEDULE
- 09681 18"x18" GEO TILE WALK-OFF MATT AT ENTRY
- 09710 NEW CARPET PER FINISH SCHEDULE
- 09791 WALL BASE PER FINISH SCHEDULE
- 09960 TACKABLE VINYL WALL PANEL FINISH PER 10/A061 (WRAP ALL EXPOSED SIDES/EDGES WITH FABRIC).
- 10420 ROOM SIGNAGE PER DETAIL 17/A010 (A & D FULLSIDE AND B PUSHIDE)
- 10521 SURFACE MOUNTED FIRE EXTINGUISHER W/ 4" MAX. PROJECTION TO HANDLE
- 10810 36" STAINLESS STEEL GRAB BAR PER 2, 6, 11 & 14/A011
- 10811 42" STAINLESS STEEL GRAB BAR PER 2, 6, 11 & 14/A011
- 10820 SURFACE MOUNTED SOAP DISPENSER (BY CONTRACTOR)
- 10830 SURFACE MOUNTED PAPER TOWEL DISPENSER (BY CONTRACTOR) 4" MAX PROJECTION
- 10833 SURFACE MOUNTED SEAT COVER DISPENSER (BY CONTRACTOR)
- 10840 SURFACE MOUNTED TOILET TISSUE DISPENSER (BI-FOLD), BOBRICK B-212
- 12320 30"x48" ACCESSIBLE CLEAR SPACE
- 15411 ACCESSIBLE TOILET FIXTURE PER PLUMBING PLANS
- 15430 ACCESSIBLE SINK (5" MAX. DEPTH) - SEE PLUMBING PLANS

CABINETRY NOTES

- REFER TO INTERIOR ELEVATIONS FOR CABINET LOCATION. VERIFY EXACT WIDTH AND LOCATION IN FIELD.
- MILLWORK SUPPLIER SHALL ISSUE A M.I.C. CERTIFIED COMPLIANCE CERTIFICATE WITH SHOP DRAWINGS, AND STAMPED ON EACH UNIT
- SEE DETAIL 15/A060 FOR TYPICAL CABINET ANCHORAGE.
- ALL NEW CABINETS TO BE PLASTIC LAMINATE.
- ALL TEACHER'S TO RECEIVE (B) LOCKS AND ARE TO BE KEYPED TO MATCH THE ROOM ENTRY DOOR.

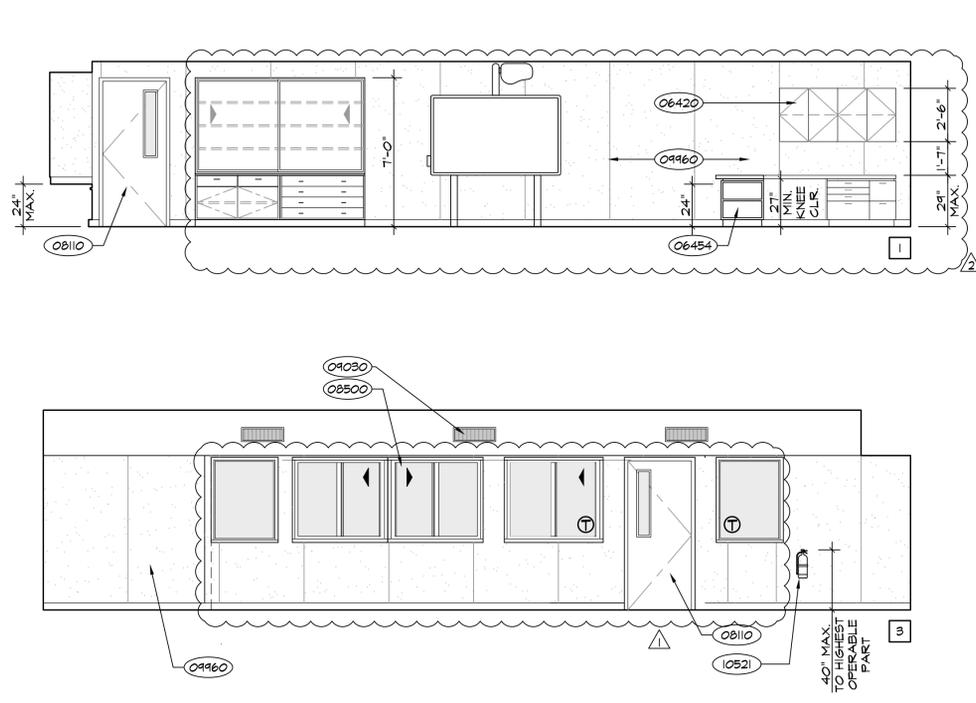

KINDERGARTEN CLASSROOM INTERIOR ELEVATIONS (C)  
1/4"=1'-0"

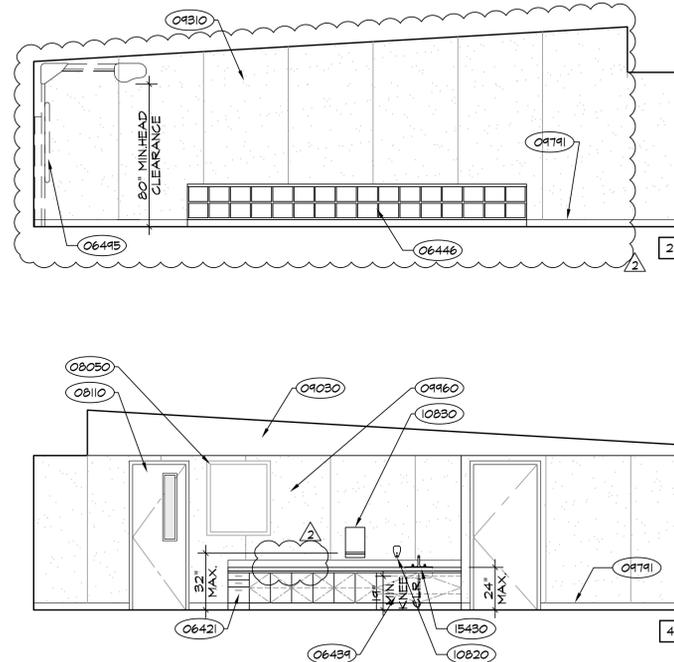


SHEET TITLE:

BUILDING E  
KINDERGARTEN -  
ENLARGED PLAN AND  
INTERIOR ELEVATIONS


SHEET NO.

A612


OF:

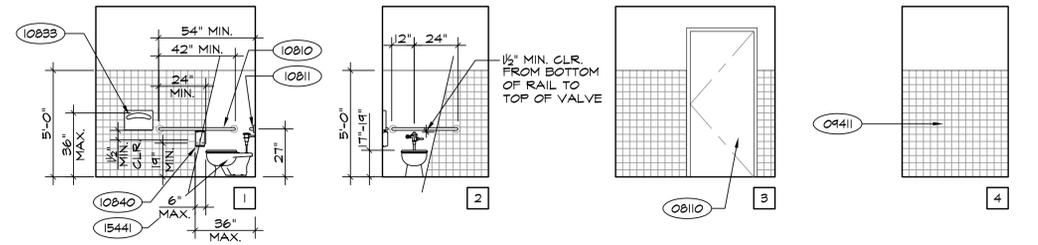


**STUDENT TOILET #F10 INTERIOR ELEVATIONS** 1/4"=1'-0" (A)

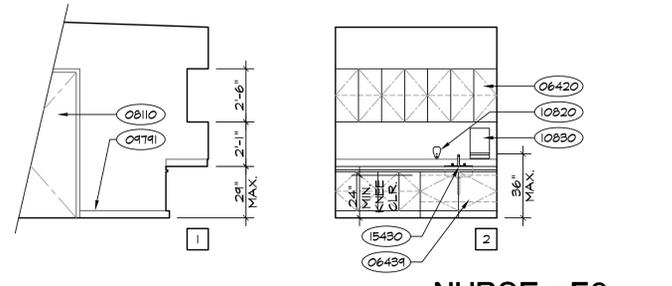

**NURSE #F9 INTERIOR ELEVATIONS** 1/4"=1'-0" (B)

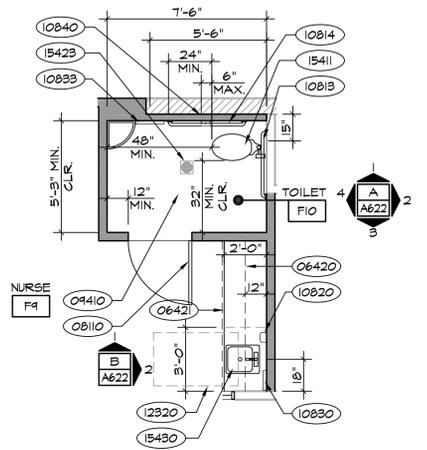

**STUDENT TOILET #F10 ENLARGED PLAN** 1/4"=1'-0" (1)

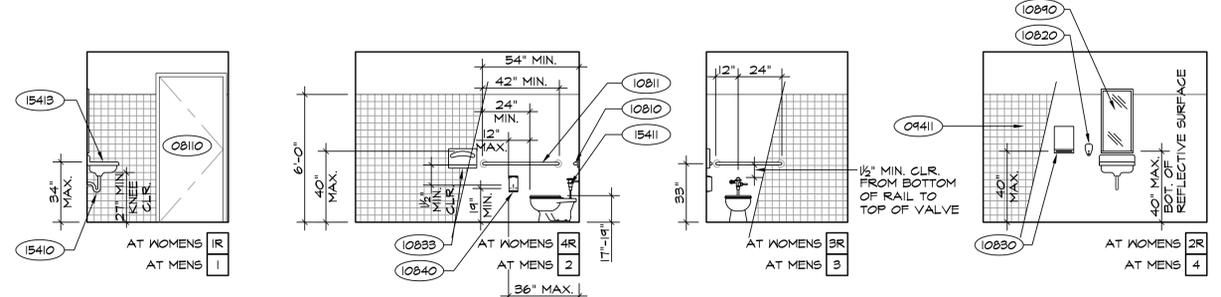


**STAFF #3 (F2 SIM. REVERSE) INTERIOR ELEVATIONS** 1/4"=1'-0" (C)

NOTE: SEE ACCESSIBILITY MOUNTING HEIGHTS TABLE AT 12/A811 FOR MOUNTING HEIGHTS


NOTE: ALL DIMENSIONS ARE TO FACE OF FINISHES (U.N.O.). SEE SHEET A811 FOR ADDITIONAL MOUNTING HEIGHTS REQUIREMENTS

**KEYNOTES**

- 06420 WALL CABINET PER 6/A860
- 06421 BASE CABINET WITH PLASTIC LAMINATE COUNTERTOP PER 2/A860
- 06439 CABINET DOORS WITH ATTACHED TOE-KICK PER 2/A861
- 08110 DOOR PER DOOR SCHEDULE
- 09410 TERRAZZO TILE
- 09411 4x4 CERAMIC TILE AT WALL MAINSCOTE
- 09791 WALL BASE PER FINISH SCHEDULE
- 10420 ROOM SIGNAGE PER DETAIL 17/A810 (A & D FULLSIDE AND B PUSHIDE)
- 10810 36" STAINLESS STEEL GRAB BAR PER 2, 6, 11 & 14/A811
- 10811 42" STAINLESS STEEL GRAB BAR PER 2, 6, 11 & 14/A811
- 10813 36" STAINLESS STEEL GRAB BAR PER 2 AND 6/A811
- 10814 42" STAINLESS STEEL GRAB BAR PER 2 AND 6/A811
- 10820 SURFACE MOUNTED SOAP DISPENSER (BY CONTRACTOR)
- 10830 SURFACE MOUNTED PAPER TOWEL DISPENSER (BY CONTRACTOR) 4" MAX PROJECTION
- 10833 SURFACE MOUNTED SEAT COVER DISPENSER (BY CONTRACTOR)
- 10840 SURFACE MOUNTED TOILET TISSUE DISPENSER (BI-FOLD), BOBRICK B-272
- 10860 HAILO TRENTO CORNER 23 TRASH CAN - TYP. AT ALL TOILET ROOMS
- 10890 24"x36" PLATE GLASS MIRROR (BY CONTRACTOR)
- 12320 30"x48" ACCESSIBLE CLEAR SPACE
- 12322 48"x48" ACCESSIBLE CLEAR SPACE
- 15410 INSULATED HOT WATER AND DRAIN PIPE
- 15411 ACCESSIBLE TOILET FIXTURE PER PLUMBING PLANS
- 15413 ACCESSIBLE SINK PER PLUMBING PLANS
- 15423 FLOOR DRAIN PER PLUMBING PLANS, SLOPE NEW CONC. FLOOR SLAB TO DRAINS, (2% MAX. ALL DIRECTIONS, OPENINGS IN GRATE 1/2" MAX. BOTH DIRECTIONS).
- 15430 ACCESSIBLE SINK (5" MAX. DEPTH) - SEE PLUMBING PLANS
- 15441 DISABLED ACCESSIBLE WATER CLOSET - SEE PLUMBING PLANS

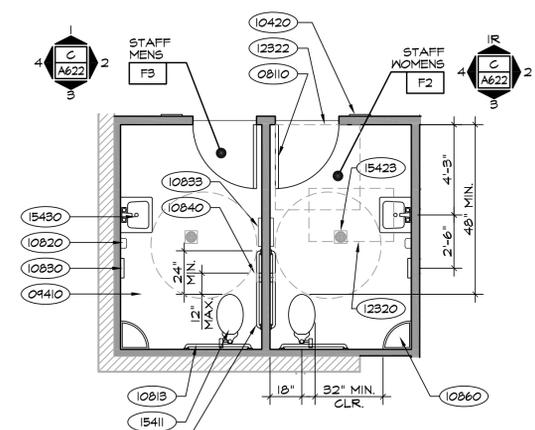

**STAFF #F2 & #F3 ENLARGED PLAN** 1/4"=1'-0" (2)

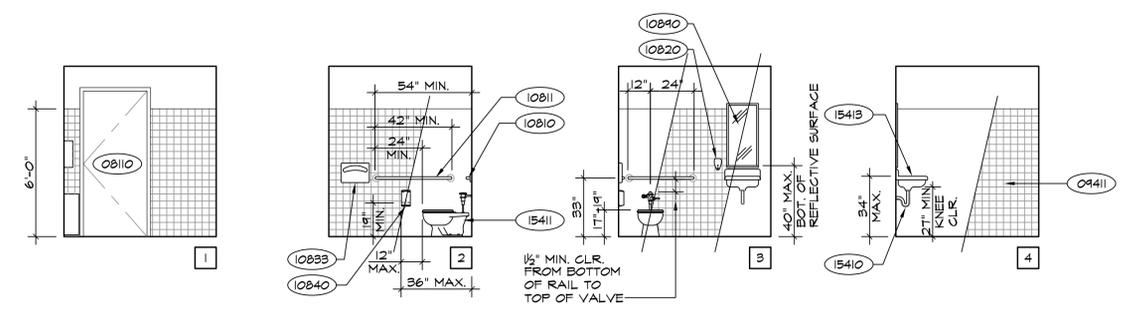


**TOILET #G6 INTERIOR ELEVATIONS** 1/4"=1'-0" (D)

**CABINETRY NOTES**

1. REFER TO INTERIOR ELEVATIONS FOR CABINET LOCATION. VERIFY EXACT WIDTH AND LOCATION IN FIELD.
2. MILLWORK SUPPLIER SHALL ISSUE A W.I.C. CERTIFIED COMPLIANCE CERTIFICATE WITH SHOP DRAWINGS, AND STAMPED ON EACH UNIT
3. SEE DETAIL 18/A860 FOR TYPICAL CABINET ANCHORAGE.
4. ALL NEW CABINETS TO BE PLASTIC LAMINATE.
5. ALL TEACHER'S TO RECEIVE (3) LOCKS AND ARE TO BE KEYPED TO MATCH THE ROOM ENTRY DOOR.

**GENERAL NOTES**

1. IN ADDITION TO KEYNOTED ITEMS, ALL EXISTING PAINTED SURFACES THAT ARE TO REMAIN EXPOSED ARE TO BE REPAIRED, PREPARED AND PAINTED.
2. WHEREVER ANY SURFACE IS DAMAGED BY NEW WORK OR DEMOLITION, THE SURFACE SHALL BE REPAIRED AS NECESSARY TO MATCH EXISTING SURFACE MATERIAL AND CONDITIONS.
3. WHERE EXISTING CONCRETE SLAB IS DAMAGED OR HAS BEEN DAMAGED DUE TO DEMOLITION WORK WHETHER INTENTIONALLY OR UNINTENTIONALLY, REPAIR AS NECESSARY TO FORM AN EVEN UNDERLAYMENT FOR NEW FLOOR FINISH.
4. ACCESSORIES AT SINK FURNISHED BY SCHOOL DISTRICT AND INSTALLED BY CONTRACTOR
5. CLEAN EXISTING BRICK WALLS & REGROUT AS NECESSARY
6. CONTRACTOR IS RESPONSIBLE FOR FIELD VERIFYING ALL CABINET DIMENSIONS.
7. FLOOR FINISH TO BE INSTALLED WALL TO WALL, UNDER ALL CASEWORK AND FIXTURES, U.N.O.
8. FOR TYPICAL DIMENSIONS AND MOUNTING HEIGHTS OF ACCESSIBLE FIXTURES, ACCESSORIES AND TYPICAL ACCESSIBILITY REQUIREMENTS SEE SHEET A811.
9. FOR TYPICAL RESTROOM TILE PATTERN SEE SHEET A701
10. AT TOILET ROOM, PROVIDE IN-PLACE MOCK-UP OF TYPICAL WALL PREPARATION AND FINISHES FOR ARCHITECT'S APPROVAL PRIOR TO CONTINUING WORK ON REMAINING TOILET ROOMS. INCLUDE SKIM COAT, LIGHT ORANGE PEEL FINISH AND PAINT.

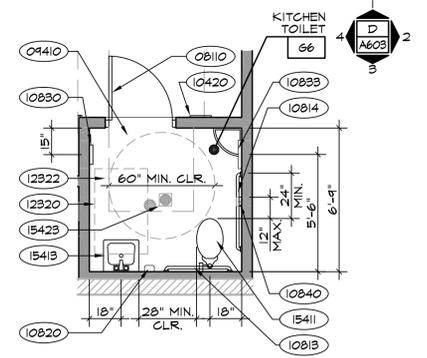


**KITCHEN TOILET #G6 ENLARGED PLAN** 1/4"=1'-0" (3)


SHEET TITLE:  
**BUILDING F ENLARGED PLAN AND INTERIOR ELEVATIONS**  
SHEET NO.:

**A622**


OF:

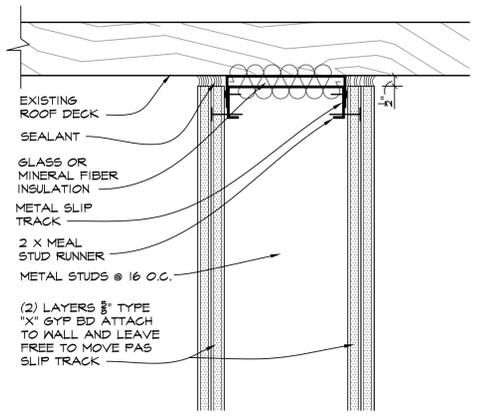


17 UL DESIGN # U411 3" = 1'-0"

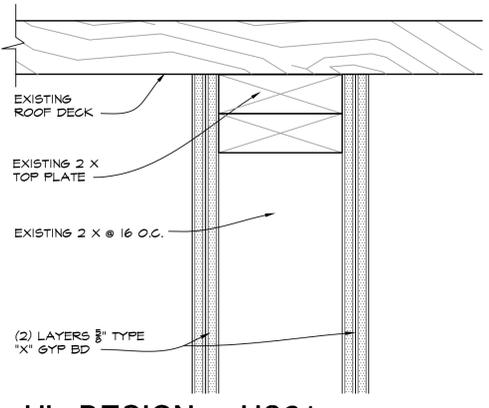


18 UL DESIGN # U301 3" = 1'-0"

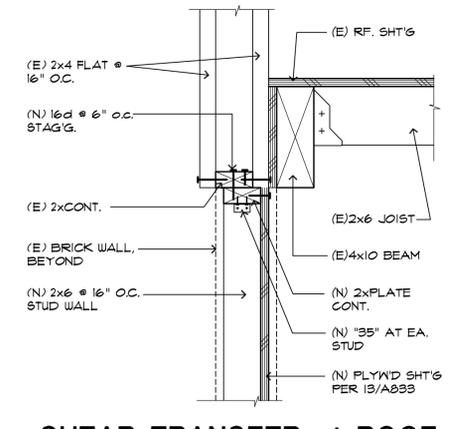


14 SHEAR TRANSFER at ROOF 1 1/2" = 1'-0"

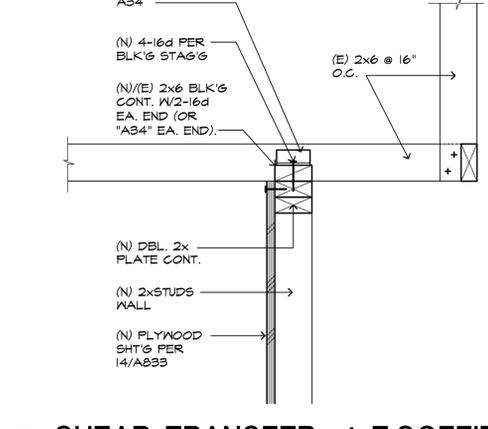

10 SHEAR TRANSFER at E.SOFFIT 1 1/2" = 1'-0"

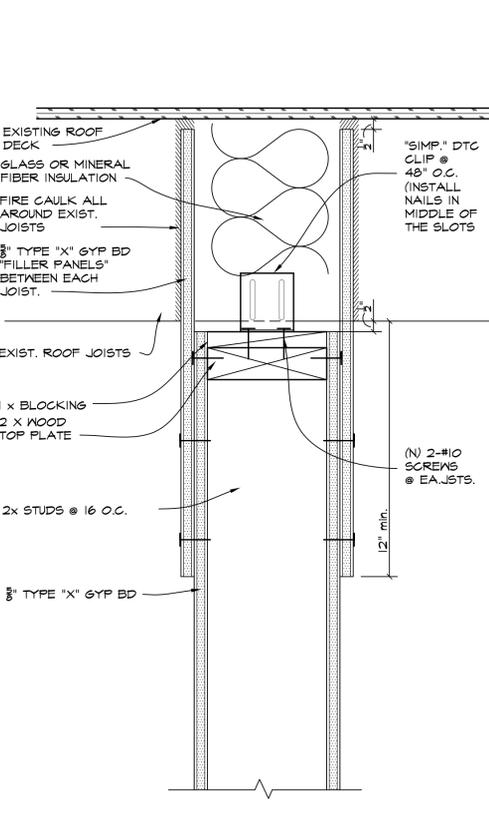


20 WOOD STUDS PARTITIONS under ROOF SHT'G. 3" = 1'-0"

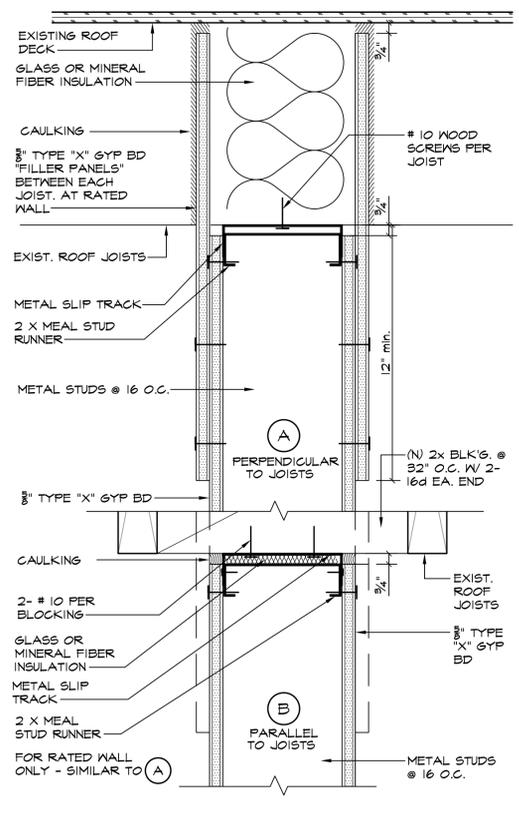


16 METAL STUDS PARTITIONS under ROOF SHT'G. 3" = 1'-0"

Notice how you jump to the exact Detail on the Plan Scroll back and select Index in top Right Corner

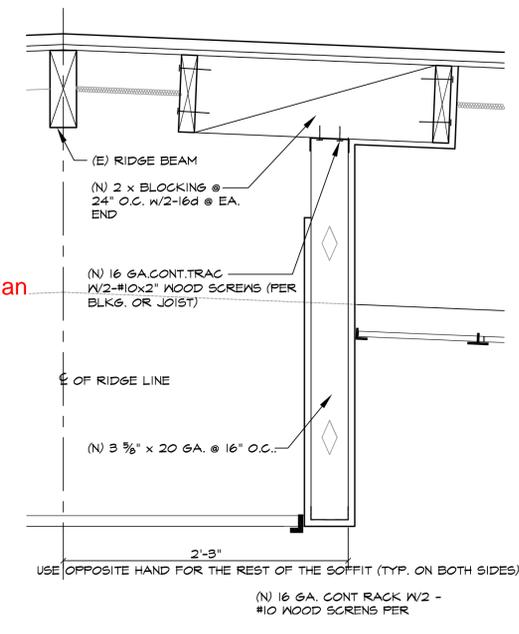


6 MECHANICAL DUCT SOFFIT 1 1/2" = 1'-0"

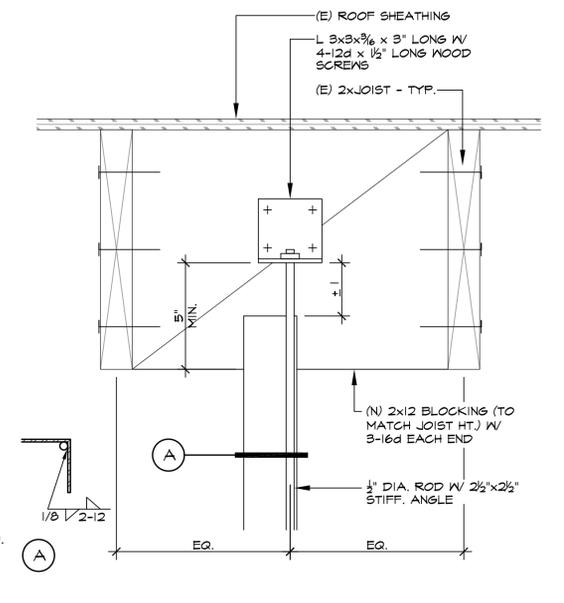


1 HOOD SUPPORT 3" = 1'-0"

Notice how you jump to the exact Detail on the Plan Scroll back and select Index in top Right Corner

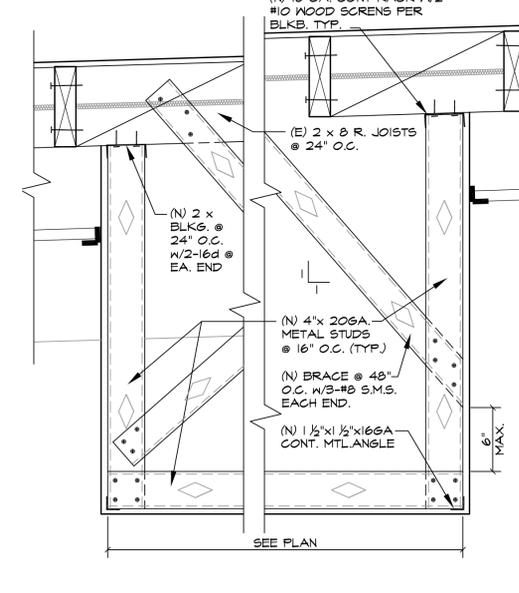

7 SOFFIT FRAMING DETAIL 1 1/2" = 1'-0"

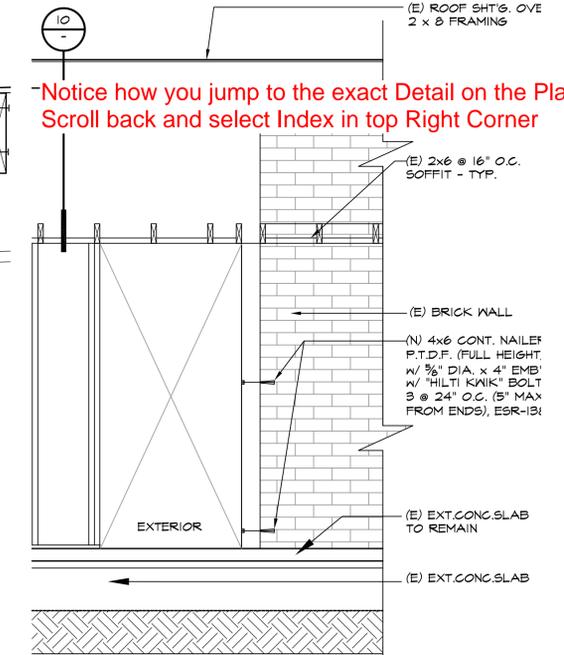


3 NAILER CONNECTION to BLOCK 1/2" = 1'-0"


Notice how you jump to the exact Detail on the Plan ·  
 Scroll back and select Index in top Right Corner

[Click here to return to Index](#)


**Index**

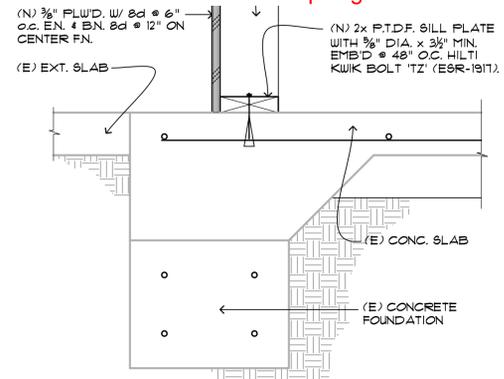


**13 SHEAR PANEL TRANSFER**  
 1 1/2" = 1'-0"

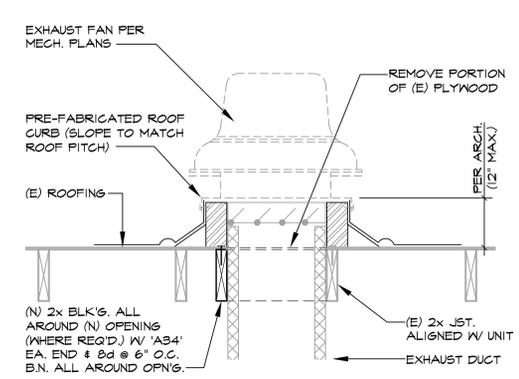


**9 CURB MOUNTED EXHAUST FAN**  
 1" = 1'-0"

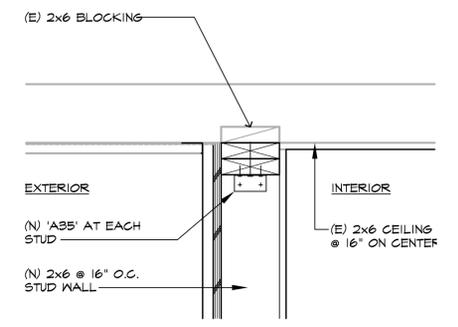


**1 (N) WALL TO (E) CEILING**  
 1 1/2" = 1'-0"

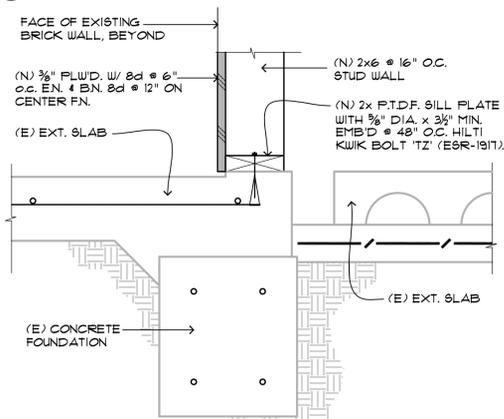


**14 SHEAR PANEL TRANSFER**  
 1 1/2" = 1'-0"

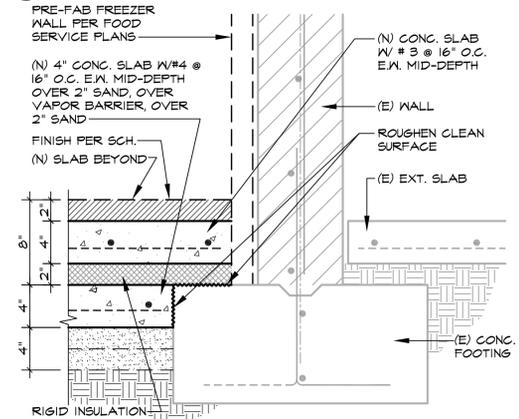


**10 INT. SLAB AT BRICK WALL**  
 1 1/2" = 1'-0"

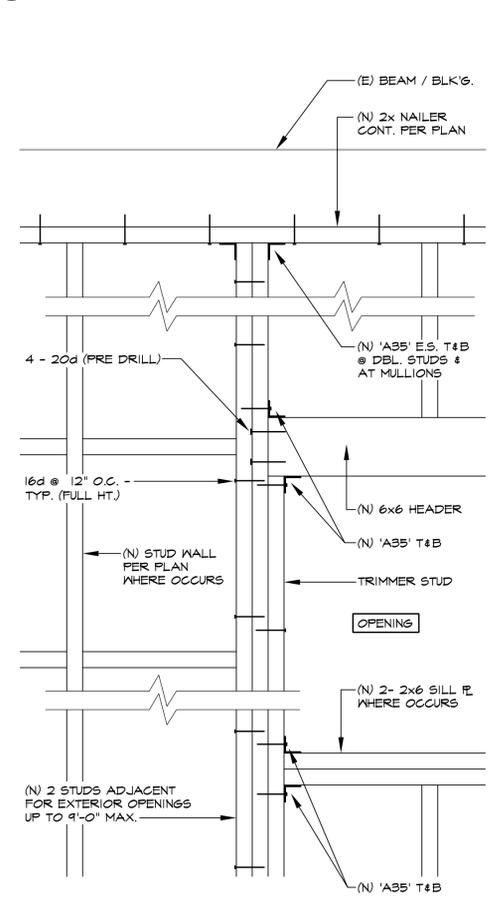


**5 (N) WALL TO (E) BEAM / TYP. LINTEL / HD'R. FRAMING**  
 1 1/2" = 1'-0"

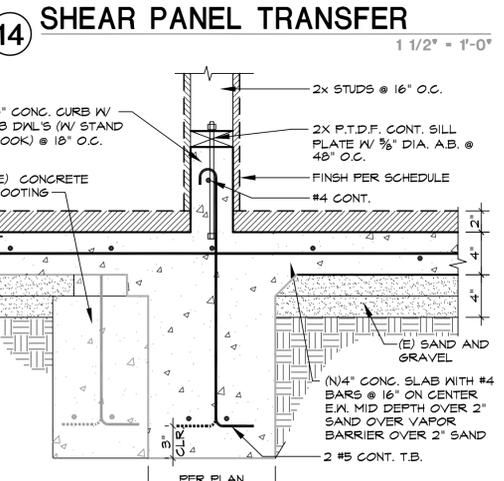


**15 (N) FOOTING AT (E) FOUNDATION**  
 1 1/2" = 1'-0"

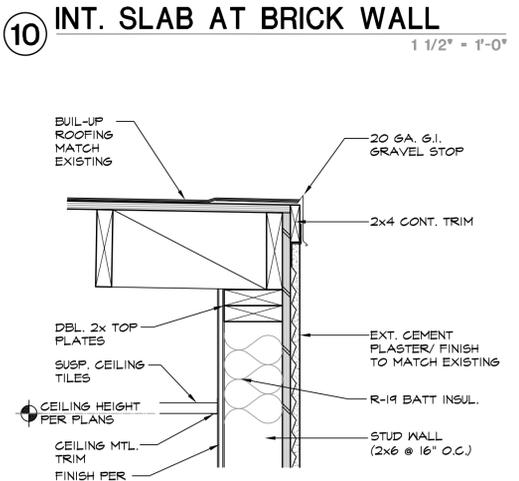


**11 ROOF AT ZERO EAVE**  
 1 1/2" = 1'-0"

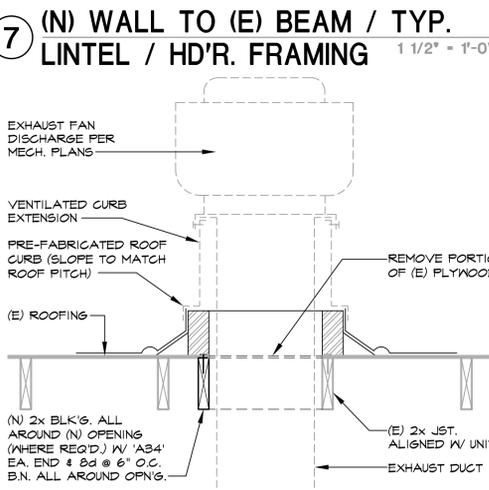


**7 (N) WALL TO (E) BEAM / TYP. LINTEL / HD'R. FRAMING**  
 1 1/2" = 1'-0"

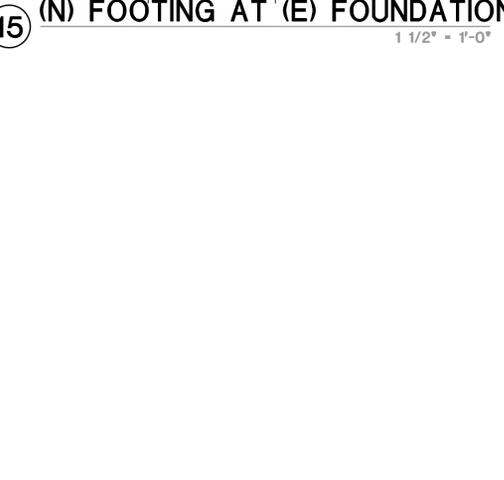

**12 WEEP SCREED**  
 3" = 1'-0"

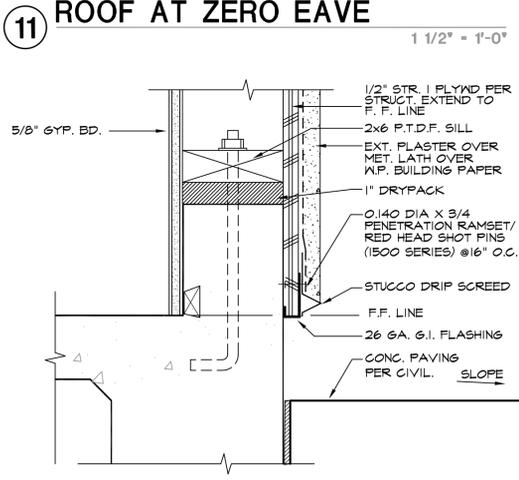

 **8 KITCHEN HOOD EXHAUST FAN MOUNTING**  
 1" = 1'-0"



**2 (N) WALL TO (E) CEILING**  
 1 1/2" = 1'-0"

SHEET TITLE:  
 DETAILS  
 SHEET NO.

**A833**

OF:

APRIL 19, 2013 ISSUED FOR FIN

- d. Revised Building B plans to indicate that the restroom slab will remain in place. Saw cut trenches necessary for plumbing work.
  - e. Clarification that the floor will be ground on the inside at the doors unlike Nicoloff and Pence.
  - f. Revised Key Notes.
  - g. Clarification that the existing lighting is to be removed.
4. Sheet D102, DEMOLITION PLAN BUILDING C AND D
- a. Revised Floor Plan to indicate that the existing window wall will remain except for the door and one section adjacent to door (see Exterior Elevations).
  - b. Revised plans to indicate the removal of duct soffit that is at the common classroom wall.
  - c. Revised plans to indicate that the window in the teacher room will remain.
  - d. Revised Building C plans to indicate that the restroom slab will remain in place. Saw cut trenches necessary for plumbing work.
  - e. Clarification that the floor will be ground on the inside at the doors unlike Nicoloff and Pence.
  - f. Revised Key Notes.
  - g. Clarification that the existing lighting is to be removed.
5. Sheet D103, DEMOLITION PLAN BUILDING E AND F
- a. Revised Floor Plan to indicate that the existing window wall will remain (see Exterior Elevations).
  - b. Clarification that the restroom slabs will be removed in Building E and F.
  - c. Clarification that the floor will be ground on the inside at the doors unlike Nicoloff and Pence.
  - d. Revised that the casework in Building F Work Room shall remain but replace the countertop with new.
  - e. Revised that the casework in Building F Principal shall remain but replace the countertop with new.
  - f. Revised Key Notes.
  - g. Clarification that the existing lighting is to be removed.
  - h. Remove soffit above existing casework in Lounge.
  - i. Remove soffit as necessary to meet finish condition of RCP on sheet A203.
6. Sheet D104, DEMOLITION PLAN BUILDING G
- a. Clarification that the floor will be ground on the inside at the doors unlike Nicoloff and Pence.
  - b. Clarification that the existing lighting will be removed.
7. Sheet A101, FLOOR PLAN BUILDING A AND B
- a. Revised plan for the new configuration of the front classroom window wall and door.
  - b. Revised plan to keep the windows in the Teacher Rooms.
  - c. Clarification that Building A Restrooms were complete in Phase 1.
  - d. Revised plan for the Computer Lab to be relocated in Classroom B10.
  - e. Clarification to add new R-30 insulation in ceiling.
8. Sheet A102, FLOOR PLAN BUILDING C AND D ← **Notice You can Click on page to jump back.**
- a. Revised plan for the new configuration of the front classroom window wall and door.
  - b. Revised plan to keep the windows in the Teacher Rooms.
  - c. Clarification to add new R-30 insulation in ceiling.
9. Sheet A103, FLOOR PLAN BUILDING E AND F
- a. Revised Building E reconfiguration of the Kindergarten plan.
  - b. Eliminated one sink in each Kindergarten room.
  - c. Revised plan for the new configuration of the Administration window wall.
  - d. Revised that the casework in Building F Workroom shall remain, but install new countertops.
  - e. Revised that the casework in Building F Principal shall remain, but relocate and install new countertops. New casework finish shall match existing material finish.
  - f. Added 3 adjustable shelves in Principal's Closet.
  - g. Clarification to add new R-30 insulation in ceiling.

ct

98

### ARCHITECT'S DIRECTIVE

PROJECT: \_\_\_\_\_ NO.: 12

ARCHITECT: \_\_\_\_\_ DATE: 8-16-13

CONTRACTOR: \_\_\_\_\_ PAGE: 1 of 2

• • •

#### DIRECTIVE(S):

Provide new door and doorframe complete at the location shown on the attached sketch SKA-01.

To Contractor by Architect: \_\_\_\_\_ Date: 8-16-13

Cc: \_\_\_\_\_

• • •


Via:  Mail or  Fax - Number of Pages - 1 (Inclusive)  
Original Will/Will Not Follow

NO.	SIZE	DOOR				HDWR GROUP	PANIC HDWR	CLOSURE	DETAILS		SIGNAGE
		TYPE	MATL.	FINISH	GLASS				HEAD	JAMB	PULL SIDE
F7A	3'-0"x7'-0"x1 3/4"	A	WD/SC	SG-2	GL-2	-		NO	7/A850	8/A850	(R)

**DOOR F7A HARDWARE SET**

- (3) 3 EA HINGE 3CBI-4.5x4.6 652 IVE
- (1) 1 EA DBL CYLINDER LOCK ND66PD-RHO-E'KWY 626 SCH
- (1) 1 EA KICK PLATE 8400-10" x 34" 626 IVE
- (1) 1 EA OVERHEAD STOP 904S 630 G-J
- (3) 1 EA SILENCER SR64

(R) DOOR SIGN - "WORKROOM / LOUNGE"  
PER DETAIL 17/A810

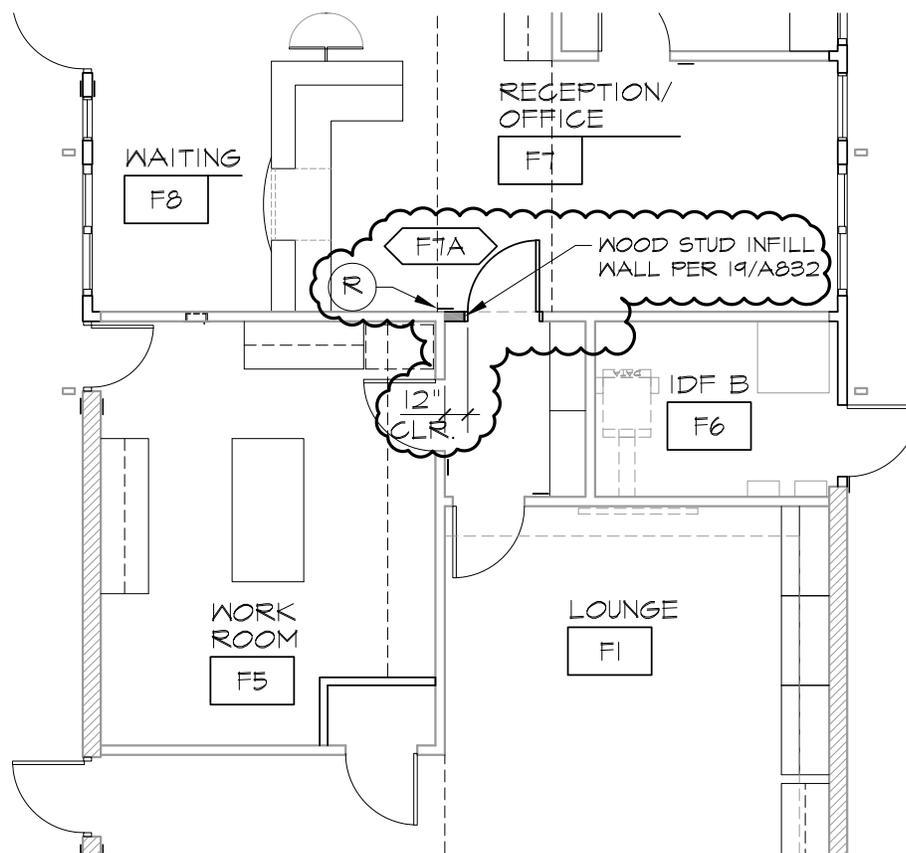

**(N) DOOR F7A**

1/8"=1'-0"

1



Notice You can Click on page to jump back.

SHEET DESCRIPTION:

**A103 - FLOOR PLAN BLDG. F**

SCHOOL  
JO. 12

DISTRICT

PAGE

**SKA-01**

### ARCHITECT'S DIRECTIVE

PROJECT:

NO.: 9

ARCHITECT:

DATE: 6-6-13

CONTRACTOR:

PAGE: 1 of 1

• • •

#### DIRECTIVE(S):

1. Delete in Kindergarten Building E the two (2) outer most windows designated as "E" in K1 and K2 and infill with framed plaster wall to match existing. The windows also designated as "E" adjacent to the entry doors for K1 and K2 are not changed.



To Contractor by Architect:

\_\_\_\_\_

Date: 6-6-13

Cc:

\_\_\_\_\_

• • •

Via:  Mail or  Fax - Number of Pages - 1 (Inclusive)  
 Original Will/Will Not Follow

ARCHITECT'S DIRECTIVE

PROJECT: \_\_\_\_\_ NO.: 8
ARCHITECT: \_\_\_\_\_ DATE: 6-7-13
CONTRACTOR: \_\_\_\_\_ PAGE: 1 of 4

DIRECTIVE(S):

Provide new windows and stucco walls at the Administration Building per the attached sketches. Due to the scheduling constraints, I believe that hollow metal window frames were acceptable in lieu of the specified aluminum windows.


[Handwritten signature]

To Contractor by Architect: \_\_\_\_\_ Date: 6-7-13

Cc: \_\_\_\_\_

• • •

Via: [ ] Mail or [ ] Fax - Number of Pages - 1 (Inclusive)
Original Will/Will Not Follow

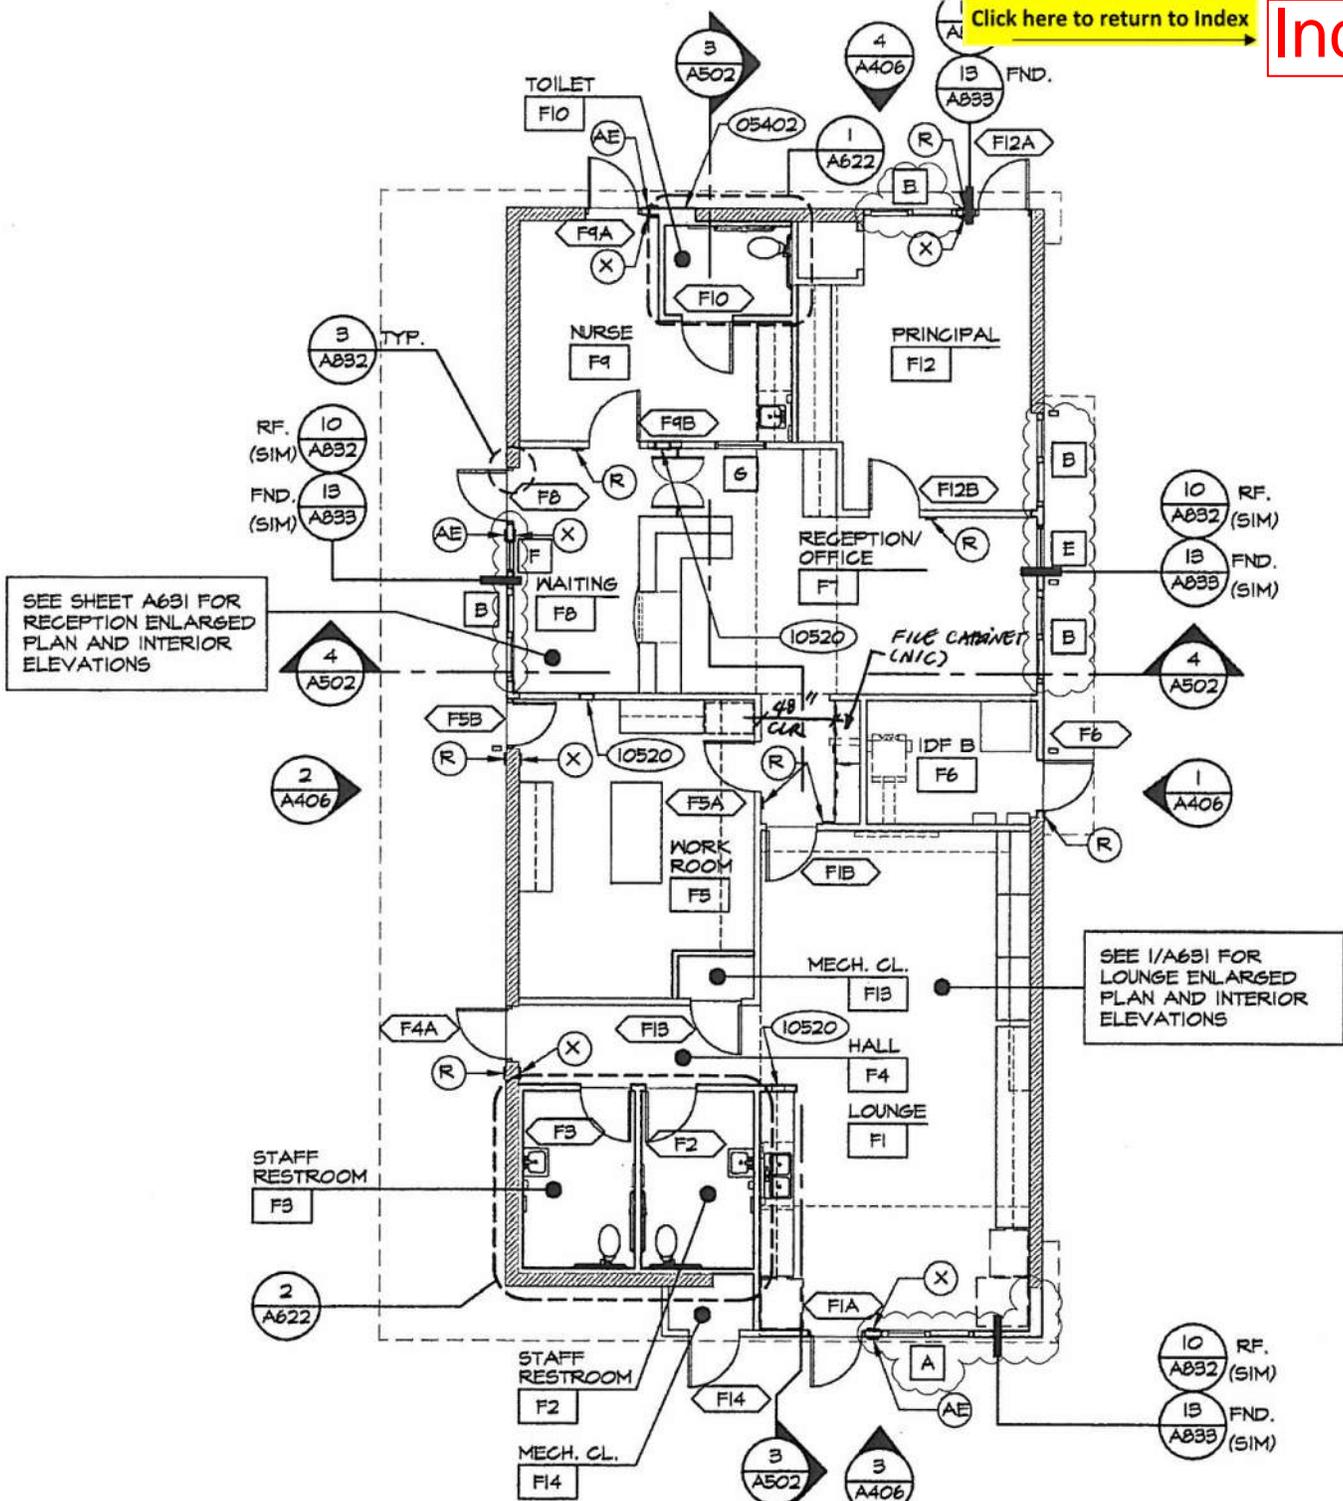

# BLDG. 'F' - FLOOR PLAN

N.T.S.


Notice You can Click on page to jump back.

SHEET DESCRIPTION:  
**A103 - FLOOR PLAN BUILDING F**


HOOL	J. 8
ICT	
AGE	
<b>SK-01</b>	

Click here to return to Index

Index

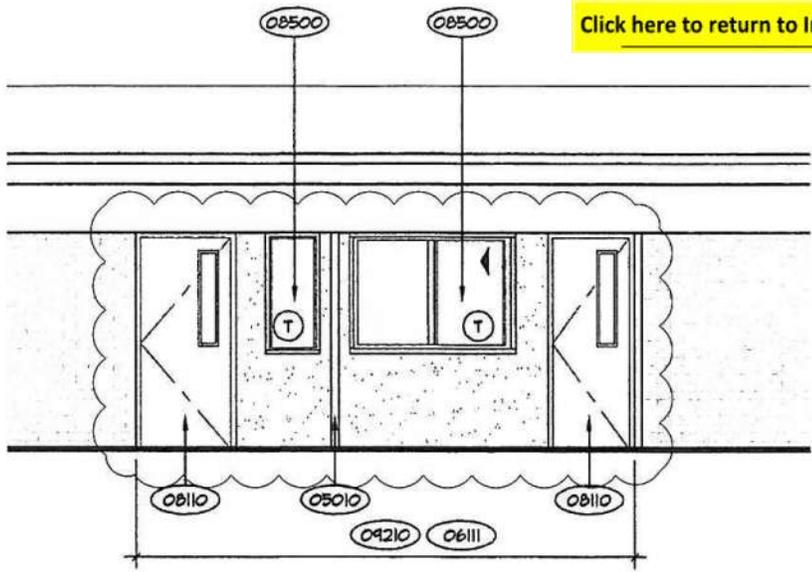

WEST ELEVATION

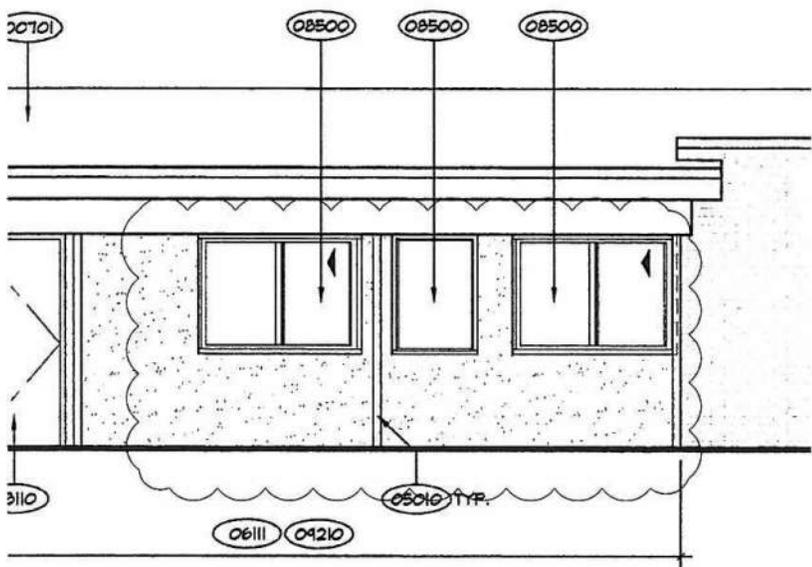

EAST ELEVATION

BLDG. 'F' - EXTERIOR ELEVATIONS

N.T.S.

SHEET DESCRIPTION	
A406 - BUILDING F EXTERIOR ELEVATIONS	
CHOOLO NO. 8	TRICT
PAGE	SK-02



\_\_\_\_\_ 18

### ARCHITECT'S DIRECTIVE

PROJECT: \_\_\_\_\_ NO.: 13

ARCHITECT: \_\_\_\_\_ DATE: 8-16-13

CONTRACTOR: \_\_\_\_\_ PAGE: 1 of 2

• • •

#### DIRECTIVE(S):

Please provide the following in the Administration Area:

1. Relocate an existing upper cabinet as indicated on attached sketch SKA-01.
2. Install new upper cabinet as indicated on attached sketch SKA-01.




To Contractor by Architect: \_\_\_\_\_ Date: 8-16-13

Cc: \_\_\_\_\_

• • •

Via:  Mail or  Fax - Number of Pages - 1 (Inclusive)  
 Original Will/Will Not Follow

Click here to return to Index

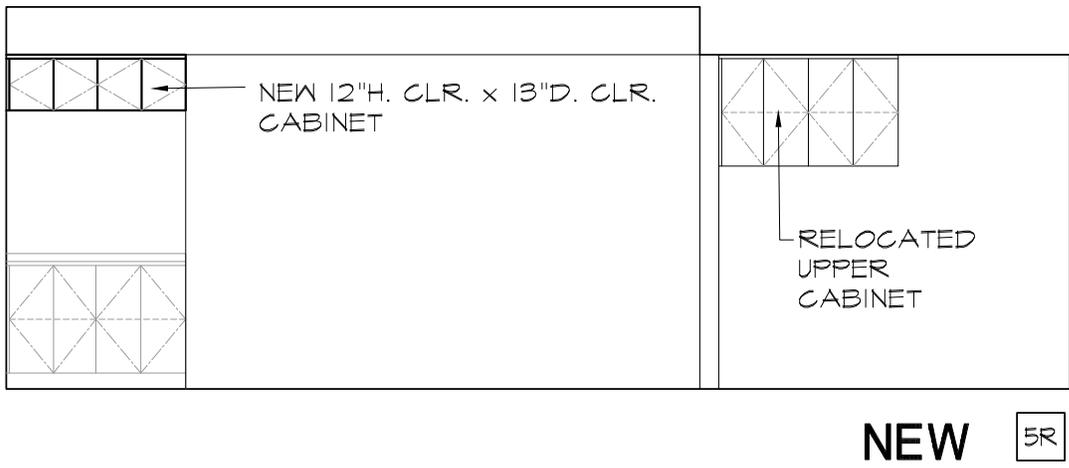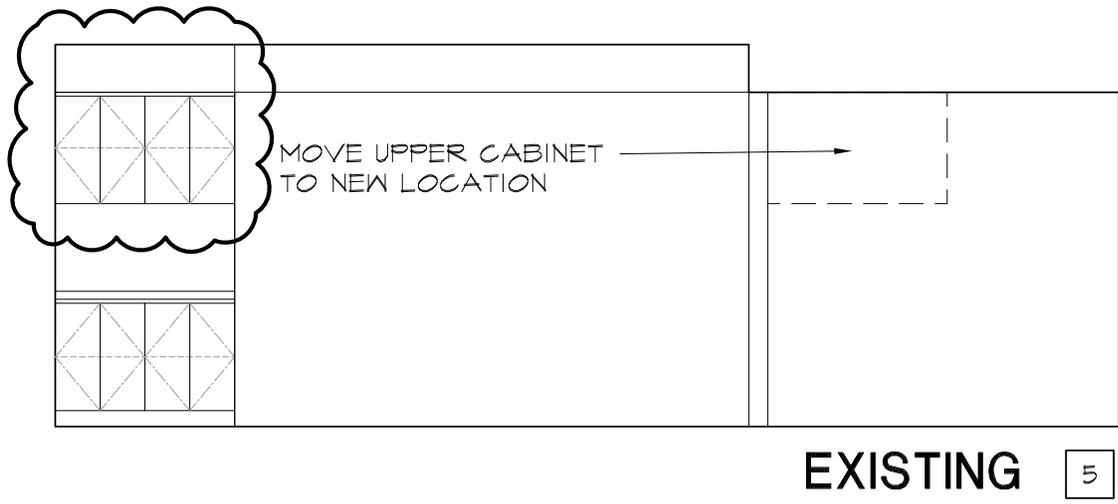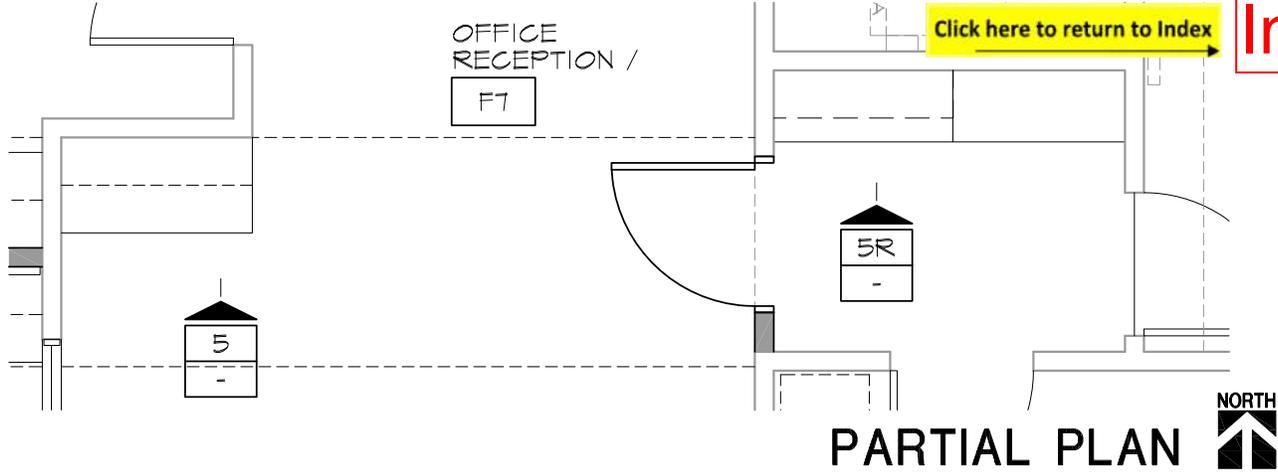

### BLDG. F - RECEPTION OFFICE

1/4"=1'-0"

1

SHEET DESCRIPTION:	
<b>A631 - BLDG. F ADMIN. - CABINET RELOCATION</b>	
SCHOOL	13
DISTRICT	
PAGE	<b>SKA-01</b>

\_\_\_\_\_ t  
3

### ARCHITECT'S DIRECTIVE

PROJECT: \_\_\_\_\_ NO.: 14

ARCHITECT: \_\_\_\_\_ DATE: 8-16-13

CONTRACTOR: \_\_\_\_\_ PAGE: 1 of 2

. . .

#### DIRECTIVE(S):

Please relocate the Fire Remote Annunciator devices from its present location in the Administration Waiting Area to inside the Reception/Office Area on the same wall per attached sketch.


To Contractor by Architect: \_\_\_\_\_ Date: 8-16-13

Cc: \_\_\_\_\_

. . .

Via:  Mail or  Fax - Number of Pages - 1 (Inclusive)  
Original Will/Will Not Follow

# RFI #15 Answer

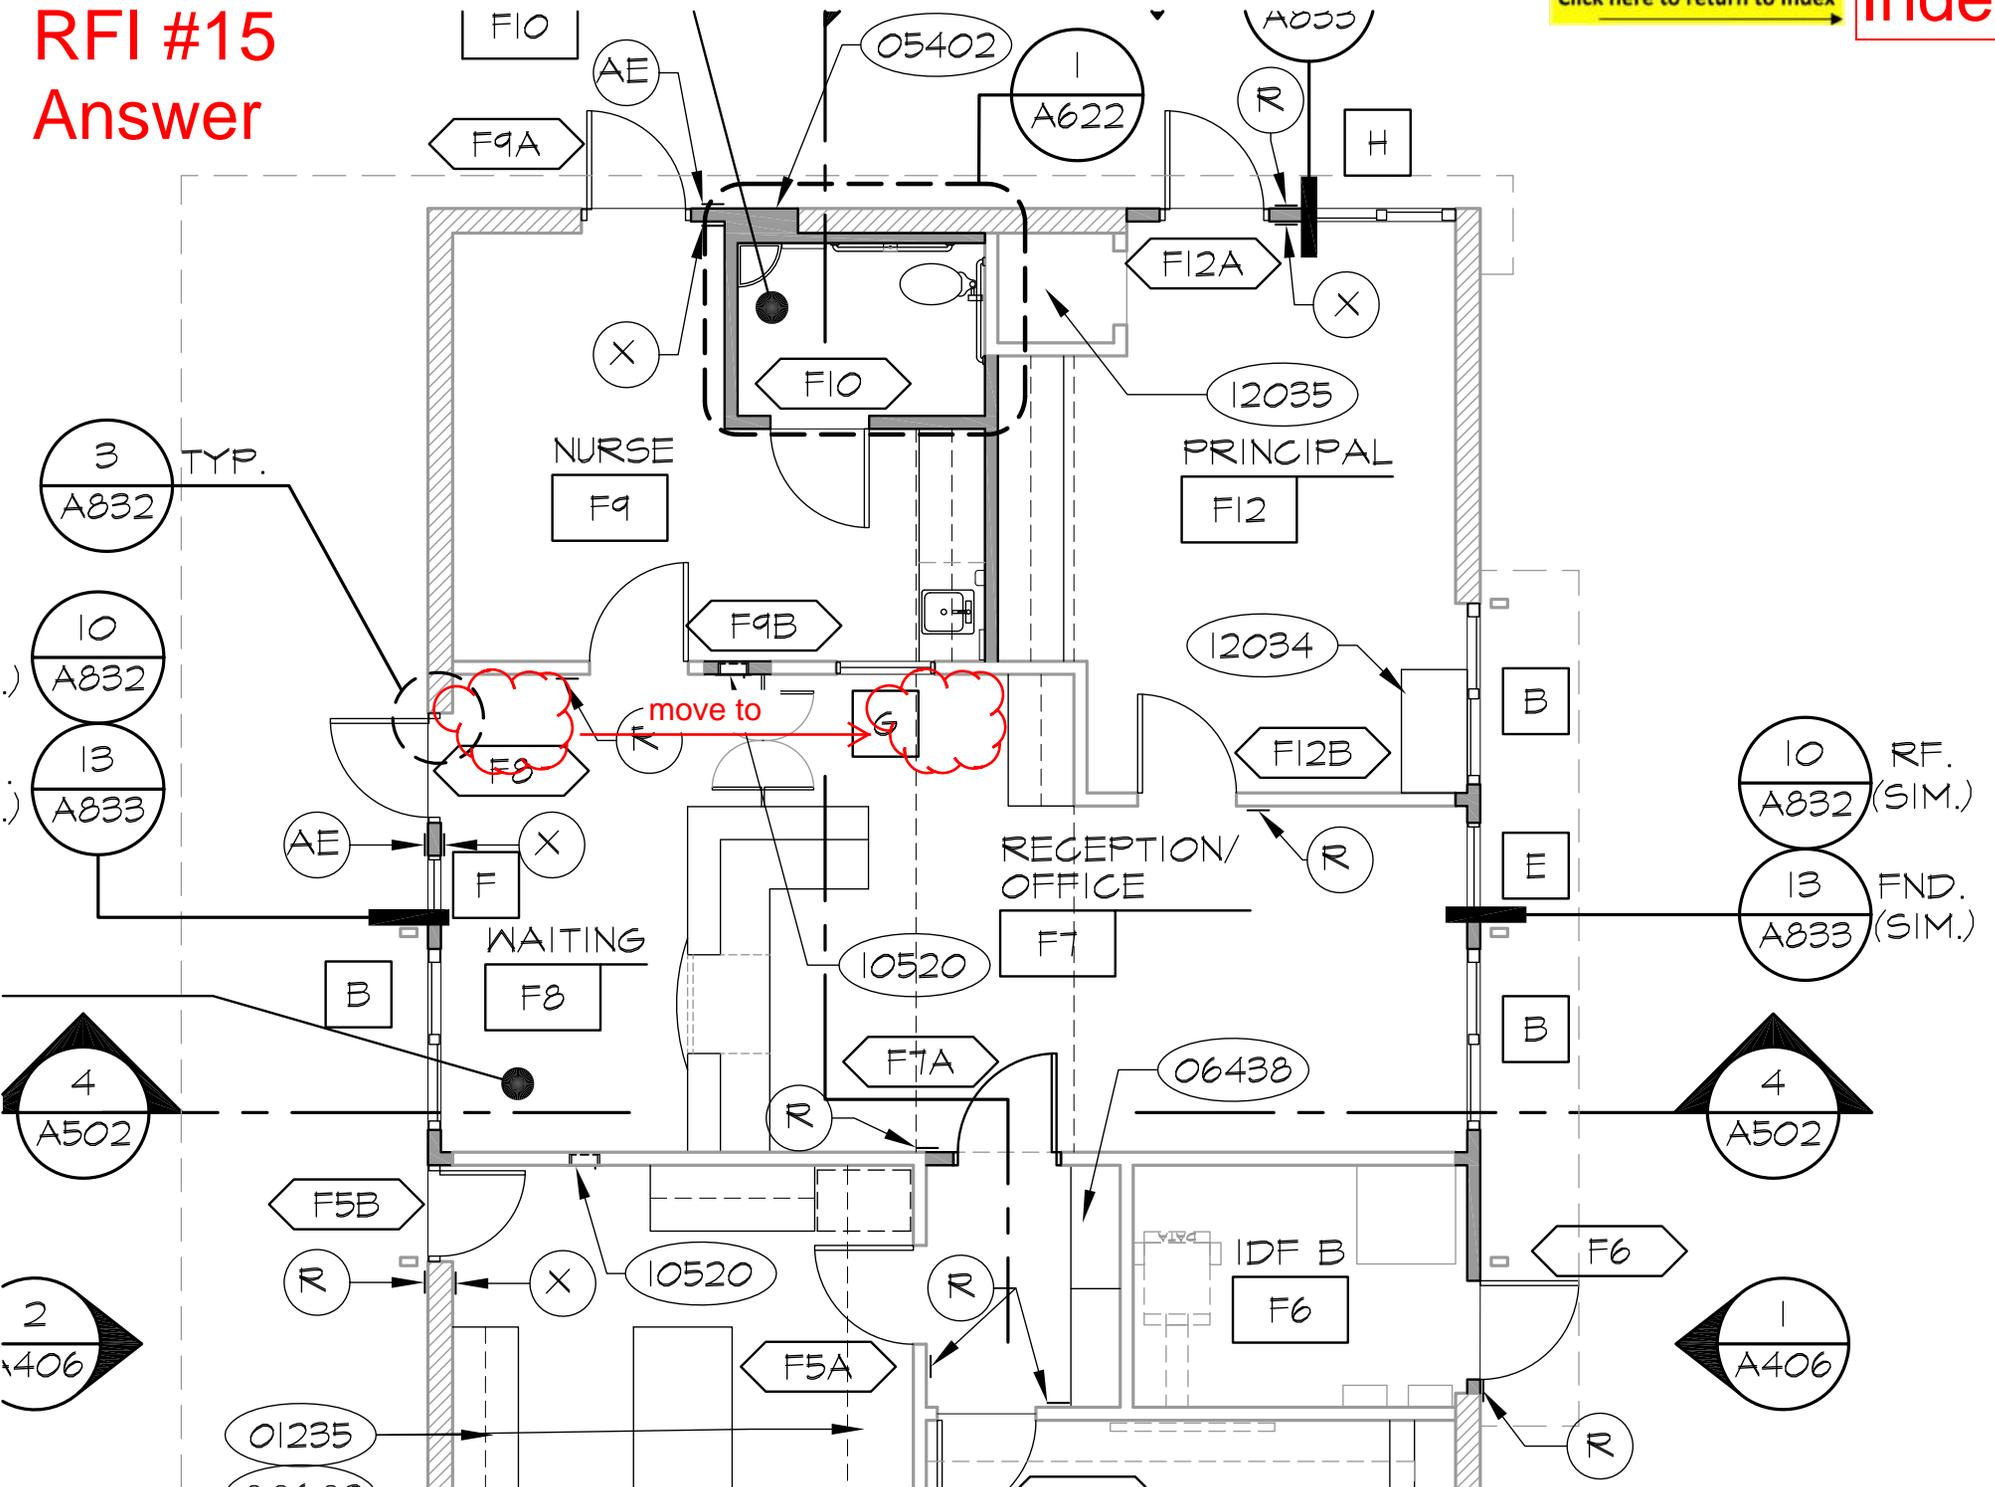

Project:

- 
- 
- 
- 

Document#: 07.13.2013 A Date: July 13, 2013  
 Page 1 of 1


Discussion between: (Parties as checked below)

- |                                     |                                       |                                     |                                     |
|-------------------------------------|---------------------------------------|-------------------------------------|-------------------------------------|
| <input type="checkbox"/>            | <input checked="" type="checkbox"/>   | <input type="checkbox"/>            | <input type="checkbox"/>            |
| <input checked="" type="checkbox"/> | D <input type="checkbox"/>            | <input type="checkbox"/>            | <input checked="" type="checkbox"/> |
| <input type="checkbox"/>            | D <input checked="" type="checkbox"/> | <input type="checkbox"/>            | <input type="checkbox"/>            |
| <input type="checkbox"/>            | <input type="checkbox"/>              | <input checked="" type="checkbox"/> | <input type="checkbox"/>            |
| <input checked="" type="checkbox"/> | <input type="checkbox"/>              | <input type="checkbox"/>            | <input type="checkbox"/>            |
| <input type="checkbox"/>            | <input type="checkbox"/>              | <input type="checkbox"/>            | <input checked="" type="checkbox"/> |

The following was discussed on July 13 2013 at 2:00 AM/PM

ADMINISTRATION BUILDING - PRINCIPAL'S OFFICE  
 REQUIRES HOLLOW METAL FRAME w/ DOOR @  
 CLOSET ACCESS.

PROVIDE & INSTALL ADJUSTABLE KEYS  
 STEERING @ 12" O.C. VERTICAL TOP TO PLATFORM

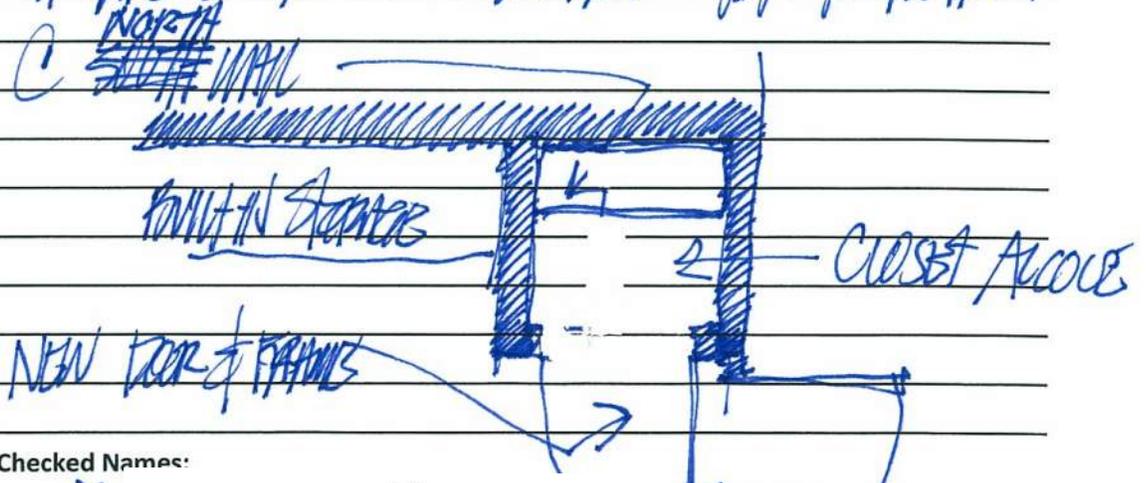

Distribution to All Checked Names:

- |                                     |                                       |                                     |                                     |
|-------------------------------------|---------------------------------------|-------------------------------------|-------------------------------------|
| <input type="checkbox"/>            | <input checked="" type="checkbox"/>   | <input type="checkbox"/>            | <input type="checkbox"/>            |
| <input checked="" type="checkbox"/> | D <input checked="" type="checkbox"/> | <input type="checkbox"/>            | <input checked="" type="checkbox"/> |
| <input type="checkbox"/>            | D <input checked="" type="checkbox"/> | <input type="checkbox"/>            | <input type="checkbox"/>            |
| <input type="checkbox"/>            | <input type="checkbox"/>              | <input checked="" type="checkbox"/> | <input type="checkbox"/>            |
| <input checked="" type="checkbox"/> | <input type="checkbox"/>              | <input type="checkbox"/>            | <input type="checkbox"/>            |
| <input type="checkbox"/>            | <input type="checkbox"/>              | <input type="checkbox"/>            | <input checked="" type="checkbox"/> |