

JOANN

fabric and craft stores®


360 Photo / As-Built Facility Survey


360 Photo/As-built Facility Survey



EXISTING SITE PHOTOGRAPH

Survey Date
October 15, 2013

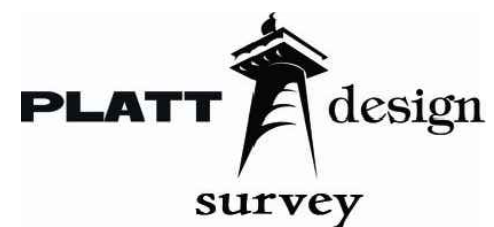

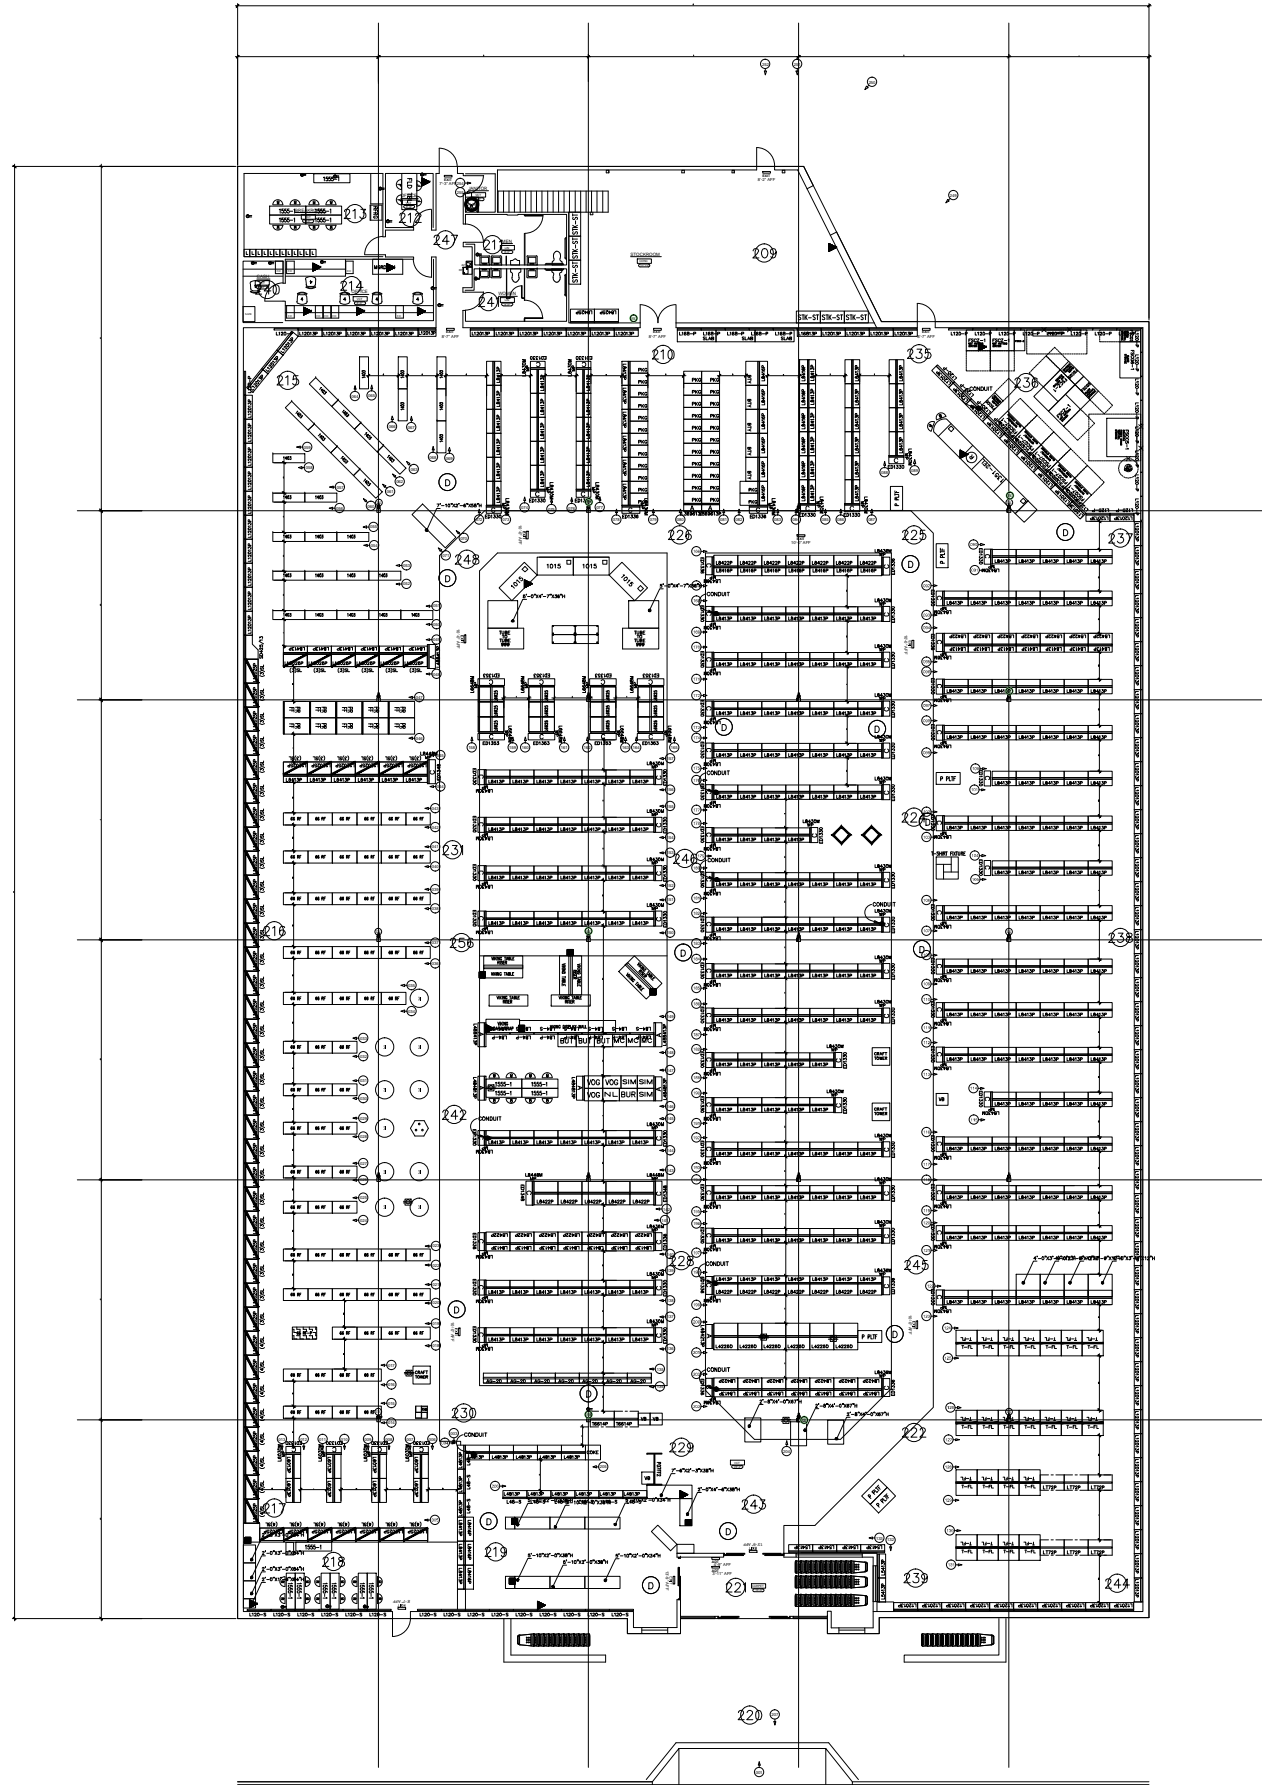

REVISIONS:

CLIENT:

TITLE:

LOCATION:

DRAFTED BY:
R. Platt

PROJECT MANAGER:
R. Platt

DATE:
10-20-2013

DRAWING NUMBER:
A003

PAGE: **4** OF: **9**

Floor Plan