

93 269831

LIBER 13999/883

CONSOLIDATING MASTER DEED

THE FAIRWAYS CONDOMINIUM
OAKLAND COUNTY CONDOMINIUM
SUBDIVISION PLAN NO. 576

This Consolidating Master Deed is made and executed this 8th day of September, 1993, by HSF Associates III Limited Partnership, a Michigan limited partnership (hereinafter referred to as "Developer"), whose address is 30833 Northwestern Highway, Suite 300, Farmington Hills, Michigan 48018.

2297 REG/DEEDS PAID
0001 SEP.28.93 09:40AM
2297 DEEDS 169.00

WITNESSETH:

2292 REG/DEEDS PAID
0001 SEP.28.93 09:40AM
2297 REG/DEEDS

WHEREAS, Developer made and recorded a condominium Master Deed establishing The Fairways Condominium (the "Condominium") as Oakland County Condominium Subdivision Plan No. 576 situated in the City of Troy, which Master Deed was recorded in Liber 10647, Pages 748 through 806, Oakland County Records, and amended by First Amendment of Master Deed and Replat No. 1 recorded in Liber 10805, Pages 771 through 786, Second Amendment of Master Deed and Replat No. 2 recorded in Liber 11035, Pages 612 through 631, Third Amendment of Master Deed and Replat No. 3 recorded in Liber 11260, Pages 214 through 230, Fourth Amendment of Master Deed and Replat No. 4 recorded in Liber 11807, Pages 206 through 220, Fifth Amendment of Master Deed and Replat No. 5 recorded in Liber 12154, Pages 490 through 505, Sixth Amendment of Master Deed and Replat No. 6 recorded in Liber 12390, Pages 498 through 512 and Seventh Amendment of Master Deed and Replat No. 7 recorded in Liber 12816, Pages 102 through 128; and Eighth Amendment of Master Deed recorded in Liber 13518, Pages 192 through 200.

WHEREAS, Developer is recording this Consolidating Master Deed, together with the Condominium Bylaws attached hereto as Exhibit A and the Condominium Subdivision Plan attached hereto as Exhibit B (both of which are hereby incorporated by reference and made a part hereof), to consolidate all prior amendments to the Master Deed into a single document as required under the provisions of the Condominium Act of Michigan and to show the Condominium improvements as built on the Condominium Plan.

9000576

NOW, THEREFORE, upon the recording hereof, Developer consolidates all prior amendments of the Master Deed into this Consolidating Master Deed and establishes The Fairway Condominium as a Condominium under the Condominium Act and declares that the Condominium shall be held, conveyed, mortgaged, hypothecated, encumbered, leased, rented, occupied, improved, or in any other manner utilized, subject to the provisions of said Act, and to the covenants, conditions, restrictions, uses, limitations, and affirmative obligations

OK - T. SMITH

OK - LM
16900
+ 210
R-102

~~139391884~~

set forth in this Master Deed and the Exhibits hereto, all of which shall be deemed to run with the land and shall be a burden and a benefit to the Developer, its successors and assigns, and any persons acquiring or owning an interest in the said real property, their grantees, successors, heirs, executors, administrators and assigns.

ARTICLE I
TITLE AND NATURE

The Condominium shall be known as The Fairway Condominium, Oakland County Condominium Subdivision Plan No. 576. The architectural plans and specifications for the Condominium were filed with the City of Troy. The buildings, Units and other improvements contained in the Condominium, including the number, boundaries, dimensions and volume of each Unit therein, are set forth in the Condominium Subdivision Plan attached as Exhibit B hereto. Each building contains individual Units for residential purposes only. Each Unit is capable of individual use, having its own entrance from and exit to a Common Element of the Condominium. Each Co-owner in the Condominium shall have an exclusive right to the Unit owned and shall have undivided and inseparable rights to share with other Co-owners the Common Elements of the Condominium as designated by the Master Deed. Co-owners shall have voting rights in the Fairway Condominium Association as set forth herein and in the Condominium Bylaws, Corporate Bylaws and Articles of Incorporation of such Association.

ARTICLE II
LEGAL DESCRIPTION

The land which comprises the Condominium established by this Master Deed is a parcel of land in the City of Troy, Oakland County, Michigan described as follows:

Part of the Northwest 1/4 of Section 11, T. 2 N., R. 11 E., City of Troy, Oakland County, Michigan, described as beginning at a point on the South Right-of-Way line of Square Lake Road (60 feet wide, 1/2 width), said point being distant S. 89° 24' 58" E. 547.04 feet and S. 00° 07' 02" W. 33.00 feet and S. 38° 19' 32" W. 34.14 feet from the N.W. corner of said Section 11, thence from said point of beginning and along said South Right-of-Way line of Square Lake Road S. 89° 24' 58" E. 767.28 feet to a point on the West Right-of-Way line of Hillmore Street (30 feet wide, 1/2 width), thence along said West line of Hillmore Street S. 00° 05' 38" W. 772.84 feet; thence N. 89° 24' 16" W. 300.00 feet; thence the following (8) eight courses and distances along "The Fair Ways Estates" as recorded in Liber 208

LIBER 13999 DE 885

Page 19 through 21 inclusive Oakland County Records N. 00° 05' 38" E. 26.40 feet, N. 89° 24' 16" W. 527.26 feet, N. 00° 11' 17" E. 15.49 feet, N. 99° 12' 03" W. 164.13 feet N. 00° 47' 57" E. 21.87 feet, N. 08° 50' 24" W. 100.00 feet, 17.41 feet along the arc of a curve to the right, said curve having a radius of 103.50 feet a central angle of 09° 38' 29", a chord length of 17.39 feet and a chord bearing of S. 85° 58' 46" W. and N. 39° 12' 03" W. 196.92 feet to a point on the East Right-of-Way line of Rochester Road (75 feet wide, 1/2 width); thence along said East Right-of-Way line of Rochester Road N. 00° 19' 28" E. 167.16 feet; thence N. 56° 12' 50" E. 262.62 feet; thence N. 38° 19' 32" E. 376.48 feet to the point of beginning, containing 17.67 acres of land and being subject to easements, agreements and restrictions of record and all governmental limitations. Above legal covers EITC
 The Fairways Condo Dec # 574 20-11-102-000

UNITS 1-100.

ARTICLE III
DEFINITIONS

Certain terms used in this Master Deed and the Exhibits hereto, and in the Articles of Incorporation and Corporate Bylaws of the Fairway Condominium Association are defined as follows:

(a) The "Act" or "Condominium Act" means Act 59 of the Public Acts of Michigan of 1978, as amended.

(b) "Additional Land" means the land described hereafter, some or all of which may be added to the Condominium in an amendment of this Master Deed.

(c) "Association" means the Michigan non-profit corporation, Fairway Condominium Association, of which all Co-owners shall be members, which Association shall administer, operate, manage and maintain the Condominium. Any action required of or permitted to the Association shall be exercisable by its Board of Directors unless specifically reserved to its members by the Condominium Documents or the laws of the State of Michigan.

(d) "Common Elements" means the portions of the Condominium other than the Condominium Units.

(e) "Condominium" means The Fairway Condominium as a Condominium established pursuant to the provisions of the Act, and includes the land and the buildings, all improvements and



structures thereon, and all easements, rights and appurtenances belonging to the Condominium.

(f) "Condominium Bylaws" means Exhibit A hereto, being the bylaws setting forth the rights and obligations of the Co-owners as members of the Association.

(g) "Condominium Documents," wherever used, means and includes this Master Deed and the Exhibits hereto, the Articles of Incorporation and the Corporate Bylaws of the Association.

(h) "Condominium Subdivision Plan" or "Plan" means the Plan attached to this Master Deed as Exhibit B. The Plan assigns a number to each Condominium Unit and includes a description of the nature, location and approximate size of certain Common Elements.

(i) "Condominium Unit" or "Unit" means the enclosed space constituting a single complete Unit designed and intended for separate ownership and use in the Condominium as such space may be described on Exhibit B hereto.

(j) "Co-owner" means a person, firm, corporation, partnership, association, trust or other legal entity or any combination thereof who or which owns one or more Units in the Condominium. Developer is a Co-owner as long as Developer owns one or more Units.

(k) "Corporate Bylaws" means the Corporate Bylaws of the Association, as distinguished from the Condominium Bylaws.

(l) "Developer" means HSF Associates III Limited Partnership, a Michigan limited partnership, its successors or assigns. All development rights reserved to Developer herein are assignable in writing; provided, however, that conveyances of Units by Developer shall not serve to assign Developer's development rights unless the instrument of conveyance expressly so states.

(m) "General Common Elements" means the Common Elements other than the Limited Common Elements.

(n) "Limited Common Elements" means a portion of the Common Elements reserved in this Master Deed for the exclusive use of less than all of the Co-owners.

(o) "Master Deed" means this document to which the Condominium Bylaws and Condominium Subdivision Plan are attached as exhibits.

(p) "Mortgagee" means the named mortgagee or owner of any mortgage on all or any portion of the Condominium.

13994887

(q) "Percentage of Value" means the percentage assigned to each Condominium Unit in this Master Deed. The Percentages of Value of all Units shall total one hundred (100%) percent. Percentages of Value shall be determinative only with respect to those matters to which they are specifically deemed to relate either in the Condominium Documents or in the Act.

(r) "Person" means an individual, firm, corporation, partnership, association, trust, the state or an agency of the state or other legal entity, or any combination thereof.

(s) "Size" means the number of cubic feet or the number of square feet of ground or floor space within each Condominium Unit computed by reference to the Plan and rounded off to a whole number.

(t) "Transitional Control Date" means the date on which the Board of Directors of the Association takes office pursuant to an election in which the votes which may be cast by eligible Co-owners unaffiliated with the Developer exceed the votes which may be cast by the Developer.

ARTICLE IV
COMMON ELEMENTS

The Common Elements of the Condominium described in Exhibit B attached hereto and the respective responsibilities for maintenance, decoration, repair, replacement, restoration or renovation thereof are as follows:

(a) The General Common Elements are:

(1) The land described in Article II hereof, including roads, walks, parking areas and landscaped areas;

(2) The electrical, gas, telephone, plumbing and cable television (if any) networks or systems throughout the Condominium, including that contained within Unit walls up to the point of connection with outlets or fixtures within any Unit;

(3) Foundations, supporting columns, unit perimeter walls (including windows and doors therein) and such other walls as are designated on the Plan as General Common Elements, roofs, ceilings, floor construction between Unit levels and chimneys;

(4) If any meter, appliance, or fixture services a Unit other than a Unit it is located within, then such meter, appliance or fixture shall be a general common element:

139997888

(5) The gate house, pool, club house and tennis court;

(6) Such other elements of the Condominium not herein designated as Limited Common Elements which are not enclosed within the boundaries of a Unit.

(b) The Limited Common Elements are:

(1) Patios, porches, drives and air conditioner compressors designated on the Plan as Limited Common Elements are limited to the sole use of the Co-owners of the Units to which such Common Elements give access;

(2) Interior surfaces of Unit perimeter walls (including any Unit windows and doors therein), ceilings and floors contained within a Unit are limited to the sole use of the Co-owner of such Unit;

(c) Maintenance, repair and replacement of all Common Elements shall be the responsibility of the Association, to be assessed to all Co-owners according to their Percentage of Value, subject to the following provisions:

(1) The Limited Common Elements described in subparagraph (b)(2) above shall be the responsibility of the respective Co-owners having the use thereof.

(2) The cost of repair of damage to a Common Element caused by a Co-owner, or family member or invitee of a Co-owner, shall be assessed against the Co-owner.

ARTICLE V
USE OF PREMISES

No person shall use any Unit or the Common Elements in any manner inconsistent with the purposes of the Condominium or in any manner which will interfere with or impair the rights of any other Co-owner in the use and enjoyment of the Condominium.

ARTICLE VI
CONDOMINIUM UNIT DESCRIPTION AND PERCENTAGE OF VALUE

The Condominium consists of one hundred residential Units. Each Unit is described in this paragraph with reference to the Condominium Subdivision Plan attached hereto as Exhibit B. Each Unit shall include all that space contained within the interior sides of the finished, unpainted perimeter walls, and within the ceilings and finished subfloor, all as shown on the Plan and delineated with heavy outlines. For all purposes, individual Units may hereafter be defined and described by reference to this Master Deed and the individual number assigned to the Unit

LIBER 13999 RD 889

in the Plan. The Percentage of Value assigned to each Unit is set forth below and shall be determinative of the proportionate share of each respective Co-owner in the proceeds and expenses of the Association and the value of such Co-owner's vote at meetings of the Association and the undivided interest of the Co-owner in the Common Elements. The total percentage value of the Condominium is 100%. Individual Unit Percentages of Value shall be as follows:

Schedule of Percentages of Value

<u>Unit Number</u>	<u>Percentage of Value</u>
1	.96%
2	.96%
3	1.14%
4	1.14%
5	.96%
6	.96%
7	.72%
8	.94%
9	.96%
10	1.14%
11	1.14%
12	.96%
13	.96%
14	.96%
15	.96%
16	1.14%
17	1.14%
18	.96%
19	.96%
20	.96%
21	.96%
22	1.14%
23	1.14%
24	.96%
25	.96%
26	.96%
27	.96%
28	1.14%
29	1.14%
30	.96%
31	.96%
32	.72%
33	.94%
34	.96%
35	1.14%
36	1.14%
37	.96%
38	.96%
39	.72%
40	.94%

LIBER 13999/690

Schedule of Percentages of Value

<u>Unit Number</u>	<u>Percentage of Value</u>
41	.96%
42	1.14%
43	1.14%
44	.96%
45	.96%
46	.96%
47	.96%
48	.96%
49	.96%
50	.96%
51	.96%
52	1.14%
53	1.14%
54	.96%
55	.96%
56	.96%
57	.96%
58	1.14%
59	1.14%
60	.96%
61	.96%
62	.96%
63	.96%
64	1.14%
65	1.14%
66	.96%
67	.96%
68	.96%
69	.96%
70	1.14%
71	1.14%
72	.96%
73	.96%
74	.96%
75	.96%
76	.96%
77	.96%
78	.96%
79	.96%
80	1.14%
81	1.14%
82	.96%
83	.96%
84	.96%

139997891

Schedule of Percentages of Value

<u>Unit Number</u>	<u>Percentage of Value</u>
85	.96%
86	1.14%
87	1.14%
88	.96%
89	.96%
90	.96%
91	.96%
92	.96%
93	.96%
94	.72%
95	.94%
96	.96%
97	1.14%
98	1.14%
99	.96%
100	.96%

The method and formula used by Developer to determine the foregoing percentages was to divide the square footage of each Unit as shown on the Plan by the total square footage of all Units. In determining square footage, garages, optional lofts and basements were excluded. Developer rounded off percentages and made minor adjustments to achieve a total of 100%.

ARTICLE VII
EASEMENTS

Developer declares and grants the following permanent, nonexclusive easements:

(a) Developer hereby reserves permanent easements for ingress and egress over the roads and walks in the Condominium including but not limited to Creekside Drive and Fairways Boulevard and permanent easements to use, tap into, enlarge or extend all utility lines in the Condominium, including, without limitation, all communications, water, gas, electric, storm and sanitary sewer lines, all of which easements shall be for the benefit of the Additional Land described in Article IX hereof whether or not such land is added to the Condominium and for the benefit of any other land adjoining the Condominium (or any expansion thereof) if now owned or hereafter acquired by Developer or its successor. Developer has no financial obligation to support such easements.

(b) Developer reserves the right and power to grant easements over, or dedicate, portions of any of the Common Elements for utility, street, safety or construction purposes, and all persons acquiring any interest in the Condominium shall

139997892

be deemed irrevocably to have appointed Developer and its successors as agent and attorney-in-fact to make such easements or dedications. Any obligations imposed upon the grantor of such easements and dedications shall be exclusive obligations of the Association and shall be assessed to the Co-owners according to Percentages of Value in the same manner as other Association expenses. After completion of construction of the Condominium, including any expansion thereof, the foregoing right and power may be exercised by the Association.

(c) In the event any portion of a Unit or Common Element encroaches upon another Unit or Common Element due to shifting, settling, or moving of a building, or due to survey errors or construction deviations, reconstruction or repair, reciprocal easements shall exist for the maintenance of such encroachment for as long as such encroachment exists, and for maintenance thereof after rebuilding in the event of any destruction. There shall be easements to, through and over those portions of the land, structures, buildings, improvements and walls (including interior Unit walls) contained therein for the installation, maintenance and servicing of all utilities in the Condominium, including, but not limited to, lighting, heating, power, sewer, water and communications including telephone and cable television lines. There shall exist easements of support with respect to any Unit interior wall which supports a Common Element.

(d) Developer may provide a pool and clubhouse for use by the Condominium in the "Additional Land", as that term is defined in Article IX of this Master Deed. Although they may be provided for use by the Condominium, the pool and clubhouse facilities might not be added to the Condominium. If Developer installs a pool and clubhouse on the Additional Land (as defined in Article IX of this Master Deed) and makes such facilities available for the use of the Condominium, the Association shall be obligated for the expenses of maintenance, repair, restoration and replacement of such facilities even if the facilities are not a part of the Condominium. If the pool and clubhouse facilities are not restricted to the exclusive use of Condominium Co-owners, the Association shall be responsible for a portion of the maintenance, repair, restoration and replacement expenses for the pool and clubhouse facilities, which portion shall be equal to the percentage which results when the number of units in the Condominium is divided by the total number of dwelling units which have the right to use the pool and clubhouse facilities. The expenses of maintenance, repair, restoration and replacement of the pool and clubhouse facilities shall be assessed to each Co-owner in the same manner as other Association expenses.

139991893

(e) Developer has executed an Agreement and Irrevocable Petition for Public Improvements (the "Agreement") with the City of Troy. The Agreement provides that the Developer and all future Co-owners of the Condominium (including the Additional Land) shall pay a proportionate share of the cost of widening Hillmore Street in and along the City of Troy right-of-way. The Hillmore Street right-of-way is shown on the Condominium Plan and is partially included in the Condominium and partially included in the Additional Land. Hillmore Street may hereafter be widened to include this right of way. The Agreement is intended to run with the land and will be binding on all persons acquiring an interest in the Condominium. Among other things, it provides that each owner of an interest in the Condominium property shall be obligated to pay a portion of the special assessment levied against the Condominium property in order to widen Hillmore Street. When the City of Troy decides to widen Hillmore Street each Condominium Co-owner shall be obligated to pay, as a part of their property taxes or assessments, any special assessment for the cost of such widening which may be levied by the City.

(f) The Developer hereby reserves for the benefit of itself, its successors and assigns, and all future owners and users of the Additional Land described in Article IX of this Master Deed or any portion or portions thereof, a nonexclusive easement for the use of the gate house, pool, club house and tennis court in the Condominium (the gate house, pool, club house and tennis court are collectively referred to herein as the "Amenities"). The Association shall operate, maintain, repair and replace the Amenities. In the event that all or a portion of the Additional Land is not included in the Condominium and Developer grants the right to use the Amenities to dwelling units hereafter built thereon, all expenses of operation, maintenance, repair and replacement of the Amenities shall be shared by the Co-owners of Units in the Condominium and the owners of any such dwelling units constructed upon the Additional Land. The share of such expenses attributable to each dwelling unit, whether located in the Condominium or on the Additional Land, shall be determined by multiplying the expenses of operation, maintenance, repair and replacement of the Amenities times a fraction, the numerator of which is one and denominator of which is number of Units in the Condominium plus the number of dwelling units on the Additional Land entitled to use and obligated to support the Amenities pursuant to this easement. The right of any person other than the Developer owning a dwelling unit in the Additional Land to use the Amenities shall be created by a specific recorded instrument made by Developer granting or assigning such right of use and expressly imposing upon the owner of the dwelling unit and his or her successors in title the obligation to bear the requisite proportionate share of such expenses.

LIBER 139991894

ARTICLE VIII
AMENDMENTS

This Master Deed and any Exhibit hereto may be amended in the following manner:

(a) Amendments may be made and recorded by Developer or by the Association.

(b) If the amendment will materially change the rights of the Co-owners or Mortgagees, then such amendment requires the written consent of not less than two-thirds (2/3) in value of the votes of the Co-owners and Mortgagees of the Units (unless a greater majority is specified in the Condominium Bylaws). A Mortgagee shall have one vote for each mortgage held, which shall be weighted according to the mortgaged Unit's percentage of value.

(c) Notwithstanding subparagraph (b) above, but subject to the limitation of subparagraph (d) below, Developer reserves the right to amend this Master Deed or any of its exhibits for any of the following purposes without the consent of Co-owners or Mortgagees:

(1) To modify the types and sizes of unsold Units and the General and/or Limited Common Elements adjoining or appurtenant to unsold Units;

(2) To amend the Condominium Bylaws, subject to any restrictions on amendments stated therein;

(3) To correct arithmetic errors, typographical errors, survey errors, or any similar errors in the Master Deed, Plan or Condominium Bylaws;

(4) To clarify or explain the provisions of the Master Deed or its exhibits;

(5) To comply with the Act or rules promulgated thereunder or with any requirements of any governmental or quasi-governmental agency or any financing institution providing or proposing to provide a mortgage on any Unit or to satisfy the title requirements of any title insurer insuring or proposing to insure title to any Unit;

(6) To expand or convert the Condominium and to redefine Common Elements and adjust Percentages of Value in connection therewith, to include an "optional garage" and/or "optional loft" within the perimeter of any Unit, and to make any other amendments expressly permitted by this Master Deed;

139997895

(7) To make, define or limit easements affecting the Condominium;

(8) To record an "as-built" Condominium Subdivision Plan and/or consolidating master deed;

(9) To revise the Plan, as necessary, to conform to any construction options offered by Developer and elected by any purchasers of Units.

(10) To revise percentages of value in accordance with the formula stated in Article VI if the square footage of any Unit is changed.

(d) Notwithstanding any other provision of this Article VIII, the method or formula used to determine the Percentages of Value of Units in the Condominium, as described above, and any provisions relating to the ability or terms under which a Co-owner may rent a Unit, may not be modified without the consent of each affected Co-owner and Mortgagee. A Co-owner's Condominium Unit dimensions or appurtenant Limited Common Elements may not be modified without the Co-owner's consent. The Association may make no amendment which materially changes the rights of Developer without the written consent of the Developer as long as the Developer owns any Units in the Condominium or has the right to expand the Condominium.

ARTICLE IX
FUTURE EXPANSION AND CONVERSION OF CONDOMINIUM

The Condominium is established as an expandable, convertible condominium in accordance with the provisions of this Article:

(a) Developer reserves the right, but not an obligation, to expand the Condominium and convert certain areas.

(b) There are no restrictions or limitations on Developer's right to expand or convert the Condominium except as stated in this Article. The consent of any Co-owner shall not be required to expand or convert the Condominium. All of the Co-owners and Mortgagees of Units and persons interested or to become interested in the Condominium from time to time shall be deemed to have irrevocably and unanimously consented to such expansion or conversion of the Condominium and any amendment or amendments to this Master Deed to effectuate the expansion or conversion and to any reallocation of Percentages of Value of existing Units which Developer may determine necessary in conjunction with such amendment or amendments. All such interested persons irrevocably appoint Developer or its

LIBER 13999 PG 896

successors as agent and attorney for the purpose of executing such amendment or amendments to the Master Deed and all other documents necessary to effectuate the foregoing. Such amendments may be made without the necessity of rerecording an entire Master Deed or the Exhibits thereto and may incorporate by reference all or any pertinent portions of this Master Deed and the Exhibits herein. Nothing herein contained, however, shall in any way obligate Developer to enlarge or convert the Condominium and Developer may, in its discretion, establish all or a portion of the Additional Land described below as a rental development, a separate condominium, or any other form of development.

(c) The Developer's right to expand or convert the Condominium shall expire six years after the initial recording of this Master Deed.

(d) The land which may be added to the Condominium (herein referred to as the "Additional Land") is situated in the City of Troy, Oakland County, Michigan and is more specifically described as follows:

PART OF THE NORTHWEST 1/4 OF SECTION 11, T. 2 N., R. 11 E., CITY OF TROY, OAKLAND COUNTY, MICHIGAN, DESCRIBED AS BEGINNING AT A POINT ON THE NORTH LINE OF SAID SECTION 11, ALSO BEING THE CENTERLINE OF SQUARE LAKE ROAD BEING DISTANT S. 89°24'58" E. 547.04 FEET FROM THE N.W. CORNER OF SAID SECTION 11; THENCE FROM SAID POINT OF BEGINNING S. 89°24'58" E. 207.92 FEET ALONG SAID CENTERLINE OF SQUARE LAKE ROAD; THENCE S. 00°35'02" W. 279.00 FEET; THENCE S. 21°56'35" E. 132.87 FEET; THENCE DUE EAST 283.00 FEET; THENCE DUE NORTH 150.00 FEET; THENCE N. 30°24'58" W. 57.00 FEET; THENCE N. 00°35'02" E. 200.00 FEET; THENCE S. 89°24'58" E. 265.22 FEET ALONG THE NORTH LINE OF SECTION 11, ALSO BEING THE CENTERLINE OF SQUARE LAKE ROAD; THENCE S. 00°05'38" W. 832.84 FEET; THENCE N. 89°24'16" W. 330 FEET; THENCE N. 00°05'38" E. 26.40 FEET; THENCE N. 89°24'16" W. 527.26 FEET; THENCE N. 00°11'17" E. 15.49 FEET; THENCE N. 89°12'03" W. 394.13 FEET; THENCE N. 00°19'28" E. 286.16 FEET ALONG THE EAST LINE OF ROCHESTER ROAD; THENCE N. 56°57'50" E. 262.62 FEET; THENCE N. 38°19'32" E. 376.48 FEET; THENCE NORTH 00°07'02" E. 33.00 FEET TO SAID NORTH SECTION LINE ALSO BEING THE POINT OF BEGINNING.

LIBER 13999 OF 1897

(e) The Additional Land may be added to the Condominium in its entirety on in parcels, in one amendment to this Master Deed or in separate amendments, at the same time or at different times, all in Developer's discretion. There are no restrictions upon the order in which portions of the Additional Land may be added to the Condominium.

(f) There are no restrictions upon the locations of any improvements that may be made on any portions of the Additional Land, and Developer reserves the right to locate such improvements in Developer's sole discretion subject only to such applicable laws and ordinances which may affect the Condominium.

(g) The maximum number of units which Developer reserves the right to construct upon the Additional Land is 87, which together with the 13 Units described in the initial Master Deed equals 100 Units. Local building ordinances and regulations may permit a smaller number of Units to be created upon the Additional Land. This Master Deed imposes no restrictions upon the number of Units to be created on individual portions of the Additional Land, provided that the maximum number of Units stated herein for the whole shall not be exceeded.

(h) One hundred (100%) percent of the Additional Land and the Units to be created thereon shall be restricted exclusively to residential use and Common Elements as may be consistent and compatible with the residential use.

(i) The extent to which any structures erected on any portion of the Additional Land added to the Condominium are compatible with structures on land included in the original Master Deed is solely within the discretion of the Developer, subject only to the requirements of local ordinances and building authorities, and is not limited by this Master Deed.

(j) The improvements which may be made on any portion of the Additional Land to be added to the Condominium may only be residential Condominium Units and such Common Elements as may be compatible therewith. There are no other restrictions upon such improvements except those which are imposed by state law, local ordinances or building authorities.

(k) There are no restrictions as to types of Condominium Units which may be created upon the Additional Land except that such units must be for residential use and must comply with state law, local ordinances and the requirements of building authorities.

139991898

(l) Developer may create Limited Common Elements upon the Additional Land and designate Common Elements thereon which may be subsequently assigned as Limited Common Elements. The nature of any such Limited Common Elements to be constructed upon the Additional Land is exclusively within the discretion of the Developer.

(m) If the Condominium is expanded, it shall be expanded by an amendment to the Master Deed or by a series of successive amendments to the Master Deed, each adding Additional Land and/or improvements to the Condominium.

(n) Any amendment to the Master Deed which alters the number of Units in the Condominium shall proportionately readjust the existing Percentages of Value of Condominium Units to preserve a total value of one hundred (100%) percent for the entire condominium. Percentages of Value shall be readjusted and determined in accordance with the method and formula described in Article VI of this Master Deed.

(o) All areas within the Condominium bordering the Additional Land shall be deemed Convertible Areas, which areas may be used for construction of additional buildings, Units or Common Elements in connection with any expansion of the Condominium, subject to the same limitations and restrictions which apply to an expansion of the Condominium.

(p) Any expansion or conversion shall be deemed to have occurred at the time of the recording of an amendment to this Master Deed embodying all essential elements of the expansion or conversion. At the conclusion of expansion of the Condominium, not later than 180 days after completion of construction, a consolidating master deed and plans showing the Condominium "as built" shall be prepared and recorded by the Developer. A copy of the recorded consolidating master deed shall be provided to the Association.

IN WITNESS WHEREOF, Developer has caused this Master Deed to be executed the day and year first above written.

WITNESS:

HSF ASSOCIATES III LIMITED PARTNERSHIP, a Michigan limited partnership

By: CHAMANDA II, INC., a Michigan corporation, General Partner

Phillip Wm. Fisher
Its: President

Marjorie L. Whetstone
Marjorie L. Whetstone
Lisa Johnson
Lisa Johnson

AND

LIBER 139997899

By: DIVERSIFIED ASSET CORP.,
a Michigan corporation,
General Partner

June Marie Koch
JUNNA MARIE KOCH
Patricia A. Wright
PATRICIA A. WRIGHT

By: [Signature]
Gilbert ("Buzz") Silverman
Its: General Partner

STATE OF MICHIGAN)
) ss.
COUNTY OF OAKLAND)

The foregoing instrument was acknowledged before me this 8th day of SEPTEMBER, 1993, by Phillip Wm. Fisher, who is the President of Chamanda II, Inc., a Michigan corporation, one of the general partners of HSF Associates III Limited Partnership, a Michigan limited partnership, on behalf of HSF Associates III Limited Partnership.

[Signature]
Notary Public, OAKLAND County
State of Michigan

DENNIS N. MCIRWITZ
Notary Public, Oakland County, MI
My Commission Expires 2-2-97

My Commission Expires: V.V.97.

STATE OF MICHIGAN)
) ss.
COUNTY OF OAKLAND)

The foregoing instrument was acknowledged before me this 25th day of August, 1993, by Gilbert ("Buzz") Silverman, the President of Diversified Asset Corp., a Michigan corporation, one of the general partners of HSF Associates III Limited Partnership, a Michigan limited partnership, on behalf of HSF Associates III Limited Partnership.

[Signature]
Notary Public, Oakland County
State of Michigan
CANOILE L. PATTERSON

My Commission Expires: 10-9-96

PREPARED BY AND WHEN RECORDED
RETURN TO:

Kevin M. Kohls, Esq.
Honigman Miller Schwartz and Cohn
2290 First National Building
Detroit, Michigan 48226
A4682A

LIBER 13999 P. 900

EXHIBIT A
TO CONSOLIDATING MASTER DEED
CONDOMINIUM BYLAWS
THE FAIRWAY CONDOMINIUM ASSOCIATION

ARTICLE I

Section 1. The Condominium shall be administered by a Michigan non-profit corporation, the Fairway Condominium Association (hereinafter called the "Association") which shall be responsible for the management, maintenance, operation and administration of the common elements, easements and affairs of the Condominium in accordance with the Master Deed, these Bylaws, the Articles of Incorporation, Corporate Bylaws and duly adopted Rules and Regulations of the Association, and the laws of the State of Michigan. These bylaws are designated as the Condominium Bylaws and relate to the manner in which the Condominium and the common affairs of the Co-owners of the Condominium units shall be administered. Terms defined in the Master Deed shall have the same meaning when used herein. The Condominium is a residential condominium.

Section 2. Membership in the Association and voting by members of the Association shall be in accordance with the following provisions:

(a) Each Co-owner, including Developer, shall be a member of the Association and no other person or entity shall be entitled to membership. Each member shall have one vote for each unit owned. If voting is by value, the value of each vote shall be the percentage assigned in the Master Deed.

(b) The share of a Co-owner in the funds and assets of the Association cannot be assigned, pledged or transferred in any manner except as an appurtenance to a unit in the Condominium.

(c) Each Co-owner shall be entitled to one vote for each unit owned, the value of which shall equal the percentage allocated in the Master Deed. Voting shall be by value unless otherwise expressly required by the Condominium Documents or by law. In the case of any unit owned jointly by more than one Co-owner, the voting right appurtenant to that unit may be exercised jointly as a single vote or may be split if all the joint Co-owners of the unit so agree in writing.

(d) No Co-owner, other than the Developer, shall be entitled to vote at any meeting of the Association until

13999901

the Co-owner has presented evidence of ownership of a unit in the Condominium to the Association. No Co-owner, other than the Developer, shall be entitled to vote prior to the first annual meeting of Co-owners held in accordance with section 6 of this Article 1 except as specifically provided in section 7. The vote of each Co-owner may only be cast by the individual representative designated by such Co-owner in the notice required in subparagraph (e) below or by a proxy given by such individual representative.

(e) Each Co-owner shall file a written notice with the Association designating the individual representative who shall vote at meetings of the Association and receive all notices and other communications from the Association on behalf of such Co-owner. Such notice shall state the name and address of the individual representative designated, the number or numbers of the unit or units owned by the Co-owner, and the name and address of each person, firm, corporation, partnership, association, trust or other entity who is the Co-owner. Such notice shall be signed and dated by the Co-owner at any time by filing a new notice in the manner herein provided. At any meeting the filing of such written notice as a prerequisite to voting may be waived by the chairman of the meeting.

(f) There shall be an annual meeting of the Co-owners commencing with the first annual meeting held as provided in section 6 of this Article 1. Other meetings shall be held as provided for in the Corporate Bylaws of the Association. Notice of the time, place and subject matter of all meetings shall be given by mailing the same to each individual representative designated by the respective Co-owners.

(g) The presence in person or by proxy of more than one-half in value of the Co-owners shall constitute a quorum for holding a meeting of the members of the Association. The written vote of any person furnished at or prior to any duly called meeting at which meeting said person is not otherwise present in person or by proxy shall be counted in determining the presence of a quorum with respect to the question upon which the vote is cast.

(h) Votes may be cast in person or by proxy or by a writing duly signed by the designated voting representative not present at a given meeting in person or by proxy. Proxies and any written votes must be filed with the Secretary of the Association at or before the appointed time of each meeting of the Co-owners. Cumulative voting shall not be permitted.

FILED 1399902

(i) Unless otherwise required by law or by the Condominium Documents, any action which could be authorized at a meeting of the members shall be authorized by any affirmative vote of more than fifty (50%) percent in value. The foregoing statement and any other provision of the Master Deed, these Bylaws or the Corporate Bylaws requiring the approval of a majority (or other stated percentage) of the members shall be construed to mean, unless otherwise specifically stated, a majority (or other stated percentage) in value of the votes cast by those qualified to vote and present in person or by proxy (or written vote, if applicable) at a given meeting of the Co-owners duly called and held.

(j) Other provisions relating to voting by members, not inconsistent with the provisions herein contained, may be set forth in the Corporate Bylaws.

Section 3. The Board of Directors of the Association shall keep detailed books of account showing all expenditures and receipts of the Condominium and its administration which shall specify the maintenance and repair expenses of the common elements and any other expenses incurred by or on behalf of the Association. All books, records and contracts of the Association shall be available for examination by any of the Co-owners and their mortgagees during convenient times. All books and records shall be audited or reviewed at least annually by independent accountants; provided, however, that such audits need not be certified. The Association shall prepare and distribute to each Co-owner at least annually a financial statement, the contents of which shall be defined by the Association. Any institutional holder of a first mortgage lien on any unit in the Condominium shall be entitled to receive a copy of such annual audited financial statement within 90 days following the end of the Association's fiscal year upon request therefor. The costs of any such audit and any accounting expenses shall be expenses of administration. The Association shall keep current copies of the Master Deed establishing the Condominium and all amendments to the Master Deed and all other Condominium Documents available for inspection at reasonable hours by Co-owners, prospective purchasers of Condominium units and existing and prospective mortgagees of Condominium units.

Section 4. The affairs of the Association shall be governed by a Board of Directors, all of whom shall serve without compensation. Directors must be members of the Association, except for the First Board of Directors designated in the Articles of Incorporation of the Association and any successors thereto appointed prior to the first annual meeting

139991303

of Co-owners held pursuant to section 6 of this Article 1. If a member is a partnership or corporation, then any partner or employee of the partnership, or officer, director or employee of the corporation shall be qualified to serve as a director.

(a) The Board of Directors shall have all powers and duties necessary for the administration of the affairs of the Association and may do all acts and things necessary thereto subject to the provisions of the Master Deed, these Bylaws, the Corporate Bylaws, Articles of Incorporation and applicable laws. In addition to the foregoing general duties, the Board of Directors shall be responsible specifically for the following:

(i) To manage and administer the affairs of and maintain the Condominium and the common elements thereof.

(ii) To levy and collect assessments from the members of the Association and to use the proceeds thereof for the purposes of the Association.

(iii) To carry insurance and collect and allocate the proceeds thereof.

(iv) To rebuild improvements after casualty.

(v) To contract for and employ persons, firms, corporations or other agents to assist in the management, operation, maintenance and administration of the Condominium project.

(vi) To own, maintain and improve, and to buy, operate, manage, sell, convey, assign, mortgage or lease (as landlord or tenant) any real or personal property (including Condominium units, easements, rights-of-way and licenses) on behalf of the Association in furtherance of any of the purposes of the Association.

(vii) To borrow money and issue evidences of indebtedness in furtherance of any and all of the purposes of the business of the Association and to secure the same by mortgage, pledge or other lien.

(viii) To make rules and regulations in accordance with Article VI, section 10 of these Bylaws.

(ix) To establish such committees as it deems necessary, convenient or desirable and to appoint

1399904

persons thereto for the purposes of implementing the administration of the Condominium and to delegate to such committees any functions or responsibilities.

(x) To make rules and regulations and to enter into agreements with institutional lenders the purposes of which are to obtain mortgage financing for unit Co-owners which is acceptable for purchase by the Federal Home Loan Mortgage Corporation, the Federal National Mortgage Association, the Government National Mortgage Association and/or any governmental agency or to satisfy the requirements of the United States Department of Housing and Urban Development.

(xi) To enforce the provisions of the Master Deed, these Bylaws, the Corporate Bylaws and the Articles of Incorporation.

(b) The Board of Directors may employ for the Association a professional management agent (which may include the Developer or any person or entity affiliated with the Developer) at reasonable compensation established by the Board to perform such duties and services as the Board shall authorize, including, but not limited to, the duties listed in section 4(a) of this Article 1, and the Board may delegate to such management agent any other duties or powers. In the event the Board does employ professional management for the Association, the Board shall secure the written approval of each institutional holder of a first mortgage lien on any unit in the Condominium prior to terminating professional management and assuming self management. In no event may the Board enter into any contract for management, the maximum term of which is greater than three years. In addition to the foregoing, any contract for management or other services by and between the Association and the Developer or any affiliate of the Developer shall provide that such contract is voidable by the Board of Directors of the Association on the Transitional Control Date or within ninety (90) days thereafter, and on thirty (30) days' notice at any time thereafter for cause. To the extent any management contract entered into before the Transitional Control Date extends beyond one year after the Transitional Control Date, the excess period under the contract may be voided by the Board of Directors of the Association by notice to the management agent at least thirty (30) days before the expiration of the one year period.

(c) All of the actions (including, without limitation, the adoption of these Bylaws and any Rules and

139997905

Regulations for the Association, and any undertakings or contracts entered into with others on behalf of the Association) of the first Board of Directors of the Association named in its Articles of Incorporation or any successors thereto appointed before the first annual meeting of Co-owners shall be binding upon the Association in the same manner as though such actions had been authorized by a Board of Directors duly elected by the Co-owners.

Section 5. The Corporate Bylaws shall provide for the designation, number, terms of office, qualifications, manner of election, duties, manner of removal and replacement of the officers of the Association and may contain any other provisions pertinent to officers of the Association. Officers shall not be compensated.

Section 6. The first annual meeting of the Co-owners may be convened only by the Developer and may be called, in the Developer's discretion, at any time on or before the earlier of the dates provided for the first annual meeting in subsections 7(b) and 7(c) of this Article 1. The date, time and place of such first annual meeting shall be set by the Board of Directors, and at least ten (10) days' written notice thereof shall be given to each Co-owner. Thereafter, an annual meeting shall be held each year on such date as is specified in the Corporate Bylaws.

Section 7. The following provisions shall apply notwithstanding the fact that the first annual meeting may not have been called:

(a) An advisory committee of nondeveloper Co-owners shall be established either one hundred twenty (120) days after conveyance of legal or equitable title to nondeveloper Co-owners of one-third (1/3) of the units that may be created, or one year after the initial conveyance of legal or equitable title to a nondeveloper Co-owner of a unit in the project, whichever occurs first. The advisory committee shall meet with the Board of Directors for the purpose of facilitating communication and aiding the transition of control to the association of Co-owners. The advisory committee shall cease to exist when a majority of the board of directors of the association of Co-owners is elected by the nondeveloper Co-owners.

(b) Not later than one hundred twenty (120) days after conveyance of legal or equitable title to nondeveloper Co-owners of twenty-five (25%) percent of the units that may be created, at least one director and not

LIBR 13999PG906

less than twenty-five (25%) percent of the board of directors shall be elected by nondeveloper Co-owners. Not later than one hundred twenty (120) days after conveyance of legal or equitable title to nondeveloper Co-owners of fifty (50%) percent of the units that may be created, not less than thirty-three and one-third (33 1/3%) percent of the board of directors shall be elected by nondeveloper Co-owners. Not later than one hundred twenty (120) days after conveyance of legal or equitable title to nondeveloper Co-owners of seventy-five (75%) percent of the units that may be created, and before conveyance of ninety (90%) percent of such units, the first annual meeting shall be called and the nondeveloper Co-owners shall elect all directors on the board, except that the Developer shall have the right to designate at least one director as long as the Developer owns and offers for sale at least ten (10%) percent of the units in the project or as long as ten (10%) percent of the units remain that may be created.

(c) Notwithstanding the formula provided in subsection (b), 54 months after the first conveyance of legal or equitable title to a nondeveloper Co-owner of a unit in the project, if title to not less than seventy-five (75%) percent of the units that may be created has not been conveyed, the first annual meeting shall be called and the nondeveloper Co-owners have the right to elect as provided in the Condominium Documents, a number of members of the board of directors equal to the percentage of units they hold, and the Developer has the right to elect, as provided in the Condominium Documents, a number of members of the board equal to the percentage of units which are owned by the Developer and for which all assessments are payable by the Developer. This election may increase, but shall not reduce, the minimum election and designation rights otherwise established in subsection (b). Application of this subsection does not require a change in the size of the board as determined in the Condominium Documents.

(d) If the calculation of the percentage of members of the board that the nondeveloper Co-owners have the right to elect under subsection (b), or if the product of the number of members of the board multiplied by the percentage of units held by the nondeveloper Co-owners under subsection (c) results in a right of nondeveloper Co-owners to elect a fractional number of members of the board, then a fractional election right of 0.5 or greater shall be rounded up to the nearest whole number, which number shall be the number of members of the board that the nondeveloper Co-owners have the right to elect. After application of this formula, the Developer shall have the right to elect

NUMBER 139991907

the remaining members of the board. Application of this subsection shall not eliminate the right of the Developer to designate one member as provided in subsection (b).

(e) As used in this section, the term "units that may be created" means the maximum number of units which may be included in the Condominium in accordance with any limitation stated in the Master Deed.

Section 8. Any reference to the "first Board of Directors" in the Master Deed, these Bylaws, the Corporate Bylaws, or the Articles of Incorporation shall mean and refer to the Board of Directors named in the Articles of Incorporation, including any successor or additional director appointed by the first board of directors prior to the first annual meeting of the Co-owners.

ARTICLE II

Section 1. The Association shall be assessed as the person or entity in possession of any tangible personal property of the Condominium owned or possessed in common by the Co-owners, and personal property taxes based thereon shall be treated as expenses of administration.

Section 2. Expenditures affecting administration of the Condominium shall include all costs incurred in satisfaction of any liability arising within, caused by or connected with the common elements or the administration of the Condominium. Receipts affecting administration of the Condominium shall include all sums received as proceeds of, or pursuant to, a policy of insurance securing the interests of the Co-owners against liabilities or losses arising within, caused by or connected with the common elements or the administration of the Condominium.

Section 3. The Board of Directors shall establish an annual budget in advance for each fiscal year and such budget shall project all expenses for the forthcoming year which may be required for the proper operation, management and maintenance of the Condominium, including a reasonable allowance for contingencies and reserves. Upon adoption of an annual budget by the Board of Directors, copies of the budget shall be delivered to each Co-owner and the assessment for the year shall be established based upon said budget. The Board of Directors of the Association may increase the assessment if the Board of Directors finds that the revenues of the Association are insufficient to pay costs of operation. Special assessments may be made by the Board of Directors from time to time for payment of any obligation of the Association. The

LIBER 13999-1908

Board of Directors shall maintain a reserve fund for major repairs and replacement of common elements, which reserve fund shall be in the amount of not less than ten (10%) percent of the Association's current annual budget (excluding that portion of the budget allocated to the reserve fund itself) on a noncumulative basis. The minimum standard required by this subsection may prove to be inadequate for the Condominium. The Board of Directors shall annually consider the needs of the Condominium to determine if a greater amount should be set aside in reserve or if additional reserve funds should be established for any other purposes.

Section 4. All assessments levied against the Co-owners to pay expenses of administration shall be apportioned among and paid by the Co-owners in accordance with the percentage of value allocated to each unit in the Master Deed, subject to any other assessment provisions in the Master Deed or these Bylaws. Notwithstanding any other provisions of the Condominium Documents to the contrary, the Developer shall not pay regular monthly assessments for units which are owned by the Developer and are unoccupied, but shall only reimburse the Association for actual expenses incurred by the Association which are reasonably allocable to such units. Annual assessments shall be payable by Co-owners in 12 equal monthly installments. The payment of an assessment shall be in default if such assessment, or any part thereof, is not paid to the Association in full on or before the due date for such payment. Assessments in default shall bear interest at the rate of seven (7%) percent per annum until paid in full. The Board of Directors may also adopt uniform late charges pursuant to section 10 of Article VI of these Bylaws. Each Co-owner (whether one or more persons) shall be personally liable for the payment of all assessments levied against the unit. A Co-owner selling a unit shall not be entitled to any refund whatsoever from the Association with respect to any reserve, account or other asset of the Association. Sums assessed to a Co-owner which are unpaid constitute a lien upon the unit or units in the Condominium owned by the Co-owner at the time of the assessment before other liens except tax liens on the Condominium unit in favor of any state or federal taxing authority and sums unpaid on the first mortgage of record, except that past due assessments which are evidenced by a notice of lien have priority over a first mortgage recorded subsequent to the recording of the notice of lien. The lien upon each Condominium unit owned by the Co-owner shall be in the amount assessed against the Condominium unit. The lien may be foreclosed by an action or by advertisement by the Association in the name of the Condominium on behalf of the other Co-owners.

LIBER 13999 PG 909

Section 5. No Co-owner shall be exempt from liability for contribution toward the expenses of administration by waiver of the use or enjoyment of any of the common elements or by the abandonment of a Condominium unit.

Section 6. The Association may enforce collection of delinquent assessments by a suit at law for a money judgment or by foreclosure of the statutory lien that secures payment of assessments. Each Co-owner, and every other person who from time to time has any interest in the Condominium, shall be deemed to have granted to the Association the unqualified right to elect to foreclose such lien either by judicial action or by advertisement. The provisions of Michigan law pertaining to foreclosure of mortgages by judicial action and by advertisement, as the same may be amended from time to time, are incorporated herein by reference for the purposes of establishing the alternative procedures to be followed in lien foreclosure actions and the rights and obligations of the parties to such actions. Further, each Co-owner and every other person who from time to time has any interest in the Condominium, shall be deemed to have authorized and empowered the Association to sell or to cause to be sold the unit with respect to which the assessment(s) is or are delinquent and to receive, hold and distribute the proceeds of such sale in accordance with the priorities established by Michigan law. The Association, acting on behalf of all Co-owners, may bid in at the foreclosure sale, and acquire, hold, lease, mortgage, or convey the Condominium unit. The expenses incurred in collecting unpaid assessments, including interest, costs, actual attorneys' fees (not limited to statutory fees) and advances for taxes or other liens paid by the Association to protect its lien, plus any late charges, shall be chargeable to the Co-owner in default and shall be secured by the lien on the unit. In the event of default by any Co-owner in the payment of any installment of the annual assessment, the Association shall have the right to declare all unpaid installments of the annual assessment for the pertinent fiscal year immediately due and payable. The Association may also discontinue the furnishing of any utilities or other services to a Co-owner in default upon seven (7) days' written notice to such Co-owner of its intention to do so. A Co-owner in default shall not be entitled to vote at any meeting of the Association so long as such default continues. In a judicial foreclosure action, a receiver may be appointed to take possession of the unit if the unit is not occupied by the Co-owner and to lease the Condominium unit and collect and apply the rental therefrom.

Section 7. Notwithstanding any other provisions of the Master Deed, these Bylaws, the Corporate Bylaws or Articles of Incorporation of the Association, if the mortgagee of a first

LIBER 13999 PD 910

mortgage of record or other purchaser of a Condominium unit obtains title to the Condominium unit as a result of foreclosure of the first mortgage, such person, its successors and assigns, is not liable for the assessments by the Association chargeable to the unit which became due prior to the acquisition of title to the unit by such person and the expiration of the period of redemption from such foreclosure. The unpaid assessments are deemed to be common expenses collectible from all of the Condominium unit owners including such persons, its successors and assigns.

Section 8. The Association may not commence proceedings to foreclose a lien for unpaid assessments without recording and serving a notice of lien in the following manner:

(a) The notice of lien shall set forth the legal description of the Condominium unit or units to which the lien attaches, the name of the Co-owner of record thereof, the amount due the Association as of the date of the notice, exclusive of interest, costs, attorneys fees and future assessments.

(b) The notice of lien shall be in recordable form, executed by an authorized representative of the Association, and may contain such other information as the Association deems appropriate.

(c) The notice of lien shall be recorded in the office of the register of deeds in the county in which the Condominium is situated and shall be served upon the delinquent Co-owner by first class mail, postage prepaid, addressed to the last known address of the Co-owner at least ten (10) days in advance of the commencement of the foreclosure proceedings.

Section 9. Upon the sale or conveyance of a Condominium unit, all unpaid assessments against the Condominium unit shall be paid out of the sale price or by the purchaser in preference over any other assessments or charges of whatever nature except (a) amounts due the State of Michigan or any subdivision thereof for taxes or special assessments due and unpaid on the unit and (b) payments due under first mortgages having priority thereto. A purchaser of a Condominium unit is entitled to a written statement from the Association setting forth the amount of unpaid assessments outstanding against the unit and the purchaser is not liable for any unpaid assessment in excess of the amount set forth in such written statement, nor shall the unit be subject to any lien for any amounts in excess of the amount set forth in the written statement. Any purchaser or grantee who fails to request a written statement from the

LIBER 13999-911

Association as provided herein at least five days before the sale shall be liable for any unpaid assessments against the unit together with interest, costs and attorneys' fees incurred in connection with the collection thereof.

ARTICLE III

Actions on behalf of and against the Co-owners shall be brought in the name of the Association. The Association may assert, defend or settle claims on behalf of all Co-owners in connection with the common elements of the Condominium. The commencement of any such civil action (other than one to enforce or collect delinquent assessments) shall require the approval of a majority in value of the Co-owners.

ARTICLE IV

Section 1. The Association shall carry fire and extended coverage, vandalism and malicious mischief and liability insurance, and workers' compensation insurance, if applicable, pertinent to the ownership, use and maintenance of the common elements of the Condominium, and such other insurance as the Board of Directors deems advisable, and all such insurance shall be carried and administered in accordance with the following provisions:

(a) All such insurance shall be purchased by the Association for the benefit of the Association, and the Co-owners and their mortgagees, as their interests may appear, and provision shall be made for the issuance of certificates of mortgagee endorsements to the mortgagees of Co-owners. Co-owners may obtain additional insurance upon their units, at their own expense, in addition to the coverage carried by the Association. It shall be each Co-owner's responsibility to obtain insurance coverage for personal property located within a unit or elsewhere in the Condominium and for personal liability for occurrences within a unit or upon limited common elements appurtenant to a unit and also for alternative living expense in event of fire, and the Association shall have absolutely no responsibility for obtaining such coverages. The Association and all Co-owners shall use their best efforts to obtain property and liability insurance containing appropriate provisions whereby the insurer waives its right of subrogation as to any claims against any Co-owner or the Association.

13999/912

(b) All common elements of the Condominium shall be insured against fire and other perils covered by a standard extended coverage endorsement, in an amount equal to the appropriate percentage of maximum insurable replacement value, excluding foundation and excavation costs, as determined annually by the Board of Directors of the Association. Such coverage shall also include interior walls within any unit and the pipes, wires, conduits and ducts contained therein and shall further include all fixtures, equipment and trim within a unit which were furnished with the unit, or such replacements or such improvements made by a Co-owner within a unit. Any other improvements made by a Co-owner within a unit shall be covered by insurance obtained by and at the expense of said Co-owner; provided that, if the Association elects to include such improvements under its insurance coverage, any additional premium cost to the Association attributable thereto may be assessed to and borne solely by said Co-owner and collected as part of the assessments against said Co-owner under Article II hereof.

(c) All premiums for insurance purchased by the Association pursuant to these Bylaws shall be expenses of administration.

(d) Proceeds of all insurance policies owned by the Association shall be received by the Association, held in a separate account and distributed to the Association, the Co-owners and their mortgagees as their interests may appear; provided, however, whenever repair or reconstruction of the Condominium shall be required as provided in Article V of these Bylaws, the proceeds of any insurance received by the Association as a result of any loss requiring repair or reconstruction shall be applied for such repair or reconstruction, and in no event shall hazard insurance proceeds be used for any purpose other than for repair, replacement or reconstruction of the Condominium unless all of the institutional holders of first mortgages on units in the Condominium have given their prior written approval.

Section 2. Each Co-owner, by ownership of a unit in the Condominium shall be deemed to appoint the Association as the Co-owner's true and lawful attorney-in-fact to act in connection with all matters concerning the maintenance of fire and extended coverage, vandalism and malicious mischief, liability insurance and workmen's compensation insurance, if applicable, pertinent to the Condominium, the Co-owner's unit and the common elements appurtenant thereto with such insurer as may, from time to time, provide such insurance for the

LIBER 139997913

Condominium. Without limitation on the generality of the foregoing, the Association as said attorney shall have full power and authority to purchase and maintain such insurance, to collect and remit premiums therefor, to collect proceeds and to distribute the same to the Association, the Co-owners and respective mortgagees, as their interests may appear (subject always to the provisions of the Master Deed and these Bylaws), to execute releases of liability and to execute all documents and to do all things on behalf of such Co-owner and the Condominium as shall be necessary or convenient to the accomplishment of the foregoing.

ARTICLE V

Section 1. If any part of the Condominium shall be partially or completely destroyed, the determination of whether or not it shall be reconstructed or repaired shall be made in the following manner:

(a) If the damaged property is a common element or a unit, the property shall be rebuilt or repaired if any unit in the Condominium is tenantable, unless it is determined by a unanimous vote of all of the Co-owners in the Condominium that the Condominium shall be terminated, and each institutional holder of a first mortgage lien on any unit in the Condominium has given prior written approval of such termination.

(b) If the Condominium is so damaged that no unit is tenantable, and if each institutional holder of a first mortgage lien on any unit in the Condominium has given its prior written approval of the termination of the Condominium, the damaged property shall not be rebuilt and the Condominium shall be terminated, unless seventy-five (75%) percent or more of all Co-owners in value agree to reconstruction by vote or in writing within ninety (90) days after the destruction.

Section 2. Any such reconstruction or repair shall be substantially in accordance with the Master Deed and the plans and specifications for the Condominium to a condition as comparable as possible to the condition existing prior to damage unless the Co-owners shall unanimously decide otherwise.

Section 3. If the damage is only to a part of a unit which is the responsibility of a Co-owner to maintain and repair, it shall be the responsibility of the Co-owner to repair such damage in accordance with section 4 hereof. In all other cases, the responsibility for reconstruction and repair shall be that of the Association.

LIBER 13997914

Section 4. Each Co-owner shall be responsible for the reconstruction and repair of the interior of the Co-owner's unit, including, but not limited to, floor coverings, wall coverings, window shades, draperies, interior walls (but not any common elements therein), interior trim, furniture, light fixtures and all appliances, whether free standing or built-in. In the event damage to any of the foregoing, or to interior walls within a Co-owner's unit or to pipes, wires, conduits, ducts or other common elements therein is covered by insurance held by the Association, then the reconstruction or repair shall be the responsibility of the Association in accordance with section 5 of this Article. If any other interior portion of a unit is covered by insurance held by the Association for the benefit of the Co-owner, the Co-owner shall be entitled to receive the proceeds of insurance relative thereto, and if there is a mortgagee endorsement, the proceeds shall be payable to the Co-owner and the mortgagee jointly. In the event of substantial damage to or destruction of any unit or any part of the common elements, the Association promptly shall so notify each institutional holder of a first mortgage lien on any unit in the Condominium.

Section 5. The Association shall be responsible for the reconstruction and repair of the common elements (except as specifically otherwise provided in the Master Deed) and any incidental damage to a unit caused by such common elements or the reconstruction and repair thereof. Immediately after a casualty causing damage to property for which the Association has the responsibility of repair and reconstruction, the Association shall obtain reliable and detailed estimates of the cost to replace the damaged property in a condition as good as that existing before the damage. If the proceeds of insurance are not sufficient to defray the estimated costs of reconstruction or repair required to be performed by the Association, or if at any time during such reconstruction or repair, or upon completion of such reconstruction or repair, the funds for the repayment of the costs thereof are insufficient, assessments shall be made against all Co-owners for the cost of reconstruction or repair of the damaged property in sufficient amounts to provide funds to pay the estimated or actual cost of repair.

Section 6. The following provisions shall apply upon any taking by eminent domain of any part of the Condominium:

(a) If any portion of the common elements is taken by eminent domain, the award therefor shall be allocated to the Co-owners in proportion to their respective undivided interests in the common elements. The Association, acting through its Board of Directors, may negotiate on behalf of

LIBER 13999 915

all Co-owners for any taking of common elements and any negotiated settlement approved by more than two-thirds (2/3) of the Co-owners based upon assigned voting rights shall be binding on all Co-owners.

(b) If a Condominium unit is taken by eminent domain, the undivided interest in the common elements appertaining to the Condominium unit shall thenceforth appertain to the remaining Condominium units, being allocated to them in proportion to their respective undivided interests in the common elements. The court shall enter a decree reflecting the reallocation of undivided interests produced thereby, and the award shall include, without limitation, just compensation to the Co-owner of the Condominium unit taken for the Co-owner's undivided interest in the common elements as well as for the Condominium unit.

(c) If portions of a Condominium unit are taken by eminent domain, the court shall determine the fair market value of the portions of the Condominium unit not taken. The undivided interest of such Condominium unit in the common elements appertaining to the Condominium units shall be reduced in proportion to the diminution in the fair market value of the Condominium unit resulting from the taking. The portions of undivided interest in the common elements thereby divested from the Co-owners of a Condominium unit shall be reallocated among the other Condominium units in the Condominium project in proportion to their respective undivided interests in the common elements. A Condominium unit partially taken shall receive the reallocation in proportion to its undivided interest in the common elements as reduced by the court under this subsection. The court shall enter a decree reflecting the reallocation of undivided interests produced thereby, and the award shall include just compensation to the Co-owner of the Condominium unit partially taken for that portion of the undivided interest in the common elements divested from the Co-owner and not revested in the Co-owner, as well as for that portion of the Condominium unit taken by eminent domain.

(d) If the taking of a portion of a Condominium unit makes it impractical to use the remaining portion of that Condominium unit for a lawful purpose permitted by the Condominium documents, then the entire undivided interest in the common elements appertaining to that Condominium unit shall thenceforth appertain to the remaining Condominium units, being allocated to them in proportion to their respective undivided interests in the common

1399916

elements. The remaining portion of that Condominium unit shall thenceforth be a common element. The court shall enter an order reflecting the reallocation of undivided interests produced thereby, and the award shall include just compensation to the Co-owner of the Condominium unit for the Co-owner's entire undivided interest in the common elements and for the entire Condominium unit.

(e) Votes in the Association of Co-owners and liability for future expenses of administration appertaining to a Condominium unit taken or partially taken by eminent domain shall thenceforth appertain to the remaining Condominium units, being allocated to them in proportion to the relative voting strength in the Association of Co-owners. A Condominium unit partially taken shall receive a reallocation as though the voting strength in the Association of Co-owners was reduced in proportion to the reduction in the undivided interests in the common elements.

(f) In the event the Condominium continues after a taking by eminent domain, then the remaining portion of the Condominium shall be re-surveyed and the Master Deed amended accordingly. Such amendment may be effected by an officer of the Association duly authorized by the Board of Directors without the necessity of execution or specific approval thereof by any Co-owner, but only with the prior written approval of all holders of first mortgage liens on individual units in the Condominium.

(g) In the event any unit in the Condominium, or any portion thereof, or the common elements or any portion thereof, is made the subject matter of any condemnation or eminent domain proceeding or is otherwise sought to be acquired by a condemning authority, the Association promptly shall so notify each institutional holder of a first mortgage lien on any of the units in the Condominium.

Section 7. In the event any mortgage in the Condominium is held by the Federal Home Loan Mortgage Corporation ("FHLMC"), or in the event any mortgage is held by or insured by the United States Department of Housing and Urban Development ("HUD"), the Association shall give FHLMC and HUD written notice at such address as it may from time to time direct of any loss to or taking of the common elements of the Condominium, or any loss to or taking of any unit, or part thereof, if the loss or taking exceeds \$10,000 in amount.

Section 8. Nothing contained in the Condominium Documents shall be construed to give a Co-owner or any other party

LIBER 13999 917

priority over any rights of first mortgagees of Condominium units pursuant to their mortgages in the case of a distribution to Condominium unit owners of insurance proceeds or condemnation awards for losses to or a taking of Condominium units and/or common elements.

ARTICLE VI

Section 1. No Unit shall be used for other than residential purposes. No Co-owner shall carry on any commercial activities anywhere on the premises of the Condominium. Developer may conduct the activities permitted in section 15 of this Article.

Section 2. No Co-owner shall make alterations in exterior appearance or make structural modifications to any unit (including interior walls through or in which there exist easements for support or utilities) or make changes in any of the common elements, limited or general, without the express written approval of the Board of Directors including but not limited to, exterior painting or the erection of antennas, lights, aerials, awnings, doors, shutters or other exterior attachments or modifications; nor shall any Co-owner damage or make modifications or attachments to common element walls between units which in any way impair sound conditioning qualities of the walls. The Board of Directors may approve only such modifications as do not impair the soundness, safety, utility or appearance of the Condominium.

Section 3. No immoral, improper, unlawful or offensive activity shall be carried on in any unit or upon the common elements, limited or general; nor shall anything be done which may be or become an annoyance or nuisance to the Co-owners of the Condominium, nor shall any unreasonably noisy activity be carried on in any unit or on the common elements. No Co-owner shall do or permit anything to be done or to keep or permit to be kept in the Co-owner's unit or on the common elements anything that will increase the rate of insurance on the Condominium without the written approval of the Board of Directors, and each Co-owner shall pay to the Association the increased cost of insurance premiums resulting from any such activity or the maintenance of any such condition.

Section 4. Without the prior written consent of the Board of Directors, no animal or pet other than one cat or one dog shall be kept in the Condominium by any Co-owner. Any pets kept in the Condominium shall have such care and restraint as not to be obnoxious on account of noise, odor or unsanitary conditions. No savage or dangerous animal shall be kept. No

LIBR 13999 P 918

animal may be permitted to run loose upon the common elements, and any animal shall at all times be attended by a responsible person while on the common elements. Any person who causes or permits an animal to be brought or kept on the Condominium property shall indemnify and hold harmless the Association for any loss, damage or liability which the Association may sustain as a result of the presence of such animal on the Condominium property. The term "animal or pet" as used in this section shall not include small animals which are constantly caged such as small birds or fish. All pets must be registered with the Board of Directors of the Association.

Section 5. The common elements, limited or general, shall not be used for storage of supplies, materials, personal property or trash or refuse of any kind, except as provided in the Master Deed or in duly adopted rules and regulations of the Association. Trash receptacles shall be maintained in areas designated therefor at all times and shall not be permitted to remain elsewhere on the common elements except for such short periods of time as may be reasonably necessary to permit periodic collection of trash. The common elements shall not be used in any way for the drying, shaking, or airing of clothing or other fabrics. Automobiles may only be washed in areas approved by the Board of Directors. In general, no activity shall be carried on nor condition maintained by a Co-owner, either in a unit or upon the common elements, which detracts from the appearance of the Condominium.

Section 6. Each driveway leading into a garage or carport may only be used by the Co-owner entitled to use the garage or carport. The common elements shall not be obstructed in any way; nor shall they be used for purposes other than for which they are reasonably and obviously intended. No bicycles, vehicles, chairs or benches may be left unattended on or about the common elements. Use of all general common elements may be limited to such times and in such manner as the Board of Directors shall determine by duly adopted regulations.

Section 7. No house trailers, commercial vehicles, boat trailers, boats, camping vehicles, camping trailers, snowmobiles, snowmobile trailers or vehicles other than automobiles may be parked or stored upon the common elements of the Condominium, unless parked in an area specifically designated therefor by the Board of Directors.

Section 8. No Co-owner shall use, or permit the use by any occupant, agent, employee, invitee, guest or member of his or her family of any firearms, air rifles, pellet guns, B-B guns, bows and arrows, sling shots, or other similar weapons, projectiles or devices anywhere on or about the Condominium.

139997919

Section 9. No signs or other advertising devices shall be displayed which are visible from the exterior of a unit or on the common elements, including "For Sale" signs, without written permission from the Board of Directors.

Section 10. Reasonable regulations consistent with all laws and the Condominium Documents concerning the use of the common elements or the rights and responsibilities of the Co-owners and the Association with respect to the Condominium or the manner of operation of the Association and of the Condominium may be made and amended from time to time by the Board of Directors. Copies of all such regulations and amendments thereto shall be furnished to all Co-owners or posted on a general common element. Any such regulation or amendment may be revoked at any time by the affirmative vote of a majority of the Co-owners.

Section 11. The Association and its duly authorized agents shall have access to each unit and any limited common elements appurtenant thereto from time to time, during reasonable working hours, upon notice to the Co-owner thereof, as may be necessary for the maintenance, repair or replacement of any of the common elements. The Association or its agent shall also have access to each unit and any limited common elements appurtenant thereto at all times without notice as may be necessary to make emergency repairs to prevent damage to the common elements or to another unit. It shall be the responsibility of each Co-owner to provide the Association means of access to the Co-owner's unit and any limited common elements appurtenant thereto during all periods of absence and in the event of the failure of such Co-owner to provide means of access, the Association may gain access in such manner as may be reasonable under the circumstances and shall not be liable to such Co-owner for any necessary damage to any unit or any limited common elements appurtenant thereto caused thereby or for repair or replacement of such damage.

Section 12. No Co-owner shall perform any landscaping or plant any trees or shrubs or place any ornamental materials upon the common elements other than the private court yards, if any, unless approved by the Board of Directors in writing or unless permitted by the master deed or the regulations of the Association.

Section 13. No unsightly condition shall be maintained upon any patio or porch and only furniture and equipment consistent with ordinary patio or porch use shall be permitted to remain there during seasons when the same are reasonably in use and no furniture or equipment of any kind shall be stored on patios or porches during seasons when the same are not reasonably in use.

LIBER 13999 PG 920

Section 14. Each Co-owner shall maintain the unit owned and any limited common elements appurtenant thereto for which the Co-owner has maintenance responsibility in a safe, clean and sanitary condition. Each Co-owner shall also use due care to avoid damaging any of the common elements including but not limited to the telephone, water, gas, plumbing, electrical or other utility conduits and systems and any other elements in any unit which are appurtenant to or which may affect any other unit. Each Co-owner shall be responsible for damages or costs to the Association resulting from negligent damage to or misuse of any of the common elements by the Co-owner or the Co-owner's family, guests, agents or invitees, unless such damages or costs are covered by insurance carried by the Association in which case there shall be no such responsibility, unless reimbursement to the Association is excluded by virtue of a deductible provision, in which case the responsible Co-owner shall bear the expense to the extent of the deductible amount. Any costs or damages to the Association may be assessed to and collected from the responsible Co-owner in the manner provided in Article II hereof.

Section 15. None of the restrictions contained in this Article VI shall apply to the commercial activities or signs of the Developer as long as Developer owns any unit which Developer offers for sale, or of the Association in furtherance of its powers and purposes. Until all units in the entire planned Condominium are sold by Developer, Developer shall have the right to maintain a sales office, a business office, a construction office, model units, storage areas, reasonable parking incident to the foregoing and such access to, from and over the Condominium as may be reasonable to enable sale of the entire Condominium by Developer.

Section 16. Co-owners, including Developer, may rent any number of units at any time for any term of occupancy not less than 30 days subject to the following:

(a) A Co-owner, including the Developer, desiring to rent or lease a Condominium unit for a period of longer than thirty (30) consecutive days, shall disclose that fact in writing to the Association of Co-owners at least ten (10) days before presenting a lease form to a potential lessee, and at the same time, shall supply the Association of Co-owners with a copy of the exact lease form for its review for its compliance with the Condominium Documents. If Developer proposes to rent Condominium units before the Transitional control Date Developer shall notify either the advisory committee or each Co-owner in writing.

LIPER 139990921

(b) Tenants or nonco-owner occupants shall comply with all of the conditions of the Condominium Documents of the Condominium project, and all leases and rental agreements shall so state.

(c) If the Association determines that the tenant or nonco-owner occupant failed to comply with the conditions of the Condominium Documents, the Association shall take the following action:

(i) The Association shall notify the Co-owner by certified mail, advising of the alleged violation by the tenant. The Co-owner shall have fifteen (15) days after receipt of the notice to investigate and correct the alleged breach by the tenant or advise the Association that a violation has not occurred.

(ii) If after fifteen (15) days the Association believes that the alleged breach is not cured or may be repeated, it may institute on its behalf or derivatively by the Co-owners on behalf of the Association, if it is under the control of the Developer, an action for both eviction against the tenant or nonco-owner occupant and simultaneously, for money damages against the Co-owner and tenant or nonco-owner occupant for breach of the conditions of the Condominium Documents. The relief provided for in this section may be by summary proceeding. The Association may hold both the tenant and the Co-owner liable for any damages to the general common elements caused by the Co-owner or tenant in connection with the Condominium unit or the Condominium.

(d) When a Co-owner is in arrearage to the Association for assessments, the Association may give written notice of the arrearage to a tenant occupying a Co-owner's Condominium unit under a lease or rental agreement, and the tenant, after receiving the notice, shall deduct from rental payments due the Co-owner the arrearage and future assessments as they fall due and pay them to the Association. The deduction shall not constitute a breach of the rental agreement or lease by the tenant.

ARTICLE VII

Section 1. Any Co-owner who mortgages a unit shall notify the Association of the name and address of the mortgagee, and the Association shall maintain such information in a book

LIBER 13999 PG 922

maintained solely for such information. The Association may, at the written request of the mortgagee of any unit, report any unpaid assessments due from the Co-owner of such unit. The Association shall give to the holder of any first mortgage covering any unit in the Condominium written notification of any default in the performance of the obligations of the Co-owner of such unit that is not cured within 60 days.

Section 2. The Association shall notify each mortgagee appearing in said book of the name of each insurer insuring the Condominium against fire, perils covered by extended coverage, and vandalism and malicious mischief and the amounts of such coverage.

Section 3. Upon request submitted to the Association, any institutional holder of a first mortgage lien on any unit in the Condominium shall be entitled to receive written notification of every meeting of the members of the Association and to designate a representative to attend such meeting.

ARTICLE VIII

These Bylaws may be amended by the Association or by the Developer in the manner provided in the Master Deed. Any amendment to these Bylaws (but not the Corporate Bylaws) shall become effective upon recordation in the office of the register of deeds in the county in which the Condominium is located. A copy of each amendment to these Bylaws shall be made available to every member of the Association after adoption; provided, however, that any amendment is adopted in accordance with this Article shall be binding upon all persons who have an interest in the Condominium irrespective of whether such persons actually receive a copy of the amendment. These Bylaws may not be amended in any manner to eliminate or conflict with any mandatory provision of the Act or any applicable law or any provision of the Master Deed; nor may they be amended to materially reduce or eliminate the rights of any first mortgagees without the consent of the mortgagees affected.

ARTICLE IX

Section 1. The Association and all persons acquiring an interest in or using the Condominium are subject to the provisions of the Condominium Documents and regulations of the Association.

Section 2. Any default by a Co-owner shall entitle the Association or another Co-owner or Co-owners the following relief:

LIDER 13999PG923

(a) Failure to comply with any of the terms or provisions of the Condominium Documents or the regulations of the Association shall be grounds for relief, which may include without limitation an action to recover sums due for damages, injunctive relief, foreclosure of lien (if default in payment of assessment) or any combination thereof, and such relief may be sought by the Association, or, if appropriate, by an aggrieved Co-owner or Co-owners.

(b) In any proceeding arising because of an alleged default by any Co-owner, the Association, if successful, shall be entitled to recover the costs of the proceeding and such reasonable attorneys' fees (not limited to statutory fees) as may be determined by the Court.

Section 3. The failure of the Association or of any Co-owner to enforce any right, provision, covenant or condition which may be granted by the Condominium Documents or regulations of the Association shall not constitute a waiver of the right of the Association or of any such Co-owner to enforce such right, provision, covenant or condition in the future.

Section 4. Every director and every officer of the Association shall be indemnified by the Association against all expenses and liabilities, including attorney fees, reasonably incurred by or imposed upon the director or officer in connection with any proceeding to which the director or officer may be a party, or may become involved, by reason of the director or officer being or having been a director or officer of the corporation, whether or not a director or officer at the time such expenses are incurred, except that this indemnification shall not apply to willful and wanton misconduct or acts of gross negligence. The foregoing indemnification shall be in addition to and not exclusive of all other rights to which such director or officer may be which it has approved, the Board of Directors shall notify all Co-owners. Such payment must be approved by a majority vote of the Board of Directors without the vote of the director seeking the indemnification. In the event there has been no judicial determination whether the conduct of the director constituted negligence, the Board of Directors may rely upon an opinion of counsel, which counsel may not be a member of the Association.

ARTICLE X

The provisions in this Article X are adopted to meet certain requirements of the Federal Home Loan Mortgage Corporation and supersede any contrary provision of the Master Deed or the Condominium Bylaws:

LIBER 13999 PG 924

Section 1. Except as provided by statute, in case of condemnation or substantial loss to the units and/or common elements of the Condominium, unless at least two-thirds of the first mortgagees (based on one vote for each first mortgage owned), or owners (other than the Developer) of the individual Condominium units have given their prior written approval, the Association may not:

(a) by act or omission seek to abandon or terminate the Condominium;

(b) change the pro rata interest or obligations of any Condominium unit in order to: (i) levy assessments or charges, (ii) allocate distribution of hazard insurance proceeds or condemnation awards, or (iii) determine the pro rata share of ownership of each Condominium unit in the common elements;

(c) partition or subdivide any Condominium units;

(d) seek to abandon, partition, subdivide, encumber, sell, or transfer the common elements by act or omission. The granting of easements for public utilities or other public purposes consistent with the intended use of the common elements by the Condominium is not a transfer within the meaning of this clause; and


(e) use hazard insurance proceeds for losses to any Condominium property (whether units or common elements) for other than the repair, replacement, or reconstruction of the Condominium property.

Section 2. All taxes, assessments, and charges that may become liens prior to the first mortgage under local law relate only to the individual Condominium units and not to the Condominium as a whole.

Section 3. Any agreement for professional management of the Condominium, or any other contract providing for services of the Developer may not exceed three years. Any such agreement must provide for termination by either party without cause and without payment of a termination fee on 90 days or less written notice.


A5730g

LISEA 13999/0926

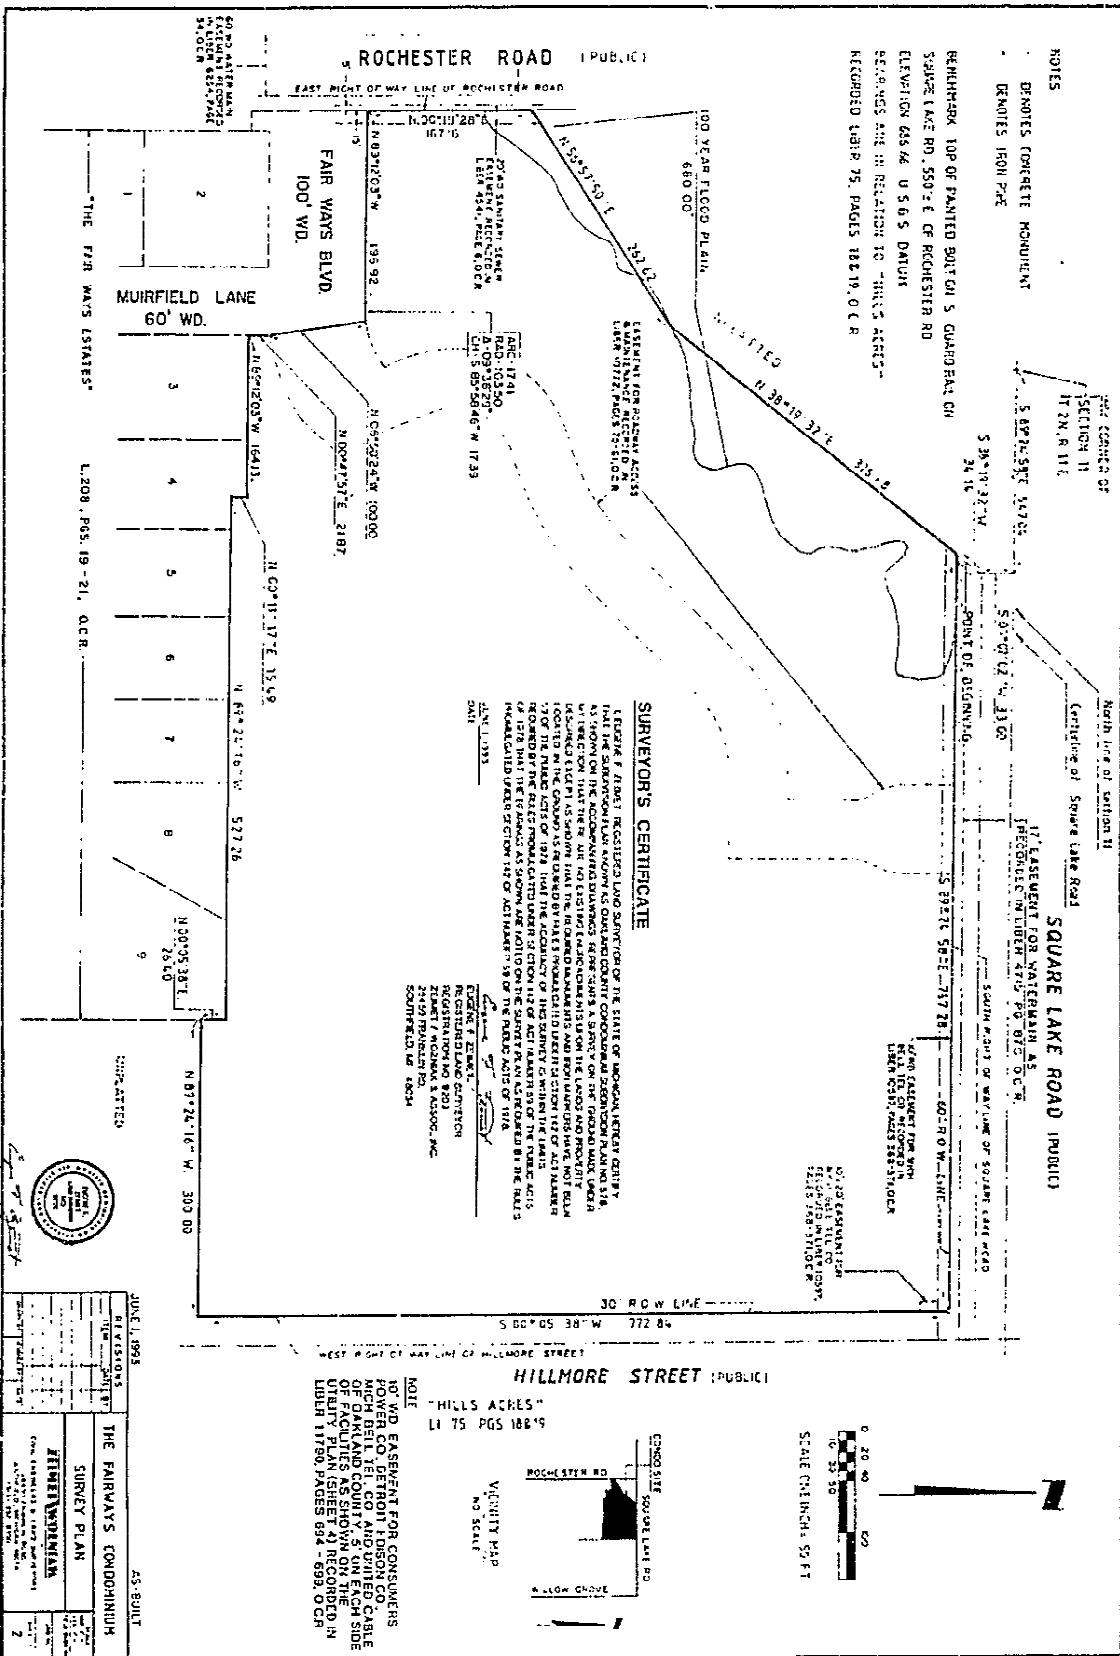

LIBER 13999/927

ROCHESTER ROAD (PUBLIC)

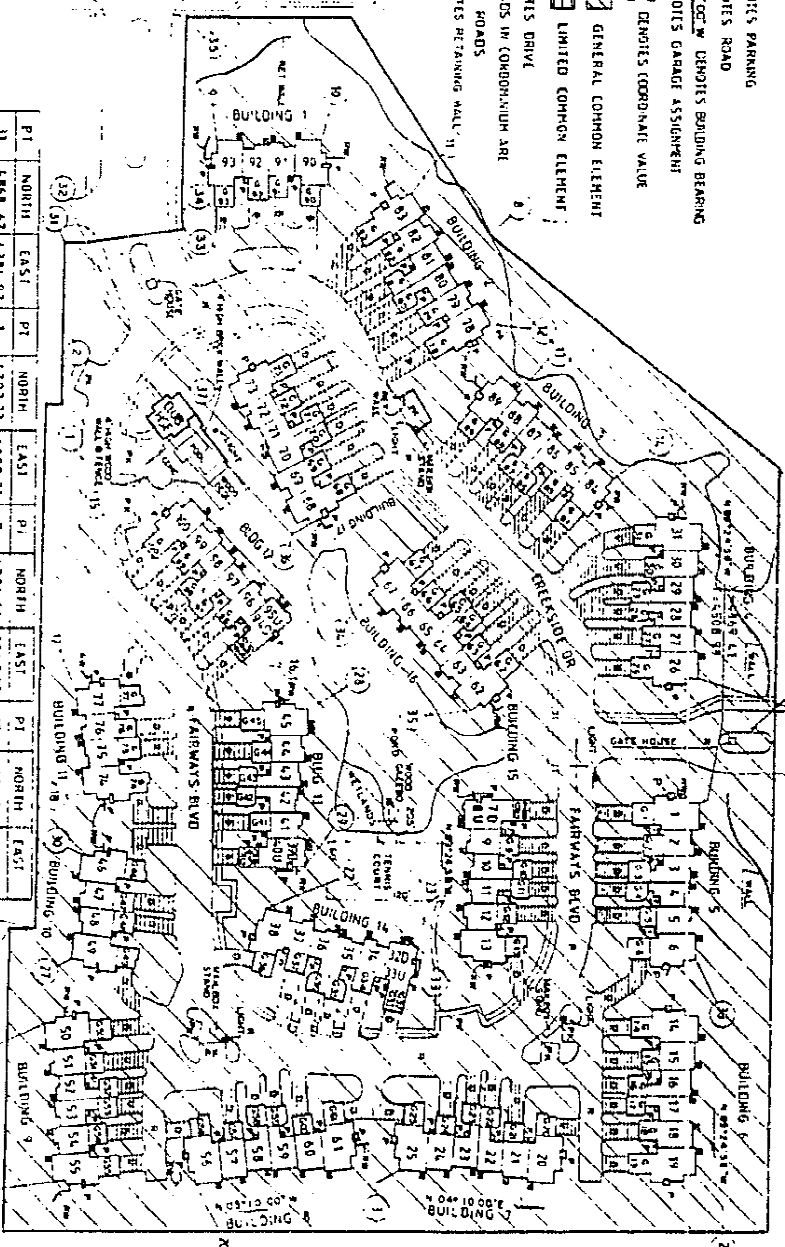


- NOTE
- 2 DENOTES UNIT NUMBER
 - DENOTES CONCRETE MONUMENT
 - DENOTES IRON PIPE
 - DENOTES AIR CONDITIONING COMPRESSOR/LIMITED COMMON ELEMENT
 - P DENOTES PORCH
 - PK DENOTES PARKING
 - R DENOTES ROAD
 - N, N. 1/2, S. 1/2 DENOTES BUILDING BEARING
 - B, B. 1 DENOTES GARAGE ASSIGNMENT
 - 44,000.00 DENOTES COORDINATE VALUE
 - Y4,000.00

NOTE EASEMENT FOR HIGHWAY AND FORESS FOR MAINTENANCE OF THE MAIN PAVED ROAD SURFACES GRANTED TO THE CITY OF TROY SAID EASEMENT EXCLUDES AREAS LOCATED IN MAIN ROADS (2)

SQUARE LAKE ROAD (PUBLIC)

HILLMORE STREET (PUBLIC)

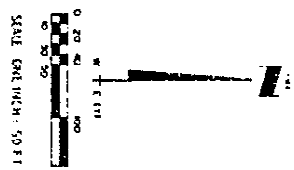

PT	NORTH	EAST
31	4219.99	3984.17
32	4241.06	3984.47
33	4340.67	3979.11
34	4339.45	3911.06
35	4342.20	3748.06

NOTES
 REFER TO PRINTER PLANS FOR LOCATION OF LIMITED COMMON ELEMENT PORCHES, DECKS AND SIDEWALKS
 RU DENOTES SECOND FLOOR PLAN
 7D DENOTES FIRST FLOOR PLAN



PT	NORTH	EAST	PT	NORTH	EAST	PT	NORTH	EAST	PT	NORTH	EAST

JUNE 1, 1993


THE FAIRWAYS CONDOMINIUM

SITE PLAN



LIBER 139990928

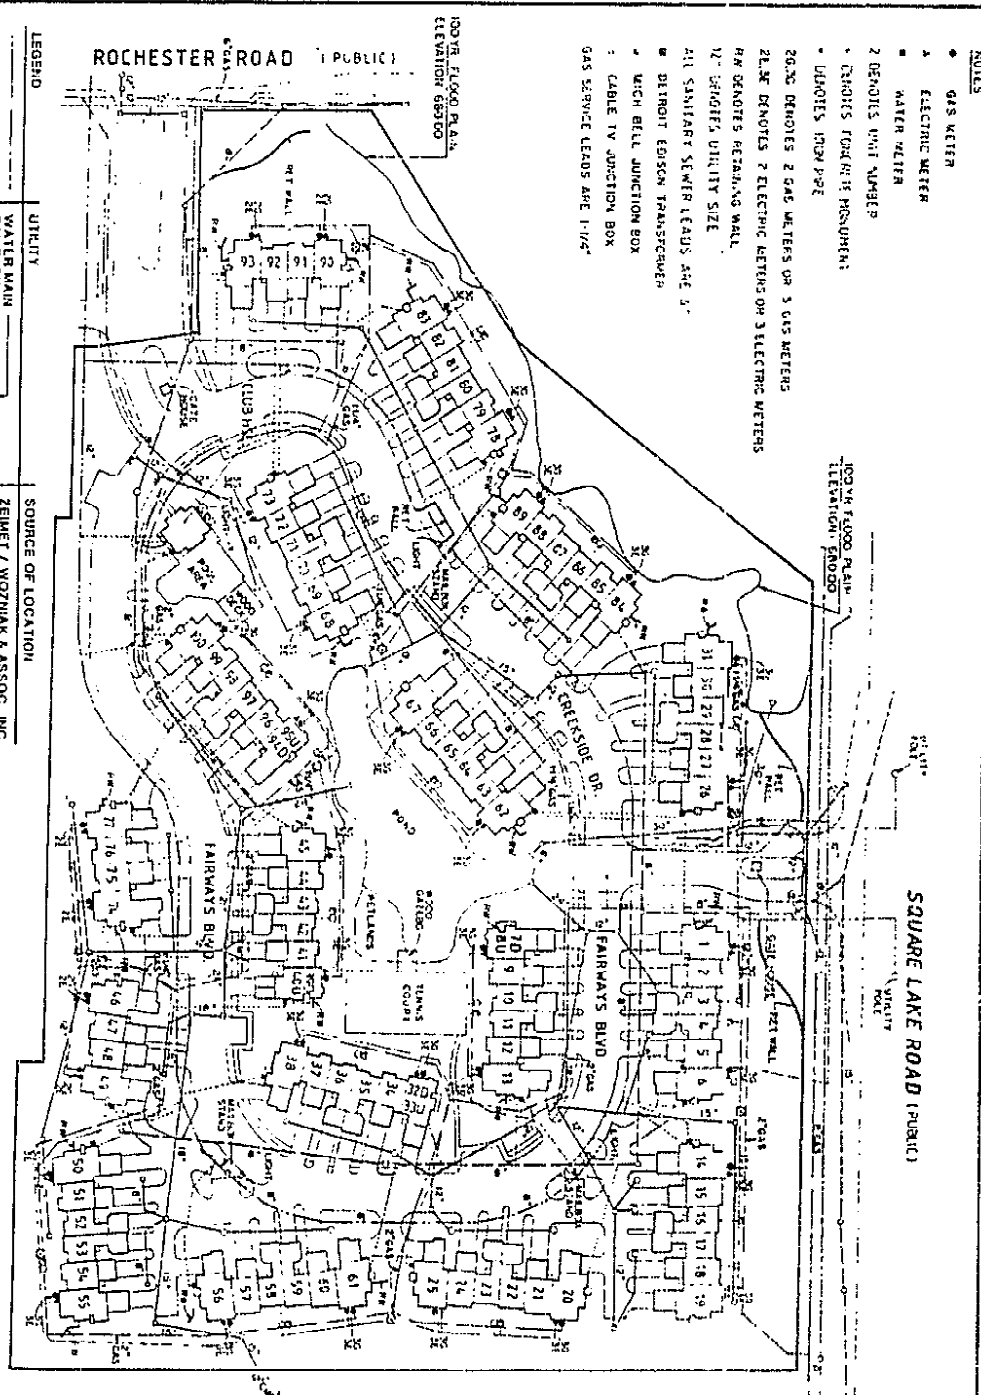

NOTES


- ◆ GAS METER
- ▲ ELECTRIC METER
- WATER METER
- 2 DENOTES UNIT NUMBER
- 20, 20 DENOTES 2 GAS METERS OR 3 GAS METERS
- 2L, 2R DENOTES 2 ELECTRIC METERS OR 3 ELECTRIC METERS
- AW DENOTES RETAINING WALL
- 12" DENOTES UTILITY SIZE
- ALL SANITARY SEWER LEADS ARE 3"
- DETROIT EDISON TRANSMISSION
- WICH BILL JUNCTION BOX
- CABLE TV JUNCTION BOX
- GAS SERVICE LEADS ARE 1-1/2"

LEGEND

UTILITY	SOURCE OF LOCATION
WATER MAIN	ZEMMET / WOZNIAK & ASSOC., INC.
WATER SEWER	ZEMMET / WOZNIAK & ASSOC., INC.
STORM SEWER	ZEMMET / WOZNIAK & ASSOC., INC.
SERVICE LEAD	ZEMMET / WOZNIAK & ASSOC., INC.
GAS	CONSUMERS POWER
TELEPHONE	MONTROSE TELEPHONE CO.
ELECTRIC	DETROIT EDISON CO.
CABLE TV	UNITED CABLE OF OAKLAND COUNTY
TELEPHONE, ELECTRIC & CABLE TV	

HILLMORE STREET (PUBLIC)

NOTES
 EACH BUILDING HAS ONE (1) WATER METER FOR ALL UNITS CONTAINED WITHIN LOCATED AS SHOWN.
 GAS & ELECTRIC METERS ARE IN GROUPS ON EACH BUILDING AS SHOWN. (2) LOCATED ON UNIT CONTAINED WITHIN

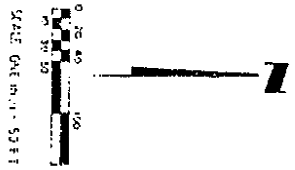

DATE: 1/19/93


AS-BUILT

REVISIONS	DATE	BY	DESCRIPTION


THE FAIRWAYS CONDOMINIUM
 UTILITY PLAN
ZEMMET / WOZNIAK



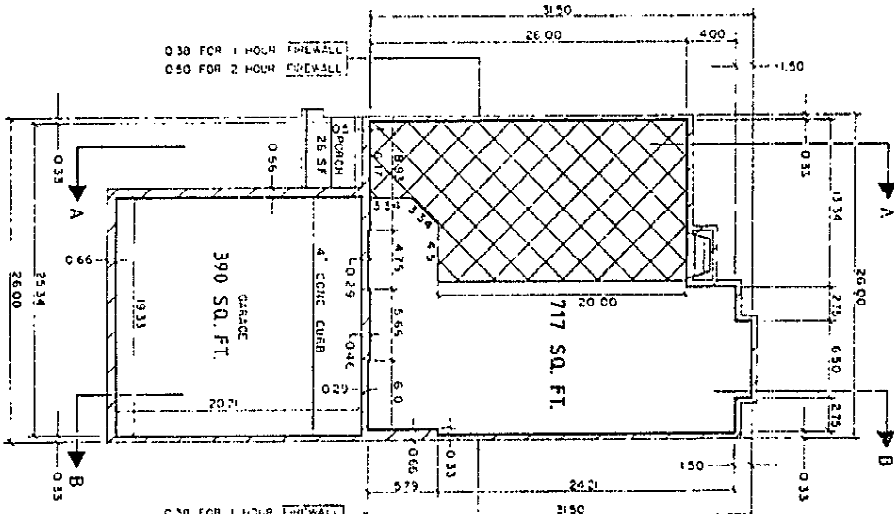


139991929


FIRST FLOOR PLAN
ALL WALLS ARE 0.33 UNLESS OTHERWISE NOTED

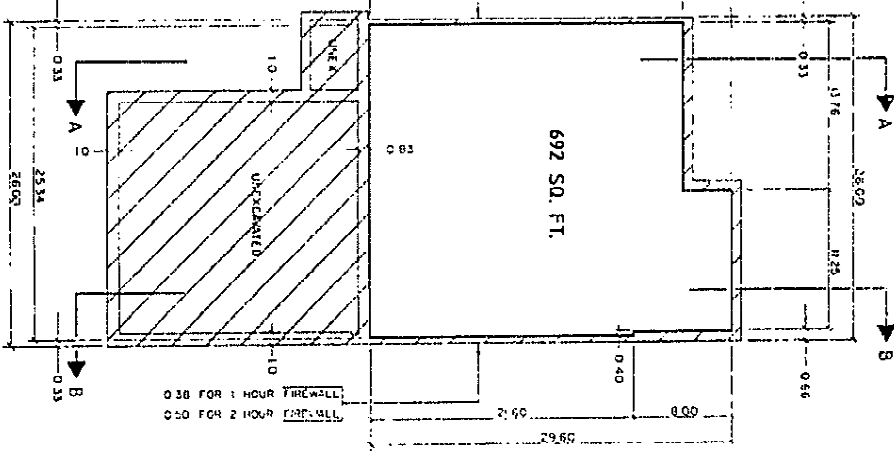

BASEMENT PLAN
ALL WALLS ARE 0.66 UNLESS OTHERWISE NOTED




-  SLOPED CEILING
-  GENERAL COMMON ELEMENT
-  LIMITED COMMON ELEMENT
-  LIMITS OF OWNERSHIP
- ALL OWNERSHIP LINES ARE 90° TO EACH OTHER
- SCALE: 1/4" INCH = 1.0 FOOT
- 0 5 10 15
-  CENTERLINE
- UNIT VOLUME 21,893 CUBIC FEET

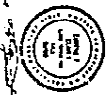

APPROVED		DATE: JUNE 1, 1993	
THE FAIRWAY CONDOMINIUM	THE FAIRWAY CONDOMINIUM		
HERBERT WOLFGANG			
5			

LIBER 13999 930

SECOND FLOOR PLAN
ALL WALLS ARE 0.33 UNLESS OTHERWISE NOTED

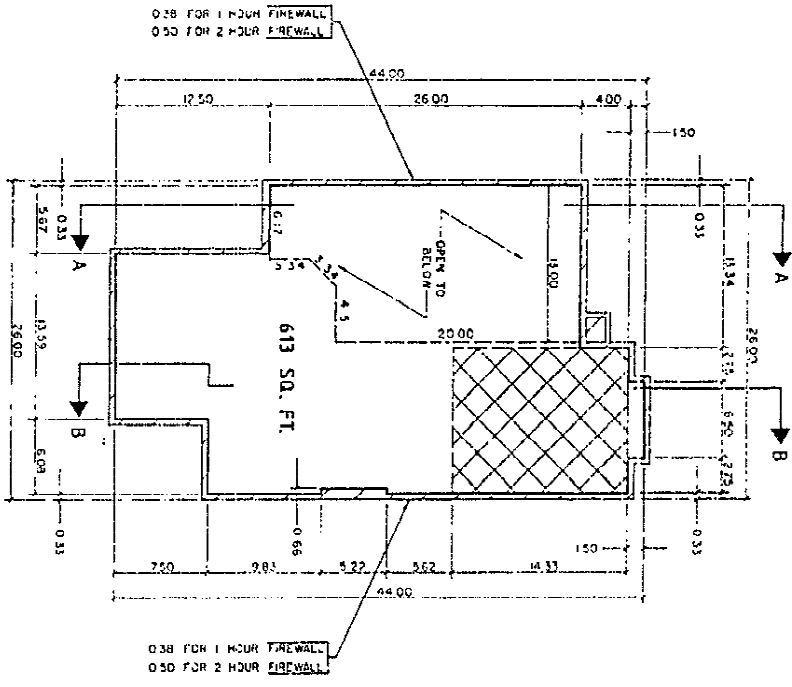

SLOPED CEILING
 GENERAL COMMON ELEMENT
 LIMITS OF OWNERSHIP
 ALL OWNERSHIP LINES ARE 90° TO EACH OTHER
 SCALE: 1/4" INCH = 1.0 FOOT
 5 10 15
 CENTERLINE

JUNE 1, 1993


REVISIONS	
DATE	BY

AS-BUILT


THE FAIRWAYS CONDOMINIUM
TYPICAL SECOND FLOOR PLAN
FOR UNIT TYPE "C"



LABER 139991931

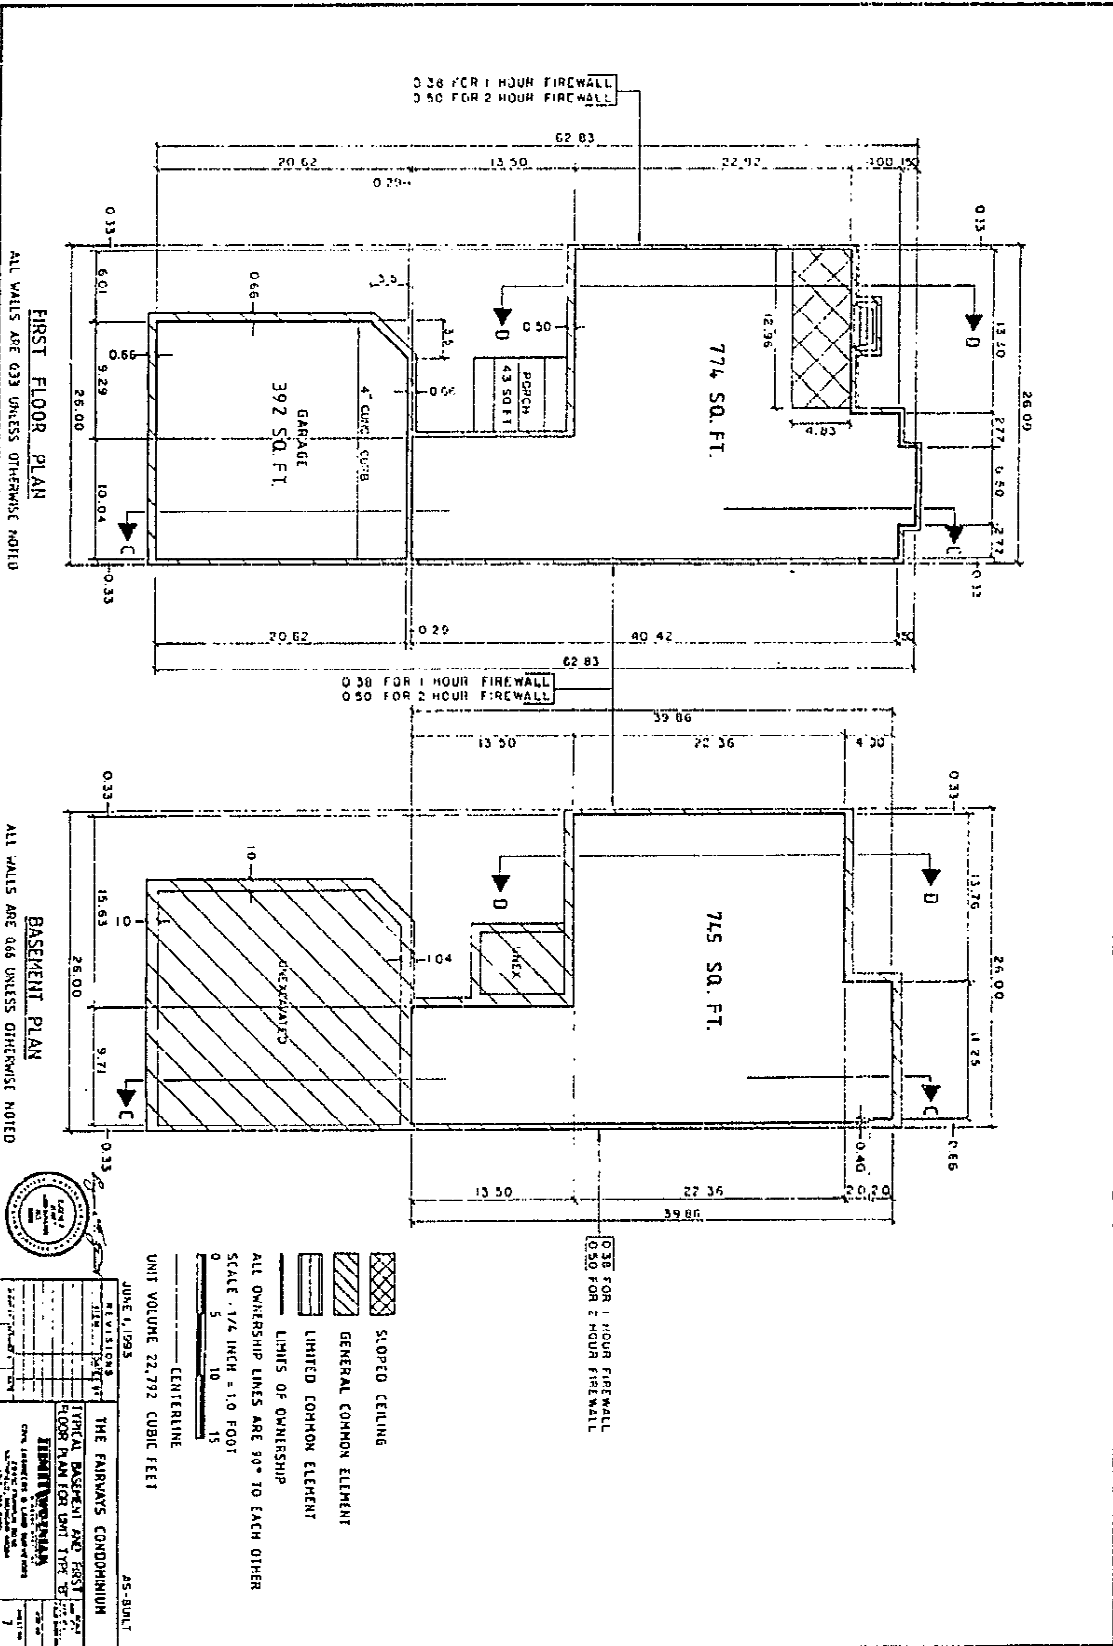
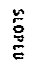
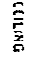


LIBER 139997932

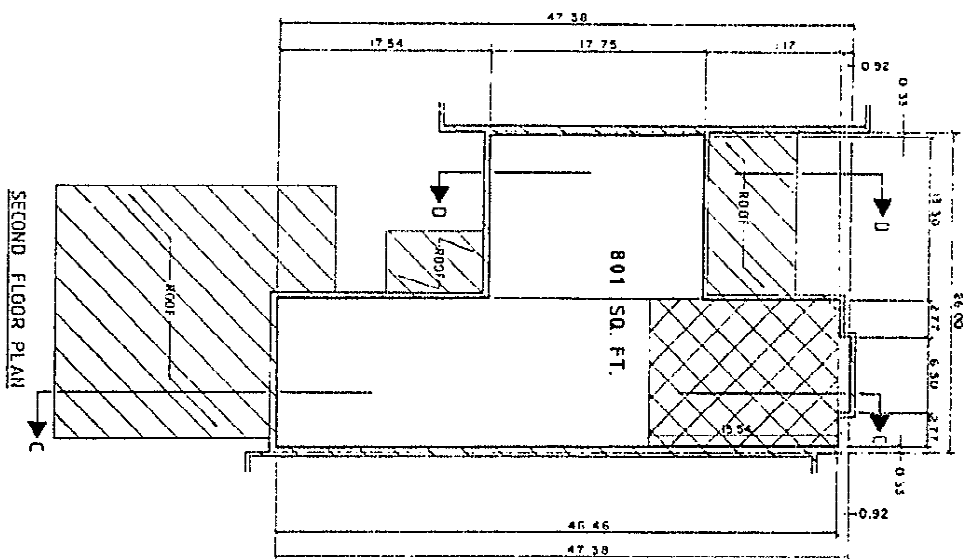

SECOND FLOOR PLAN

B01 SQ. FT.

-  SLOPED CEILING
-  GENERAL COMMON ELEMENT
-  LIMITS OF OWNERSHIP


ALL OWNERSHIP LINES ARE 90° TO EACH OTHER
 SCALE : 1/8" INCH = 1.0 FOOT
 0 5 10 15
 CENTERLINE
 ALL WALLS ARE 0.33 UNLESS OTHERWISE NOTED




JUNE 1, 1993		AS-BUILT	

LIBER 13999/933


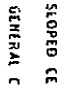
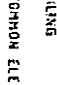
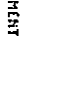
FIRST FLOOR PLAN
ALL WALLS ARE 033 UNLESS OTHERWISE NOTED

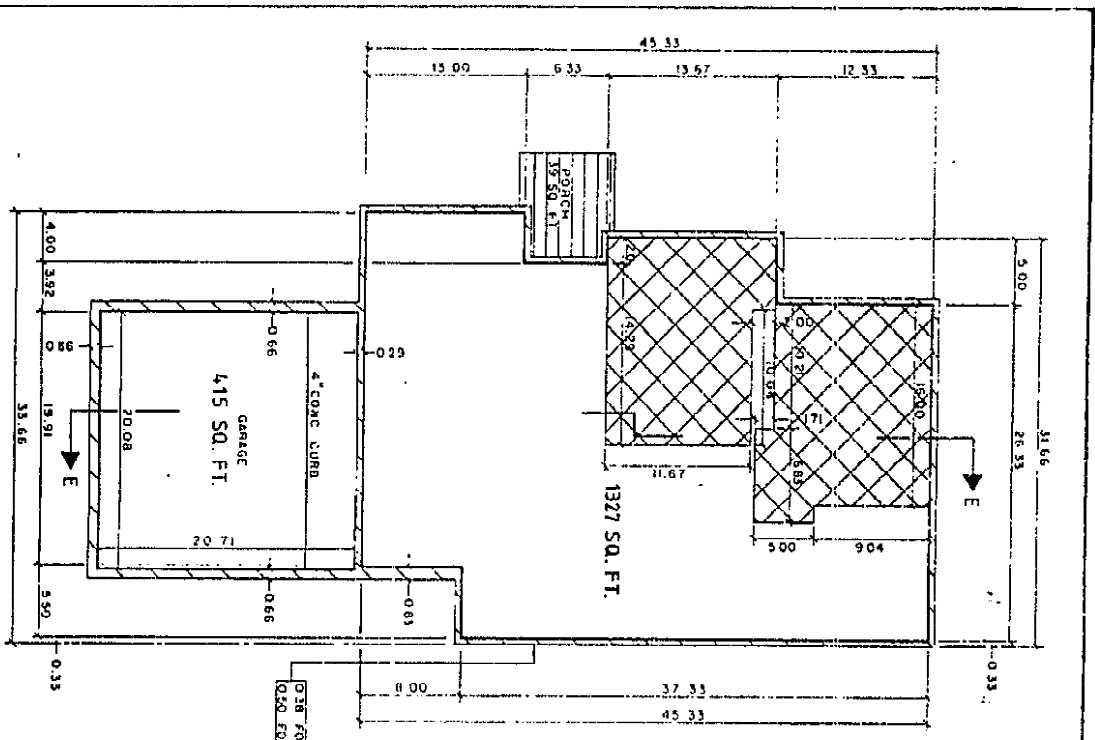

BASEMENT PLAN
ALL WALLS ARE 036 UNLESS OTHERWISE NOTED

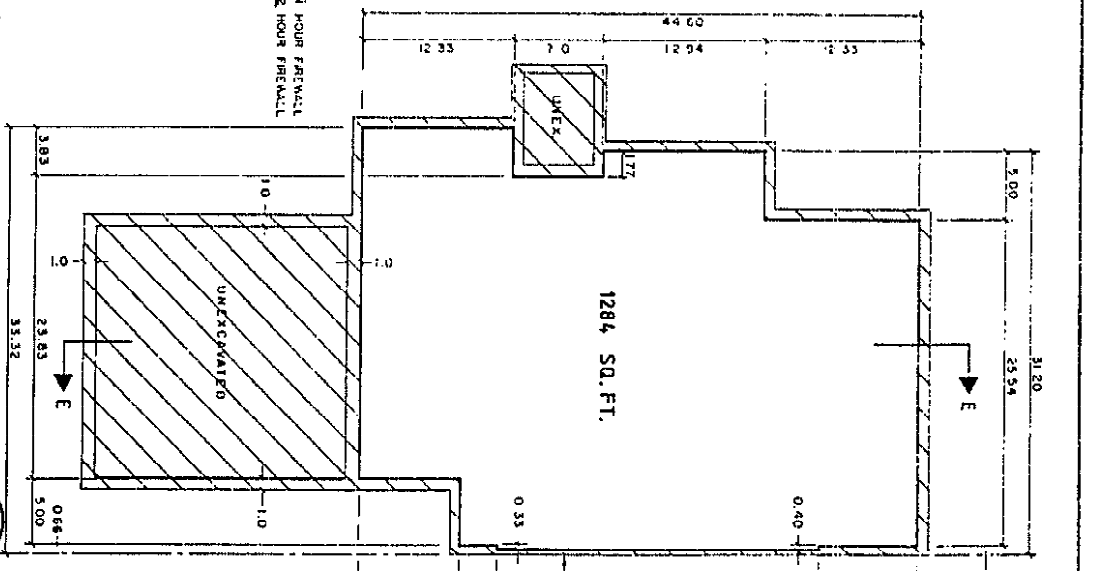

UNIT VOLUME 25,428 CUBIC FEET
AS-BUILT


 SLOPED CEILING
 GENERAL COMMON ELEMENT
 LIMITED COMMON ELEMENT
 LIMITS OF OWNERSHIP

ALL OWNERSHIP LINES ARE 90° TO EACH OTHER
SCALE: 1/4" INCH = 10' FOOT
0 5 10 15

CENTERLINE


LIBER 13999 PG 934

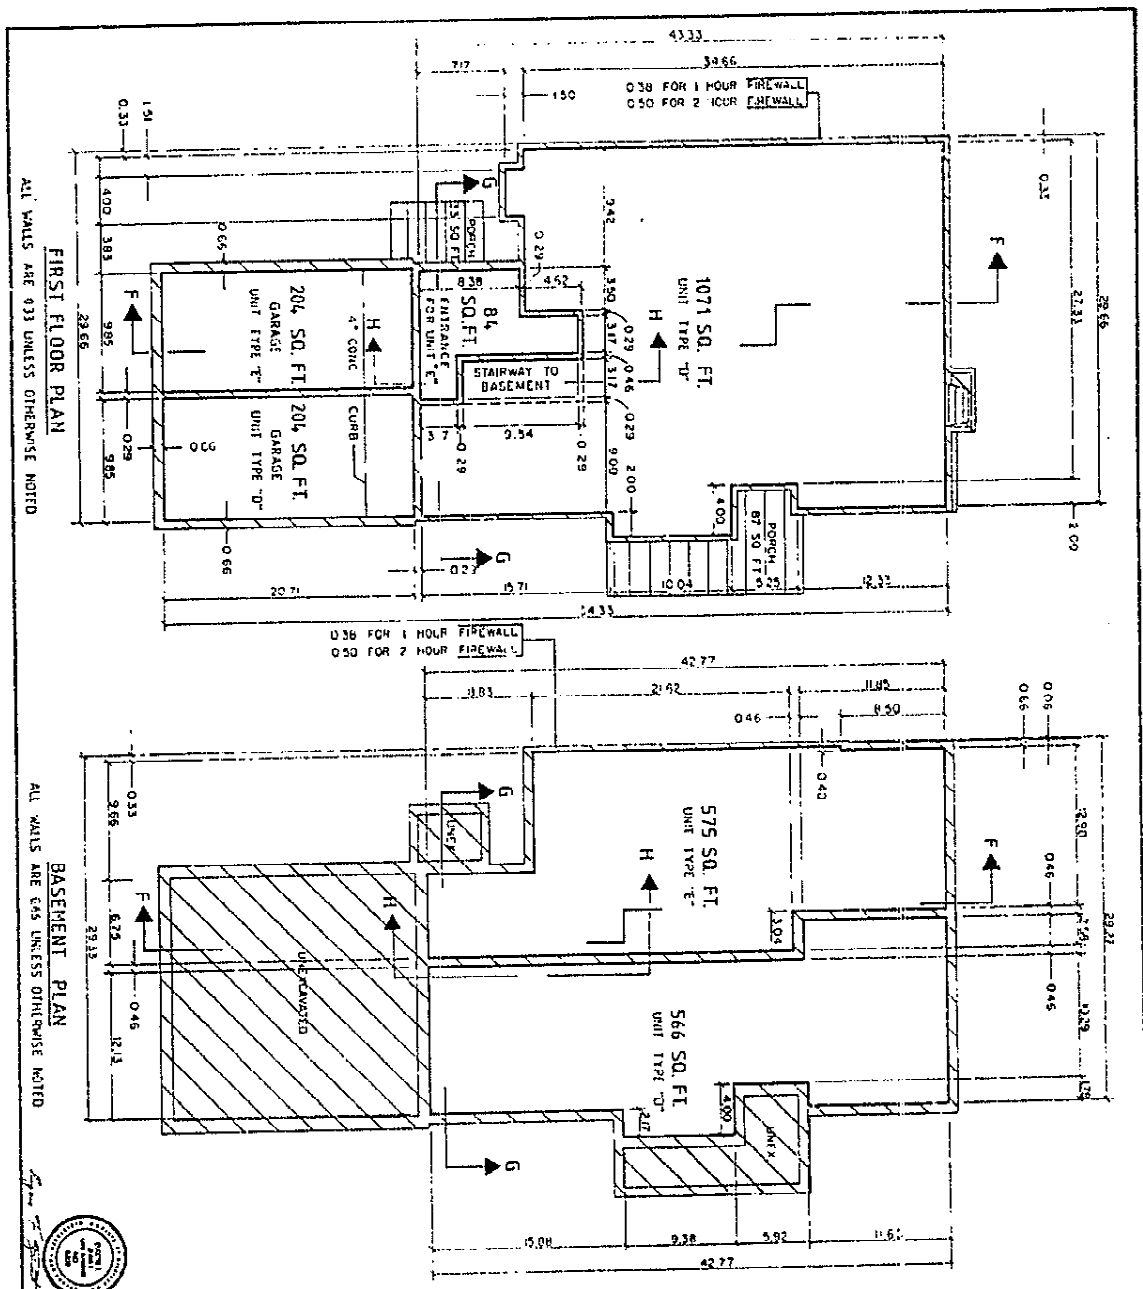

JUNE 1, 1993

REVISIONS	DATE	BY	DESCRIPTION






10

GENERAL COMMON ELEMENT

LIMITS OF OWNERSHIP

ALL OWNERSHIP LINES ARE 90° TO EACH OTHER

SCALE: 1/4" INCH = 1'-0" FOOT



0 5 10 15

GENERAL NOTE

UNIT "D" UNIT VOLUME 15,304 CUBIC FEET

UNIT "E" UNIT VOLUME 17,964 CUBIC FEET

LIBER 13999/935

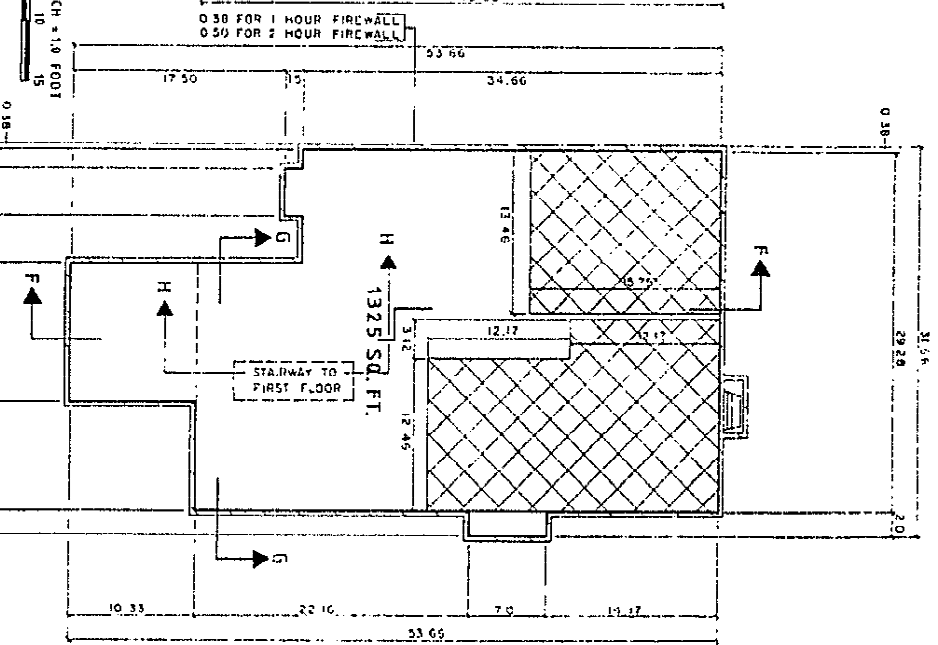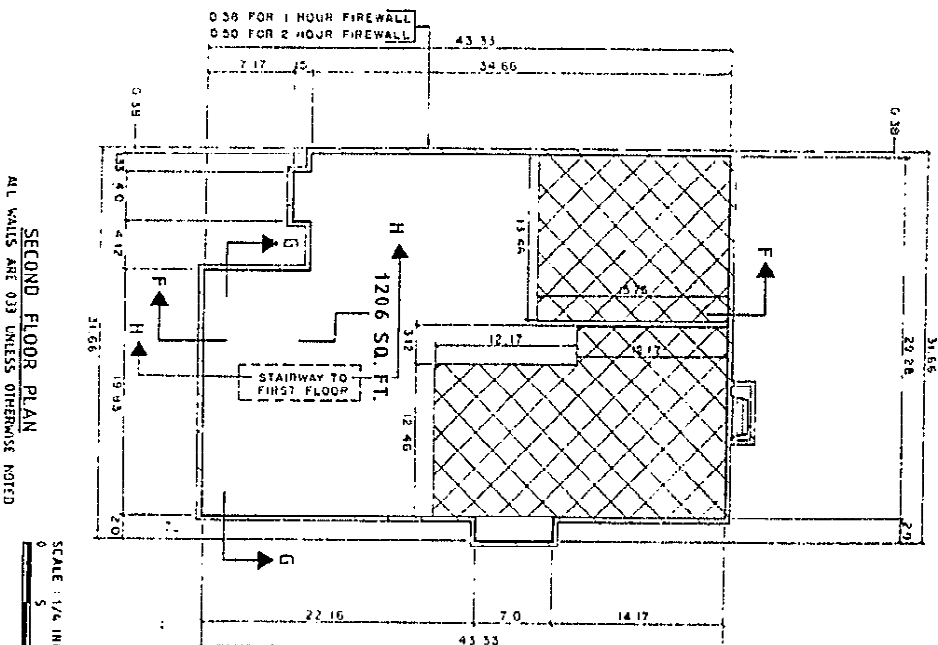


SCALE: 1/4" INCH = 1.0 FOOT

UNIT VOLUME 72,964 CUBIC FEET
 UNIT VOLUME 16,936 CUBIC FEET, WITH
 OPTIONAL LOFT
 OPTIONAL LOFT NEED NOT BE BUILT

JUNE 1, 1993



LIBR 13999/936

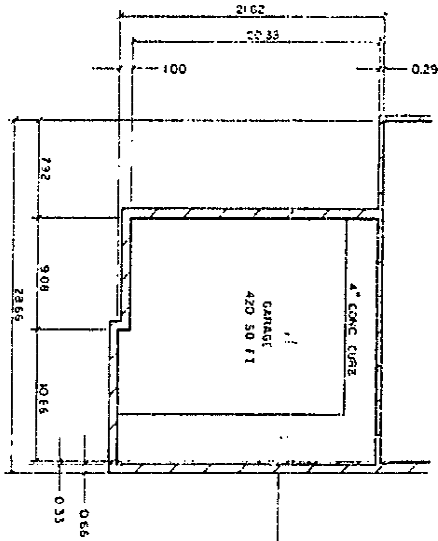


PARTIAL FLOOR PLAN


UNIT TYPE "C"
SEE UNIT TYPE "C" SHIT NO 9 1
FOR BALANCE OF UNIT LAYOUT,
NOTES AND DIMENSIONS.

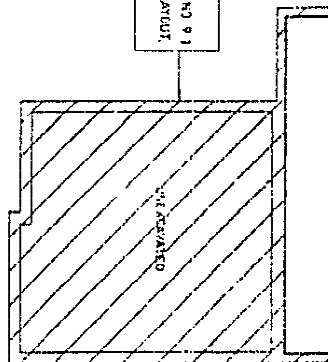

PARTIAL BASEMENT/FOUNDATION PLAN

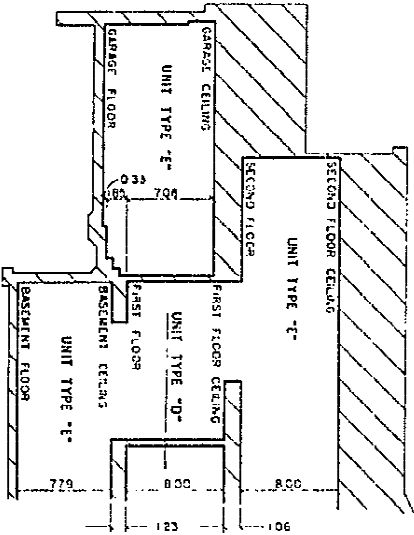

PARTIAL SECTION F-F WITH OPTIONAL LOFT

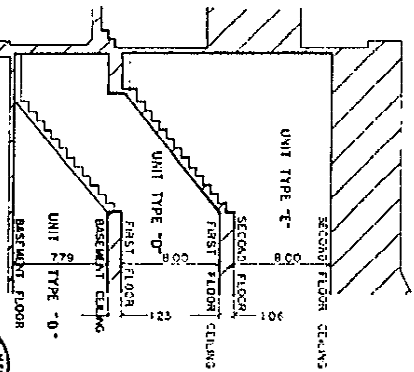

PARTIAL SECTION H-H


GENERAL COMMON ELEMENT
 LIMITED COMMON ELEMENT
 LIMITS OF OWNERSHIP
 ALL OWNERSHIP LINES ARE 90° TO EACH OTHER
 EXCEPT AS SHOWN

SCALE 1/4 INCH = 10 FEET
 0 5 10 15 20
 OPTICAL LOFT (LEO) NOT TO BE BUILT





LIBER 13999/937

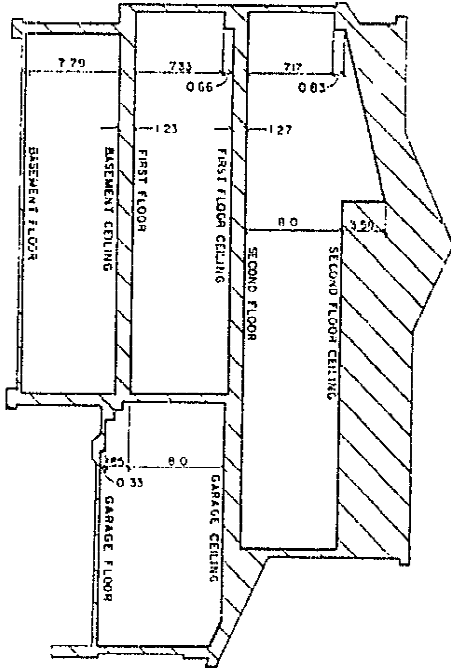

SECTION B-B

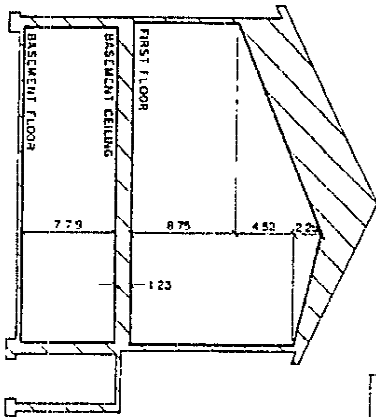

SECTION A-A

GENERAL COMMON ELEMENT
 LIMITED COMMON ELEMENT
 LIMITS OF OWNERSHIP
 ALL OWNERSHIP LINES ARE 90° TO EACH OTHER
 EXCEPT AS SHOWN
 SCALE: 1/4" INCH = 1.0 FOOT
 0 5 10 15

UNIT NO.	FIRST FLOOR ELEVATION
2,59,72	694.52
1,1,30	693.52
51,16,21	694.52
24,31,34	694.52
4,1,04,47	694.52
4,8,51,34	694.52
57,60	694.52
46,63	694.52
69,72	694.52
75,82,79	694.52
79,82,83,88	693.52
91,93	694.02




JUNE 11, 1993




NO.	DATE	REVISIONS
1		AS-BUILT


THE FAIRWAYS CONDOMINIUM
 TYPICAL SECTIONS FOR UNIT
 LEVEL 1

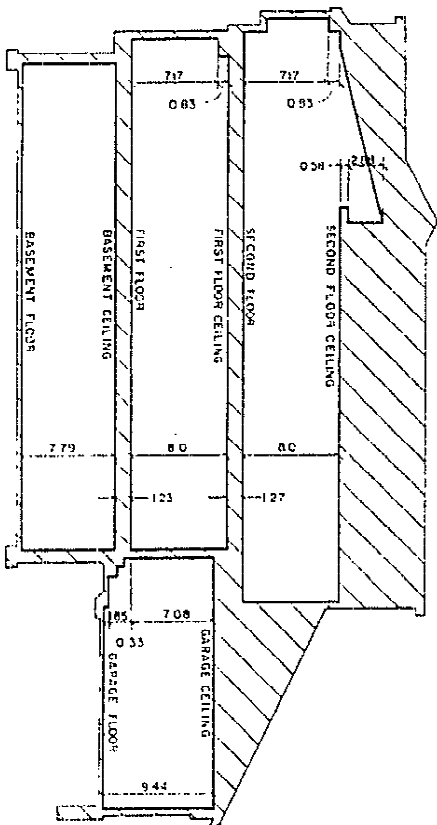LIBER 13999/938



SECTION C-C
FOR UNIT TYPE "B-2" - "B-1"

 GENERAL COMMON ELEMENT
 LIMITED COMMON ELEMENT
 LIMITS OF OWNERSHIP
 ALL OWNERSHIP LINES ARE 90° TO EACH OTHER EXCEPT AS SHOWN
 SCALE: 1/4" INCH = 1.0 FOOT
 0 5 10 15

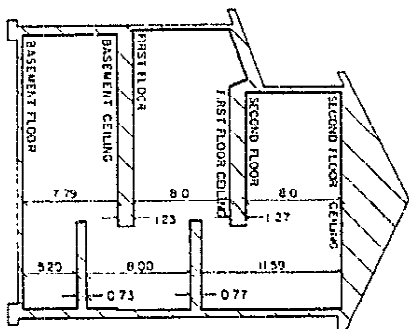

SECTION D-D
FOR UNIT TYPE "B"


UNIT NO	FIRST FLOOR ELEVATION
4, 6, 10, 11	694.52
28, 29	693.52
5, 17, 21	694.52
23, 25, 26	694.52
47, 48	694.52
52, 53	694.52
58, 59	694.52
61, 65	694.52
70, 71	694.52
80, 81, 82, 87	693.52
97, 98	694.52



DATE	REVISIONS	BY	FOR

THE FAIRMARKE CONDOMINIUM
 AS-BUILT
 TYPICAL SECTIONS FOR UNIT TYPE "B-2" - "B-1"

LIBER 13999/939

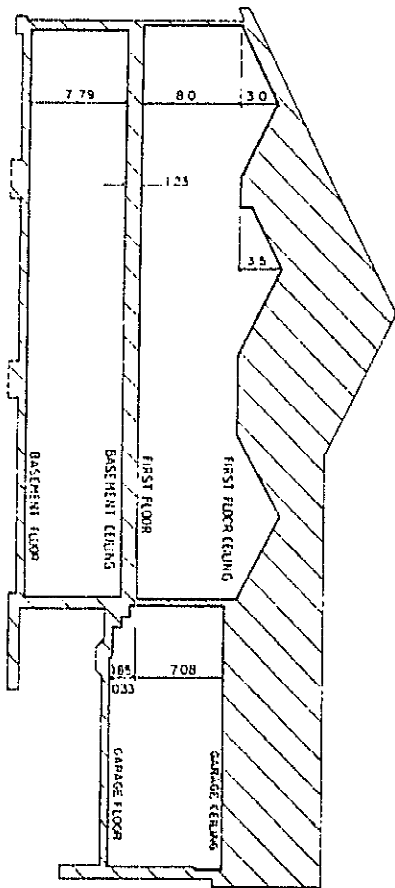

SECTION E-E

UNIT NO.	FIRST FLOOR ELEVATION
1,5,11,19	554.52
31, 26	601.52
11, 26, 25	604.52
38, 35, 5, 6	694.52
48, 59, 55	804.52
56, 61	694.52

GENERAL COMMON ELEMENT
 LIMITED COMMON ELEMENT
 LIMITS OF OWNERSHIP

ALL OWNERSHIP LINES ARE 90° TO EACH OTHER EXCEPT AS SHOWN
 SCALE: 3/4" INCH = 10' FOOT
 0 5 10 15



JUNE 1, 1993

AS-BUILT

THE FAIRMAYS CONDOMINIUM










LIBER 139991940

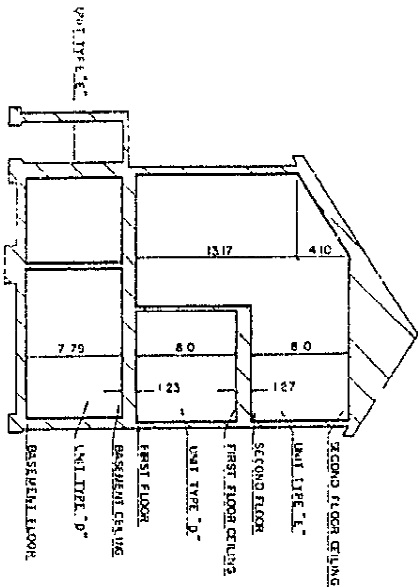SECTION G-G

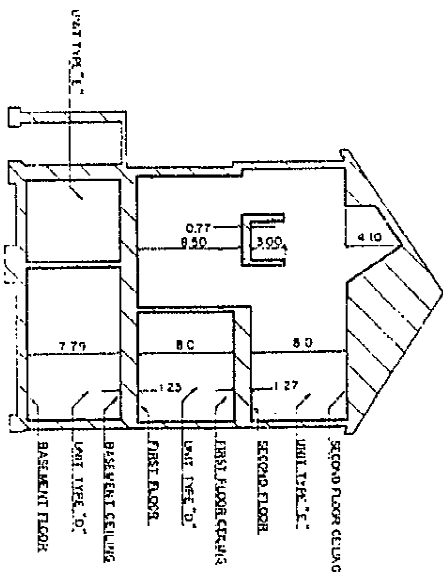

SECTION G-G WITH OPTIONAL LOFT



 GENERAL COMMON ELEMENT
 LIMITED COMMON ELEMENT
 LIMITS OF OWNERSHIP
 ALL OWNERSHIP LINES ARE 90° TO EACH OTHER EXCEPT AS SHOWN
 OPTIONAL LOFT NEEDNOT BE BUILT
 SCALE: 1/4" INCH = 1.0 FOOT
 0 5 10 15

UNIT "D"	UNIT "E"	FIRST FLOOR ELEVATION
7.32.39	3.33.40	694.52
9/2	93	594.52



JUNE 1, 1993

AS-BUILT

NO.	REVISIONS	DATE	BY
1	ISSUE		


THE FAIRMANS CONDOMINIUM

TYPICAL SECTION FOR UNIT TYPE "D" AND "E"



16

139990941

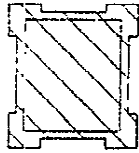

GATE HOUSE

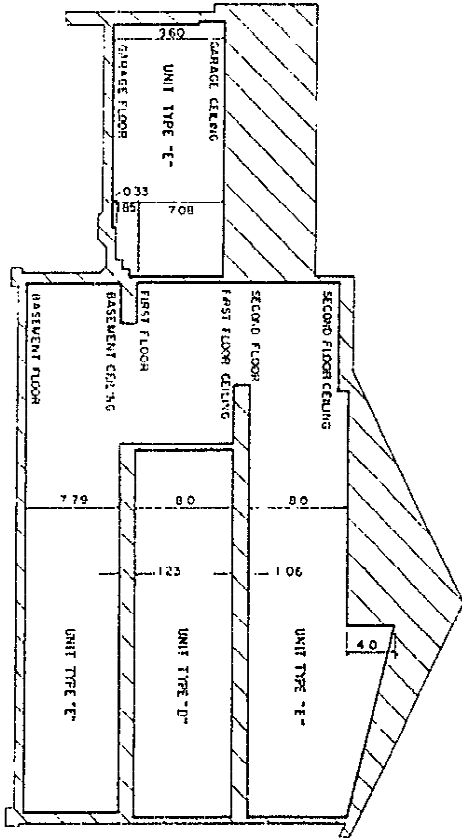

SECTION F-F


UNIT-D	UNIT-E	FIRST FLOOR ELEVATION
7.39-39	8.33-40	696.52
9L	95	651.52

- SLOPED CEILING
 - GENERAL COMMON ELEMENT
 - LIMITED COMMON ELEMENT
 - LIMITS OF OWNERSHIP
- ALL OWNERSHIP LINES ARE 98" TO EACH OTHER EXCEPT AS SHOWN
 SCALE: 1/4" INCH = 10 FEET
 0 5 10 15



---	--	--	----------------

LIBER 139991942

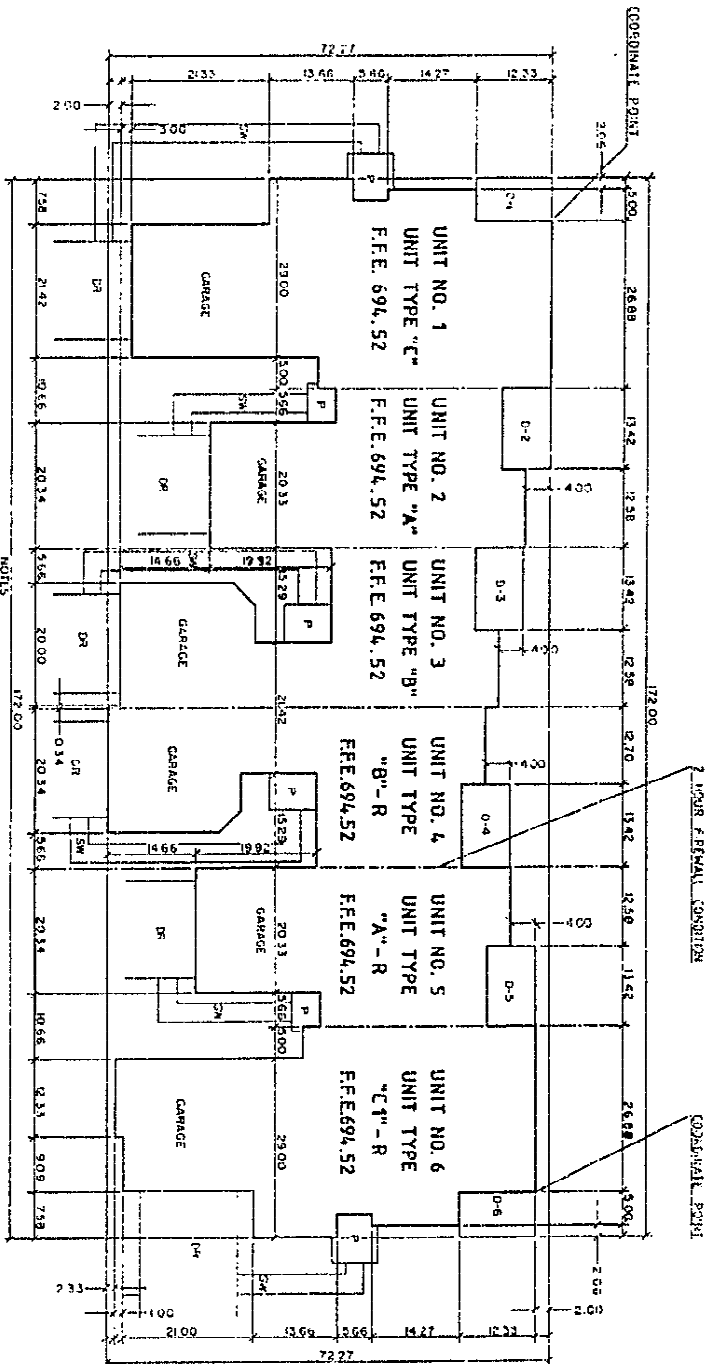

NOTES:
 DR DENOTES DECK-UNIT ASSIGNMENT
 CR DENOTES DRIVEWAY
 SW DENOTES SIDEWALK


P DENOTES PORCH
 LIMITED COMMON ELEMENT
 R DENOTES REVERSE OF TYPICAL UNIT
 CENTERLINE

SCALE: 1/8 INCH = 1.0 FOOT
 0 5 10 20 30




JUNE 1, 1983	

LIBER 13999/0943

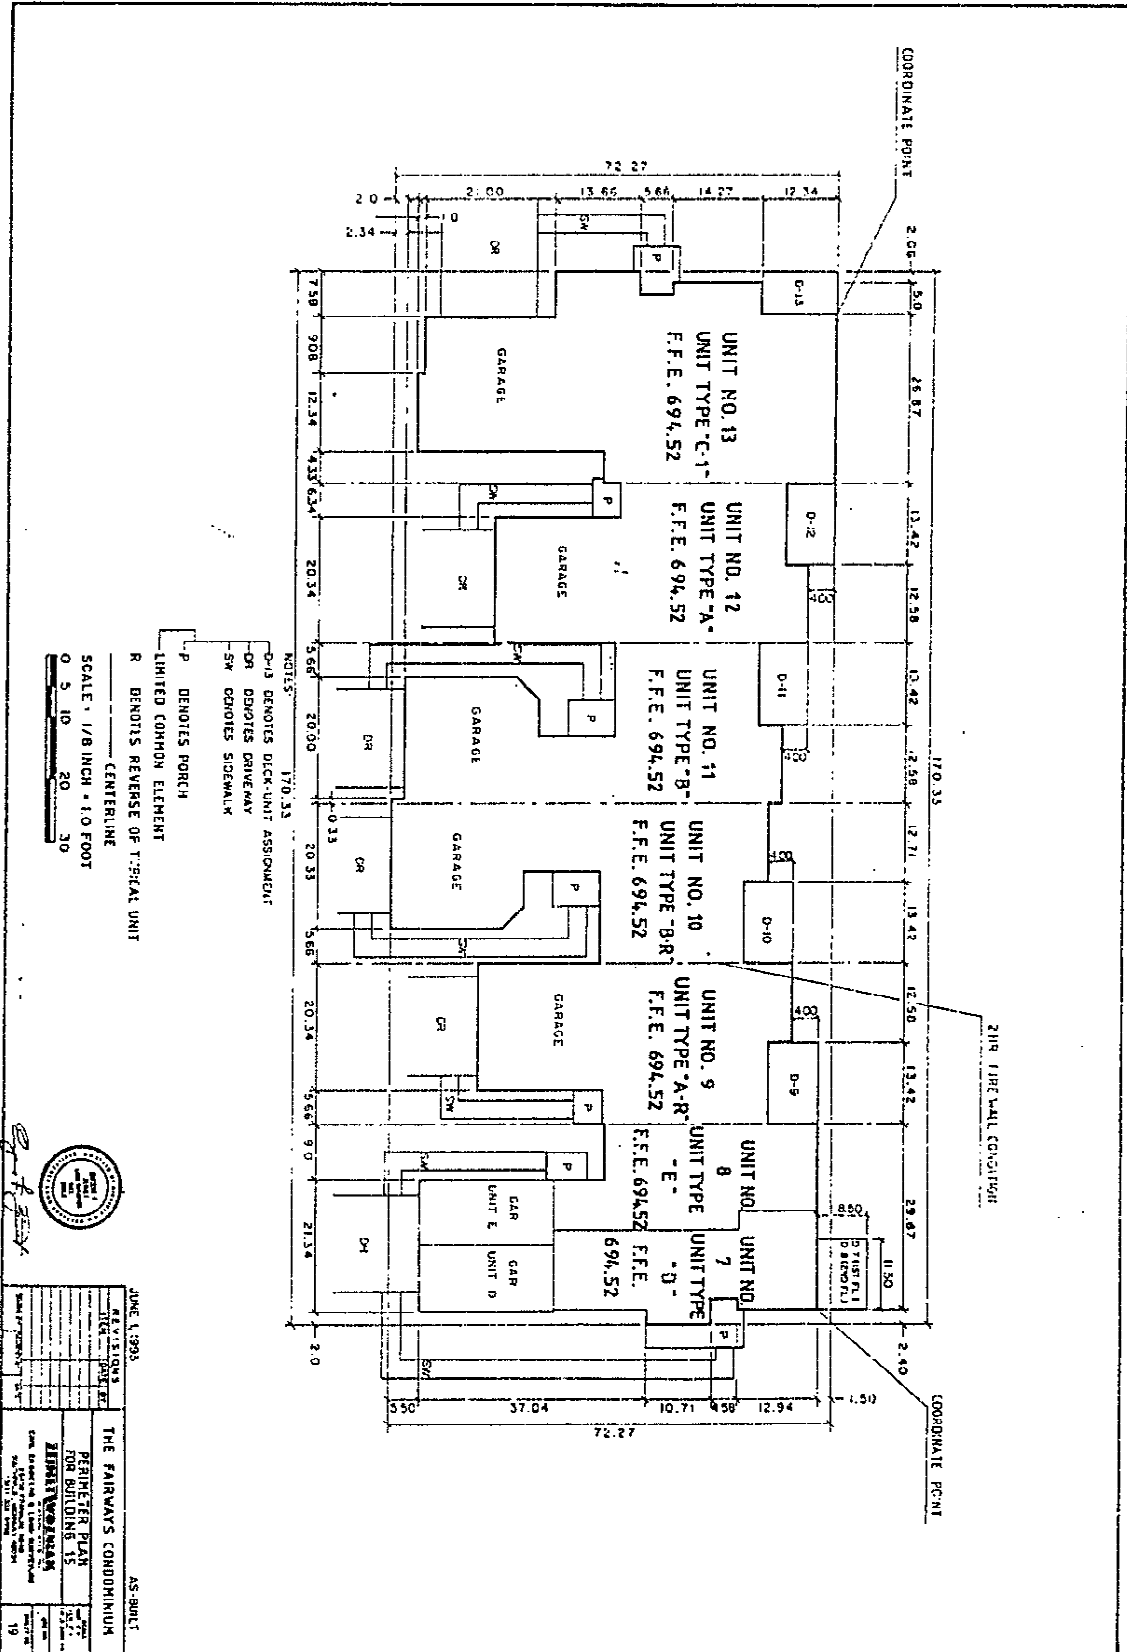

LIBER 13999#944

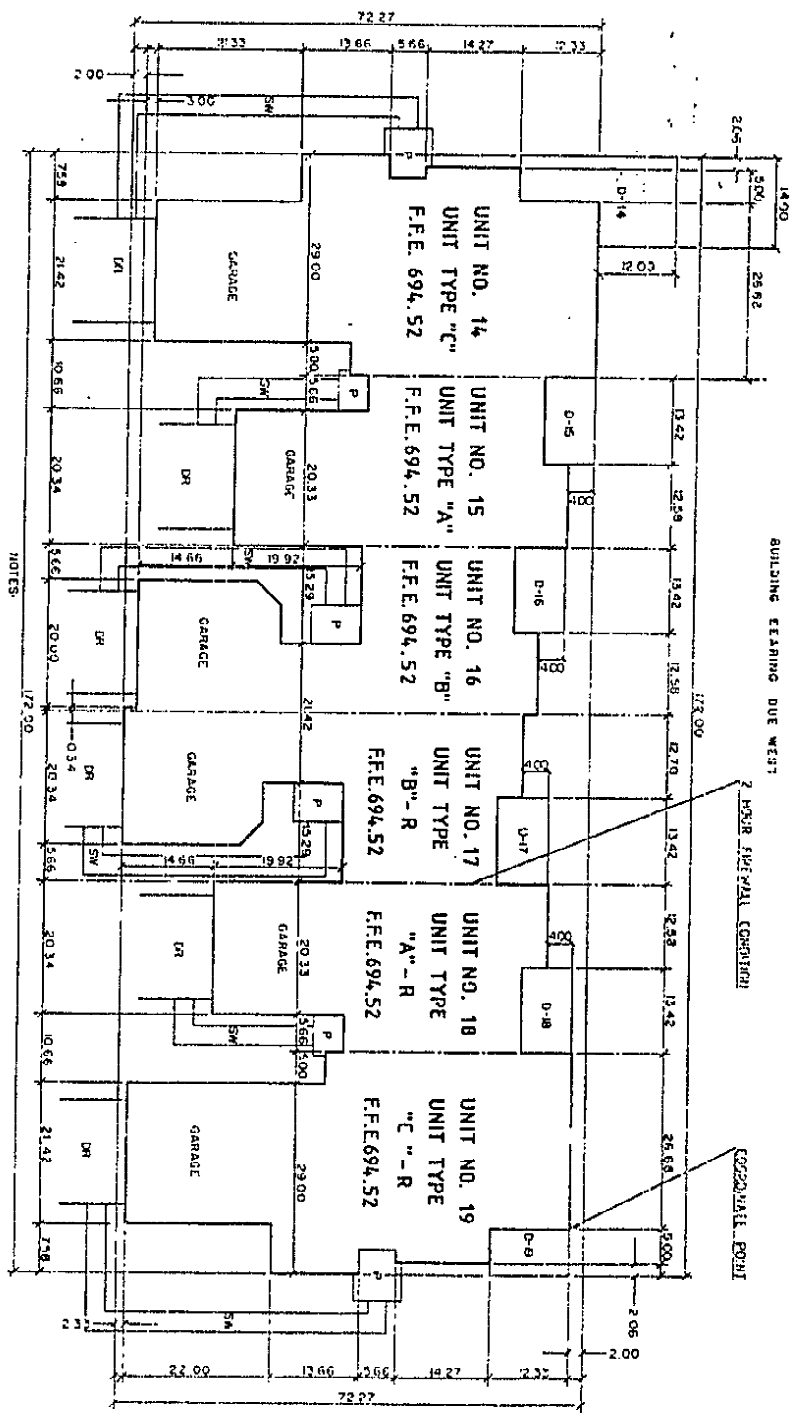

NOTES:
 -D-14 DENOTES DECK-UNIT ASSIGNMENT
 -DR DENOTES DRESSING
 -SW DENOTES SIDEWALK
 -P DENOTES PORCH
 -LIMITED COMMON ELEMENT
 -R DENOTES REVERSE OF TYPICAL UNIT
 -CENTERLINE

SCALE: 1/8 INCH = 1.0 FOOT
 0 5 10 20 30'



JUNE 1, 1983


REVISIONS	DATE	BY	DESCRIPTION

AS-BUILT

THE FAIRWAYS CONDOMINIUM
 PERMETER PLAN
 FOR BUILDING 6


LIBER 13999-1945

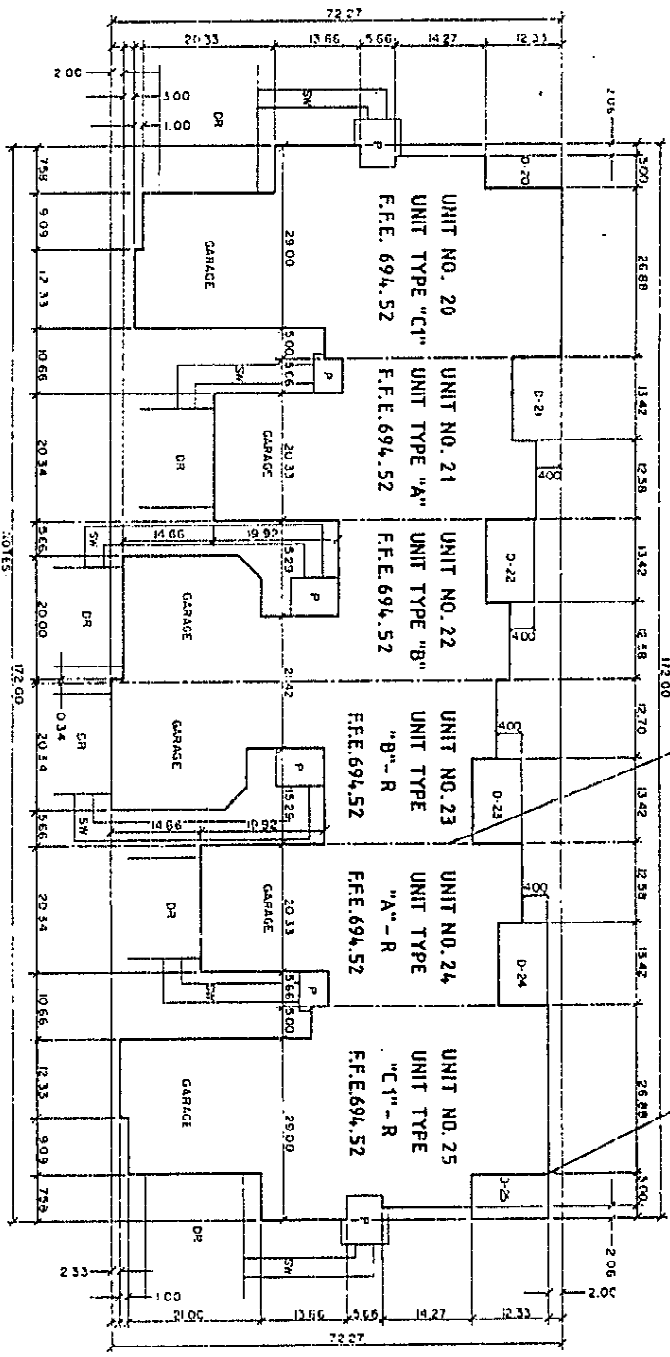

BUILDING BEARING N 03°30'00\"/>

2 HOUR FIREWALL SEPARATION

CONCRETE FLOOR

NOTES:

- 0-20 DENOTES DECK-UNIT ASSIGNMENT
- DR DENOTES DRIVEWAY
- SW DENOTES SIDEWALK
- P DENOTES PORCH
- UNITED COMMON ELEMENT
- R DENOTES REVERSE OF TYPICAL UNIT
- CENTERLINE

SCALE: 1/8 INCH = 1.0 FOOT

0 5 10 20 30




JUNE 1, 1993

AS-BUILT

REVISIONS	
DATE	DESCRIPTION

THE FARMWAY'S CONDOMINIUM	
SCALE: 1/8\"/>	
21	

LIBER 139990946

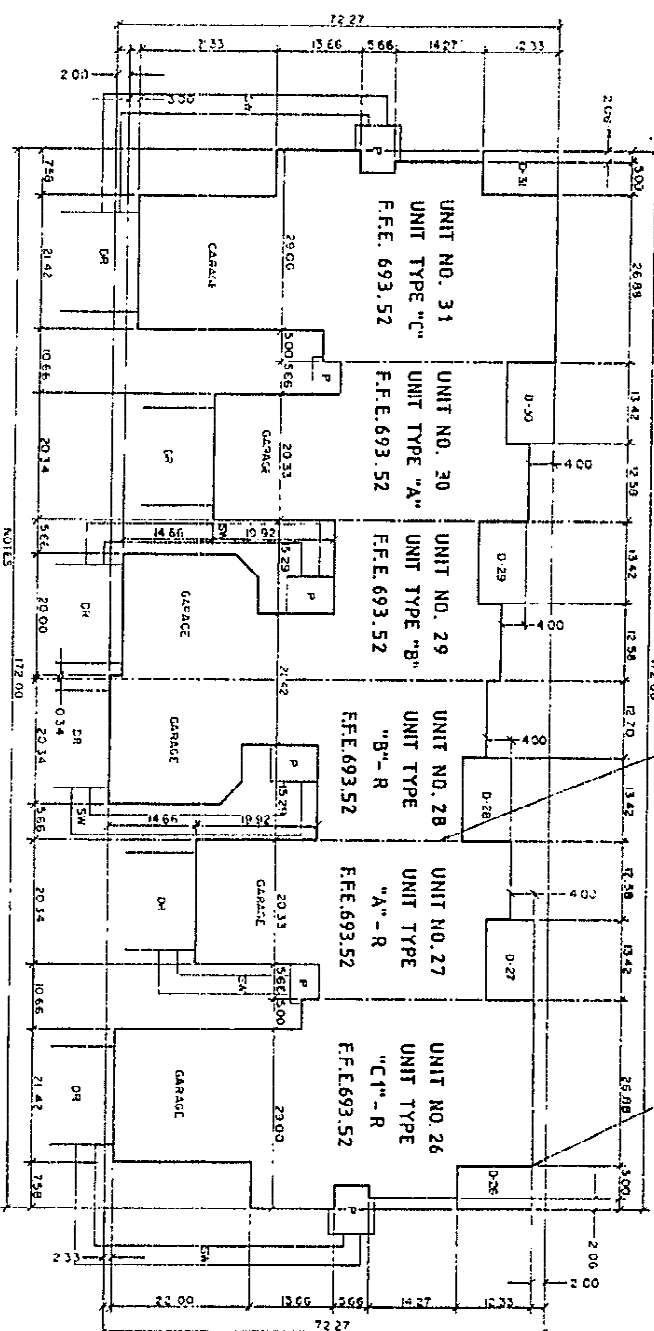

BUILDING BEARING OUT WEST

2 HOUR FIRE WALL LOCATION

SEPARATE ZONE

NOTES

- D-SI DENOTES DECK-UNIT ASSIGNMENT
- DR DENOTES DRIVEWAY
- SW DENOTES SIDEWALK
- P DENOTES PORCH
- LIMITED COMMON ELEMENT
- R DENOTES REVERSE OF TYPICAL UNIT
- CENTERLINE

SCALE: 1/8 INCH = 1.0 FOOT


0 5 10 20 30



AS-BUILD	DATE	11
REVISIONS	BY	
NO.	DATE	DESCRIPTION

LIBER 13999 PG 947

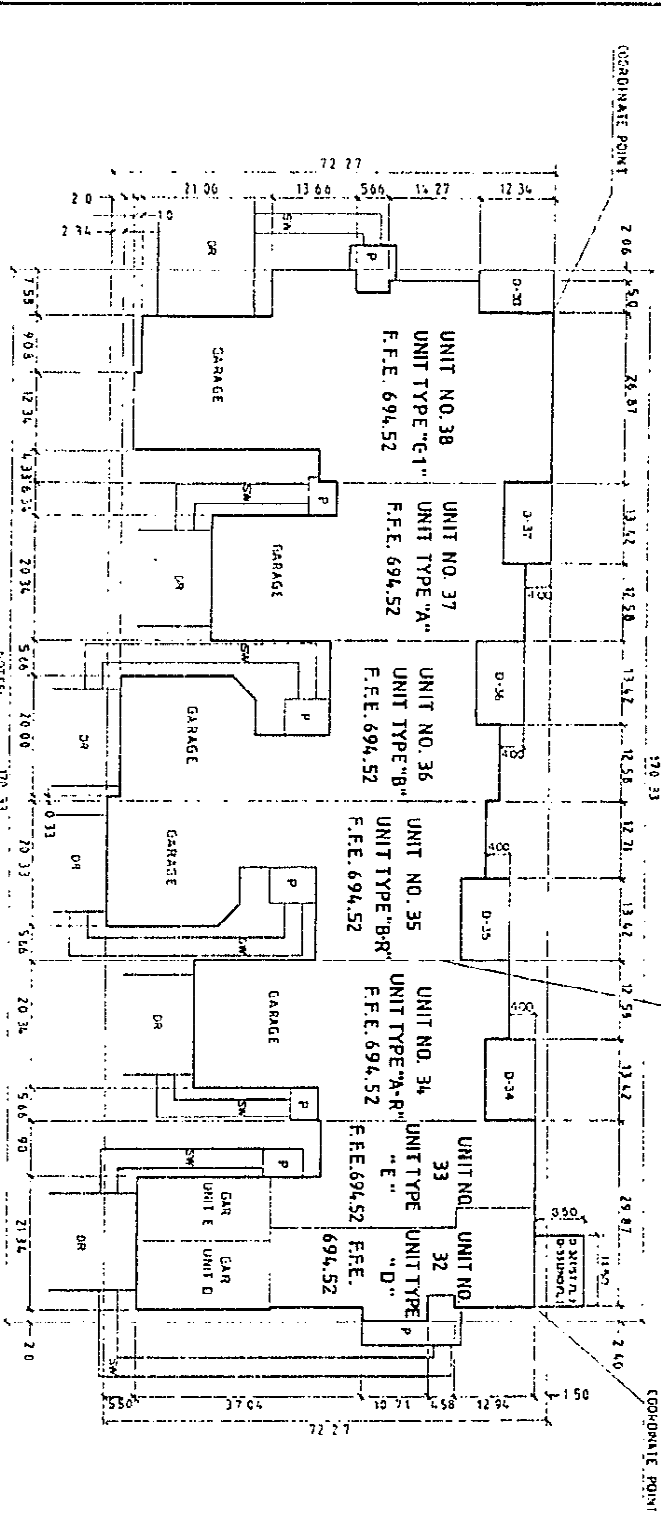


NOTES:
 P DENOTES PORCH
 DR DENOTES DRIVEWAY
 SW DENOTES SIDEWALK
 UNITED COMMON ELEMENT
 DENOTES REVERSE OF TYPICAL UNIT


SCALE: 1/8" INCH = 10 FOOT
 0 5 10 20 30



JUNE 1, 1993	

LIBER 13899 PG 94R

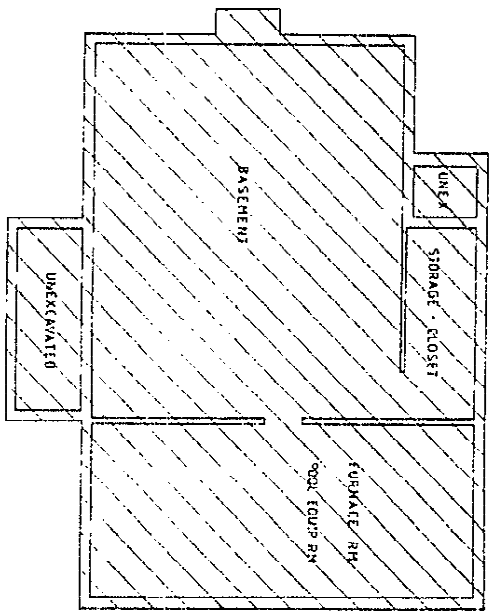


 GENERAL OPTION ELEMENT
 SCALE: 1/4" INCH = 1.0 FOOT
 0 5 10 15



JUNE 1, 1993

NO. OF REVISIONS	1	AS-BUILT
DATE	JUN 1 1993	
PROJECT	THE FAIRMAYS CONDOMINIUM	
	BASEMENT PLAN FOR CLUB HOUSE	
	ALTHEA WOODMAN	
	CON. ENGINEER & LAND SURVEYOR	
	24	

LIBER 13999PC949

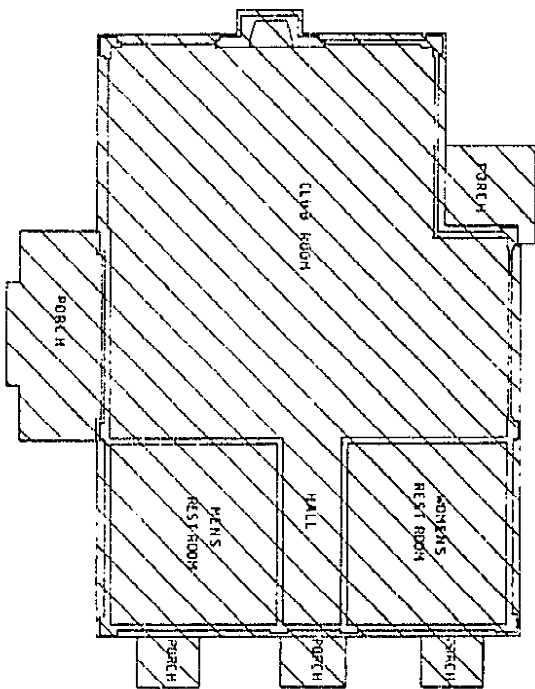


GENERAL COMMON ELEMENT

SCALE : 1/4 INCH = 10 FOOT
0 5 10 15



DATE: 11/29/93		AS-BUILT	
REVISIONS	NO.	DATE	DESCRIPTION
1			NEW
THE FAIRWAYS CONDOMINIUM		FIRST FLOOR PLAN FOR	
CLUB HOUSE		ZIMMERMAN	
25			

REF 13999-950

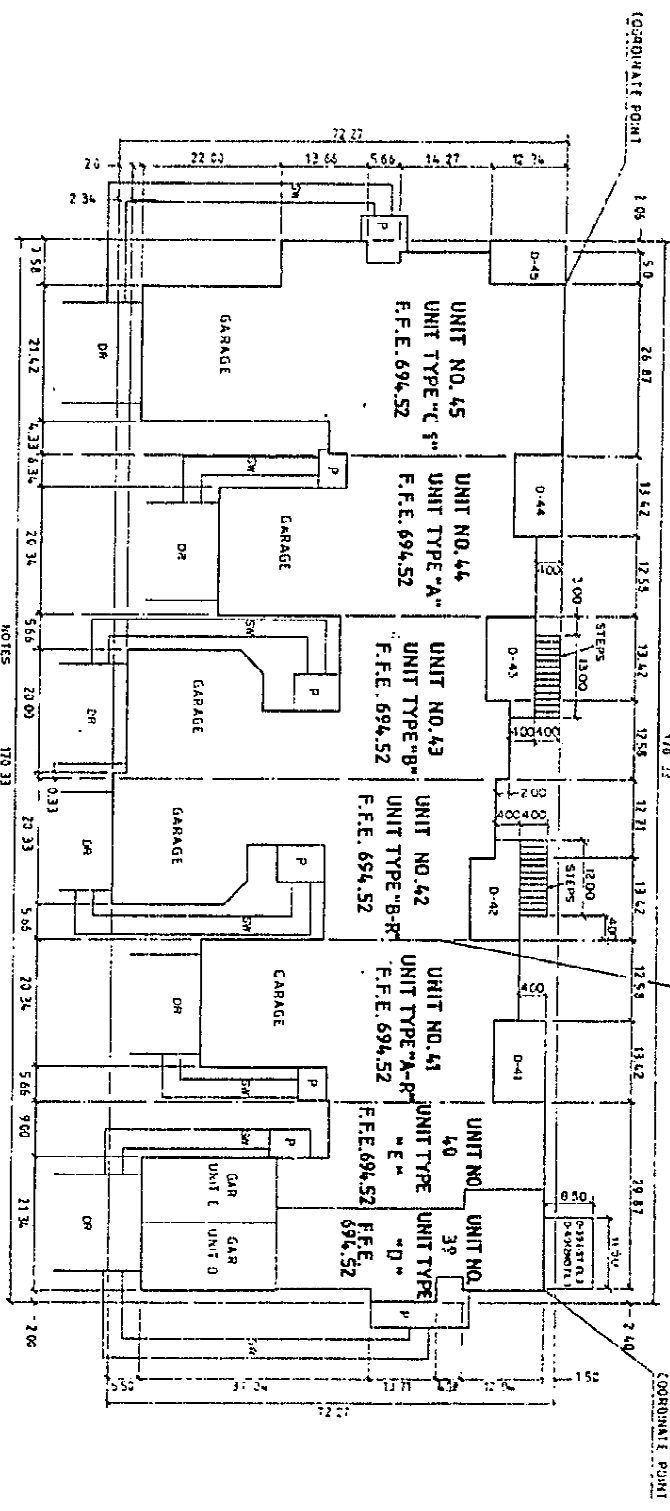

- NOTES
- 0-45 DENOTES DECK-UNIT ASSIGNMENT
 - DR DENOTES DRIVEWAY
 - SW DENOTES SIDEWALK
 - P DENOTES PORCH
 - LIMITED COMMON ELEMENT
 - R DENOTES REVERSE OF TYPICAL UNIT


SCALE: 1/8" INCH = 1'-0" FOOT

0 5 10 20 30



JUN 11 1993 REVISIONS NO. 1 DATE BY CHECKED DATE BY		THE FAIRWAYS CONDOMINIUM PERIMETER PLAN FOR BUILDING 13 UNIT 39-45 DATE: 6/11/93 BY: [Signature] CHECKED: [Signature]	AS-BUILT 13
SCALE: 1/8" INCH = 1'-0" FOOT 0 5 10 20 30			

LIBR 139990951

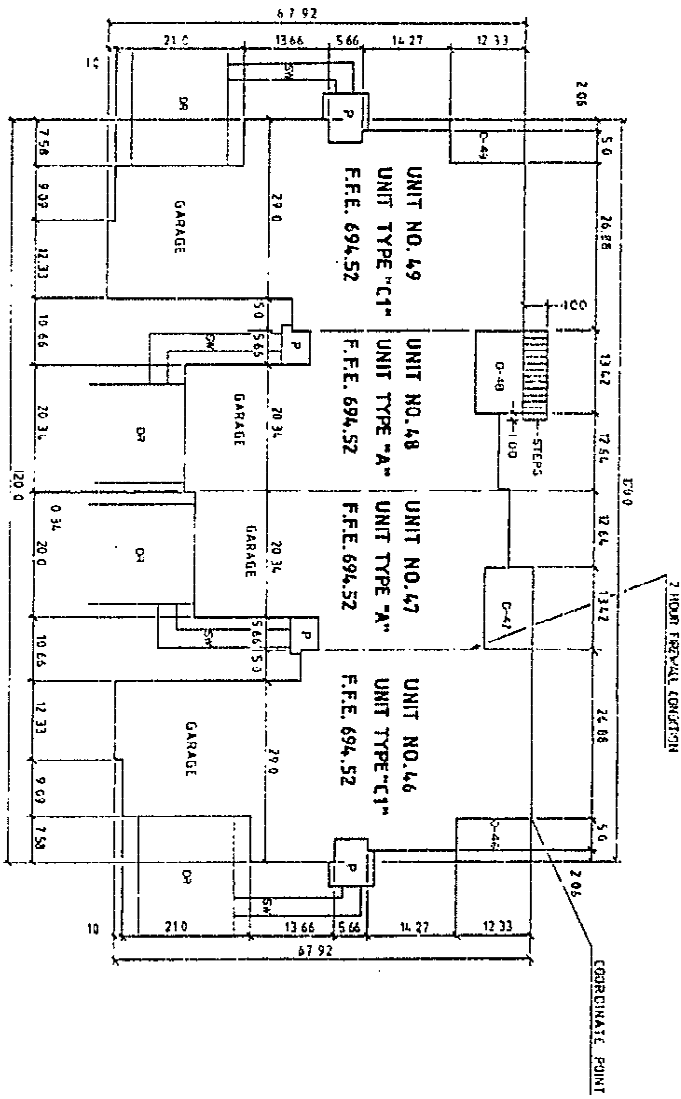

NOTES:

- D-49 DENOTES DECK-UNIT ASSIGNMENT
- DR DENOTES DRIVEWAY
- SW DENOTES SIDEWALK
- P DENOTES PORCH
- LIMITED COMMON ELEMENT
- R DENOTES REVERSE OF TYPICAL UNIT
- CENTRILINE

SCALE : 1/8" HIGH = 1.0 FOOT

0 5 10 20 30




JUNE 11, 1993


THE FAIRWAYS CONDOMINIUM
 PERMITTER'S PLAN

AS-BUILT
 27

LIBER 139991952

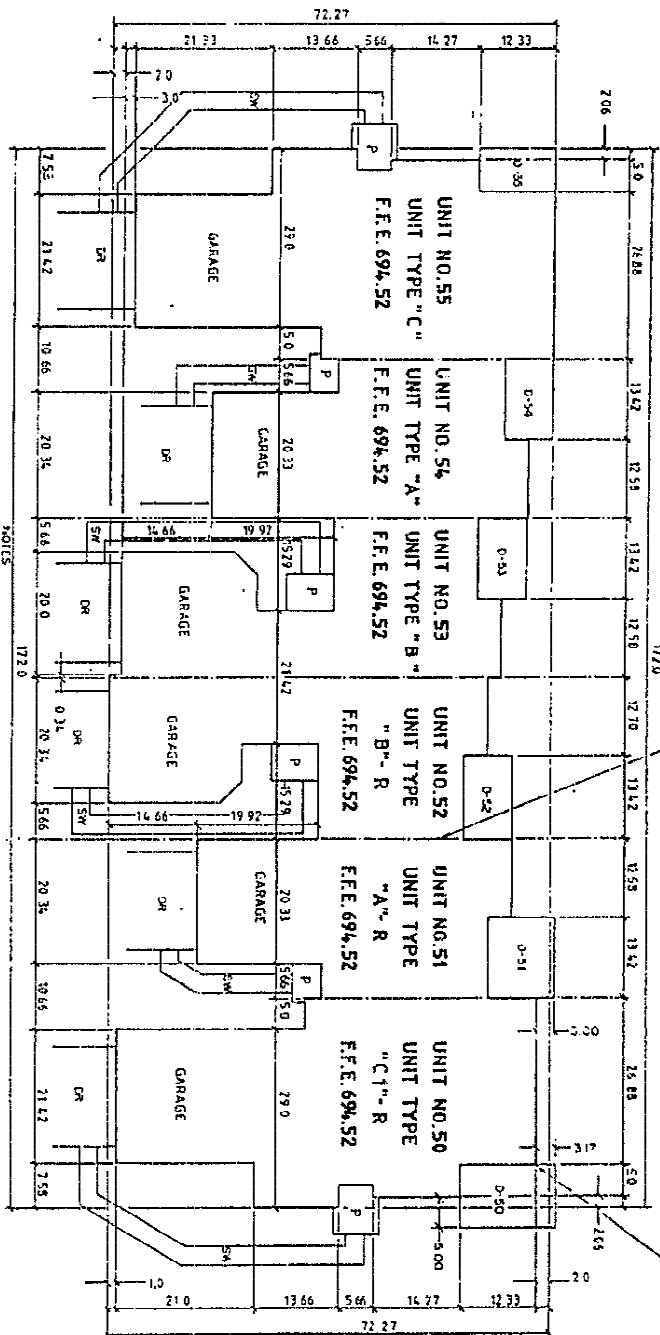

2 FOOT FIRE-ALL CONDITION

COORDINATE POINT

NOTES
D-50 DENOTES DECK-UNIT ASSIGNMENT
DR DENOTES DRIVEWAY
SW DENOTES SIDEWALK

P DENOTES PORCH

LIMITED COMMON ELEMENT

R DENOTES REVERSE OF TYPICAL UNIT

CENTERLINE

SCALE: 1/8" INCH = 1.0 FOOT


0 5 10 25 30




JUNE 1, 1993		AS-BUILT	
DATE	REVISION	DATE	REVISION
THE FAIRWAYS CONDOMINIUM			
PERMETER PLAN			
FOR BUILDING "A"			

LIBER 139990953

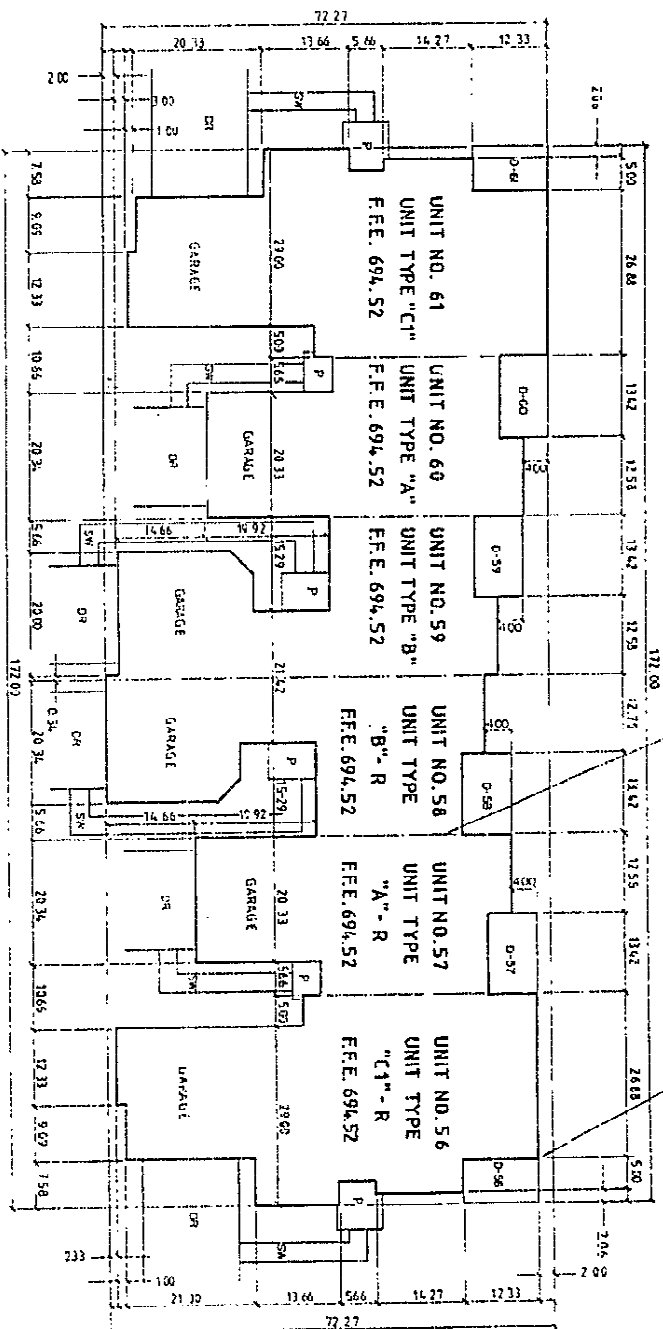

BUILDING BEARING N 69° 00' 30" W

2' CLEAR SIDEWALK FOUNDATION

CORNER POINT


- SI DENOTES DECK-UNIT ASSIGNMENT
- DR DENOTES DRIVEWAY
- SW DENOTES SIDEWALK
- P DENOTES PORCH
- UNITED COMMON ELEMENT
- R DENOTES REVERSE OF TYPICAL UNIT
- CENR RUMB
- SCALE: 1/4" INCH = 1.0' FOOT
- 0 5 10 20 30

AS-BUILT




LIBER 13999 PD 951

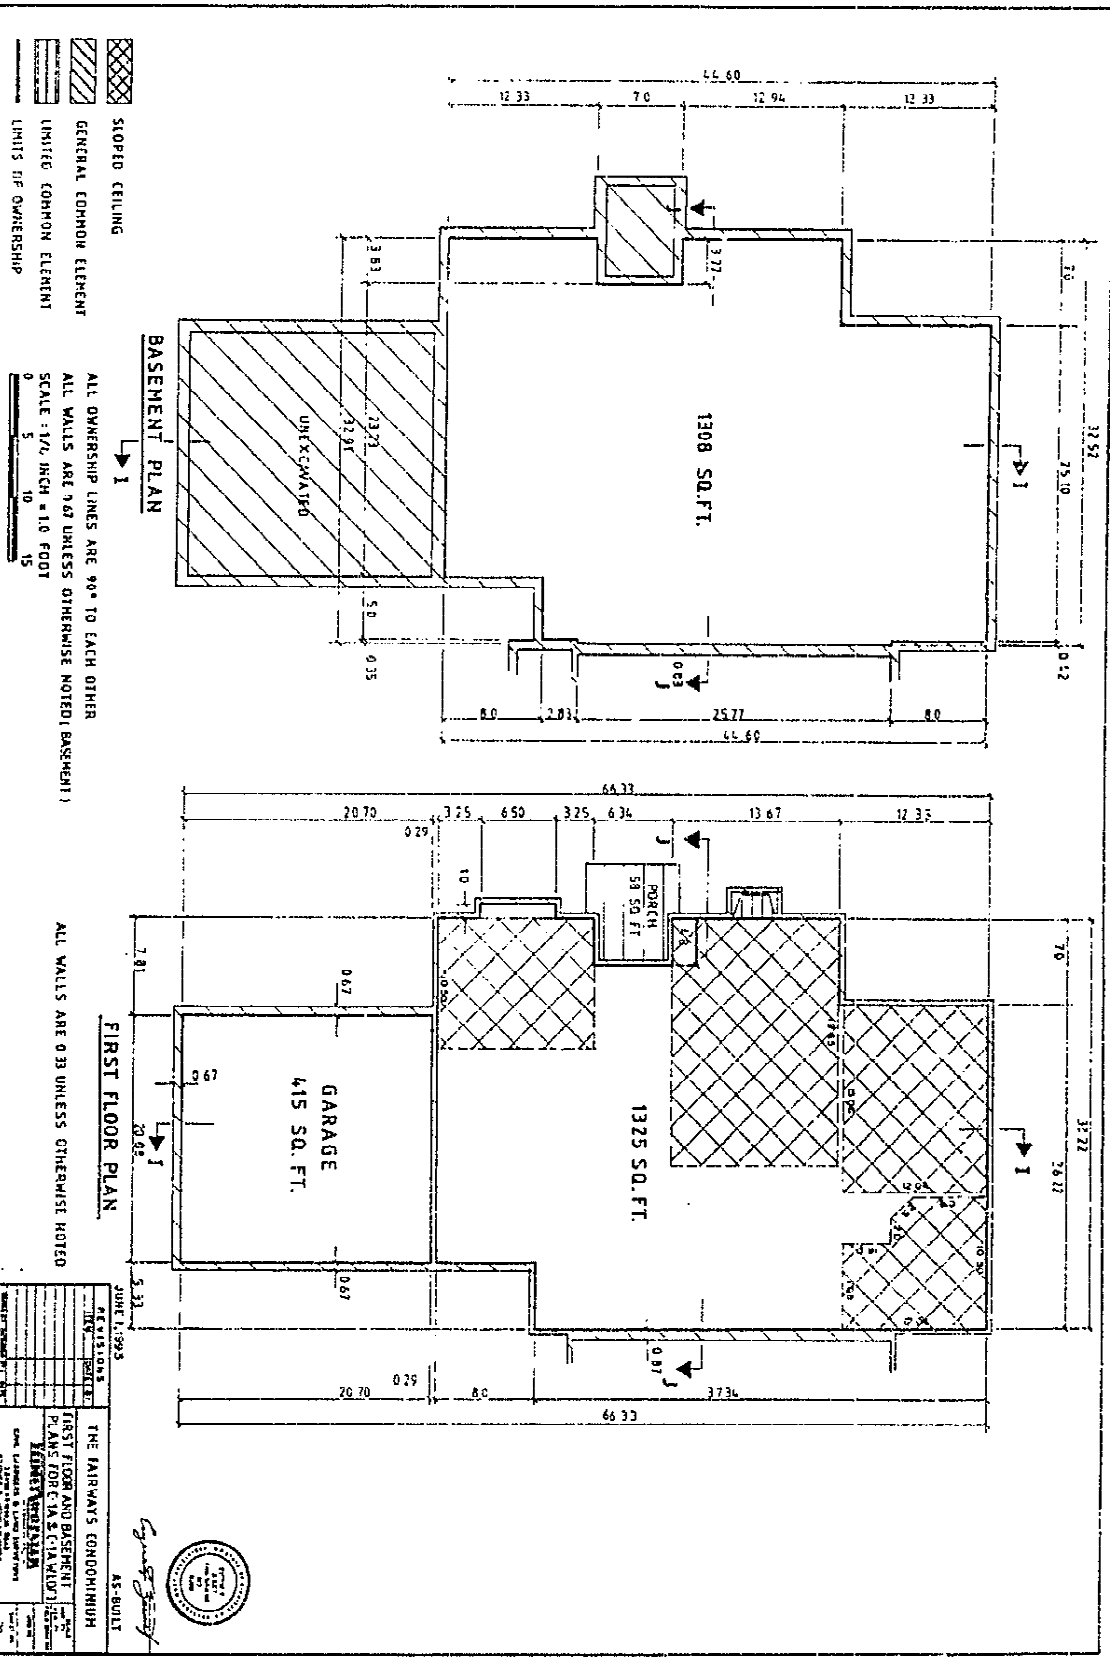








LIBER 13999P0955

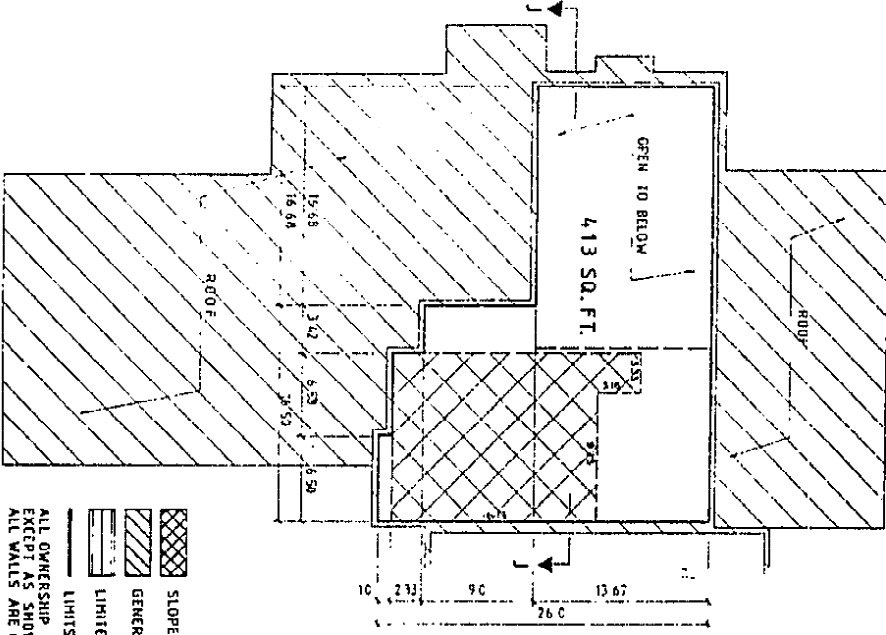

LOFT PLAN FOR C-1A PLAN

- SLOPED CEILING
 - GENERAL COMMON ELEMENT
 - LIMITED COMMON ELEMENT
- LIMITS OF OWNERSHIP
- ALL OWNERSHIP LINES ARE 90° TO EACH OTHER EXCEPT AS SHOWN
- ALL WALLS ARE 0.33 UNLESS OTHERWISE NOTED
- SCALE: 1/4" INCH = 1.0' FOOT
- 0 5 10 15

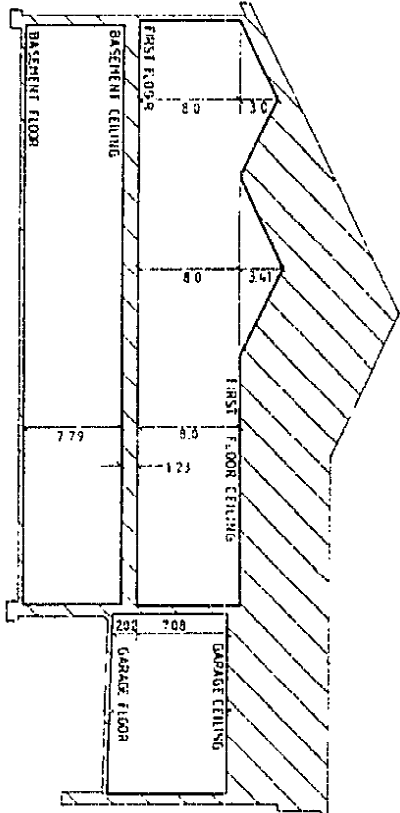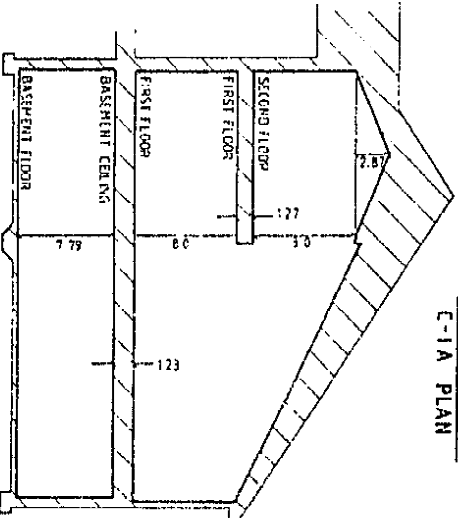

UNIT NO	FIRST FLOOR ELEVATION
62.07	696.52
66.73	694.52
72.77-03	692.52
76.81-04-08	691.52
52.92	690.02



JUNE 1, 1995

REVISIONS	DATE	BY	DESCRIPTION

THE FAIRWAYS CONDOMINIUM


GROSS SECTIONS AND LOFT PLAN FOR A C-1A PLAN

LIBBY WOODMAN

Architect

43 SOUTH

LIBER 13999/956

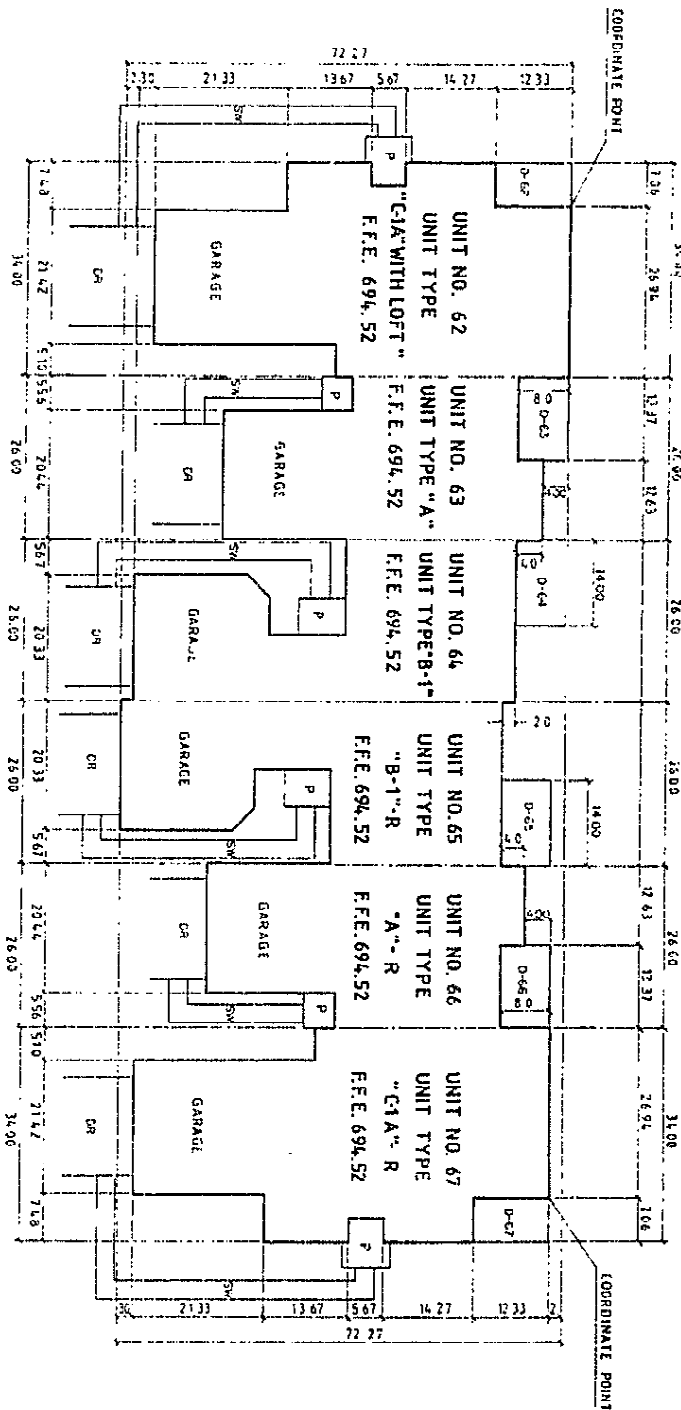

NOTES:
 D-62 DENOTES DECK-UNIT ASSIGNMENT
 DR DENOTES DRIVEWAY
 SR DENOTES SIDEWALK
 P DENOTES PORCH
 LIMITED COMMON ELEMENT
 R DENOTES REVERSE OF TYPICAL UNIT

SCALE: 1/8" INCH = 1.0 FOOT
 0 5 10 20 30



JUNE 1, 1993

REVISIONS	DATE	BY	DESCRIPTION

AS-BUILT

THE FAIRWAY'S CONDOMINIUM






37

LIBER 13999 PG 957

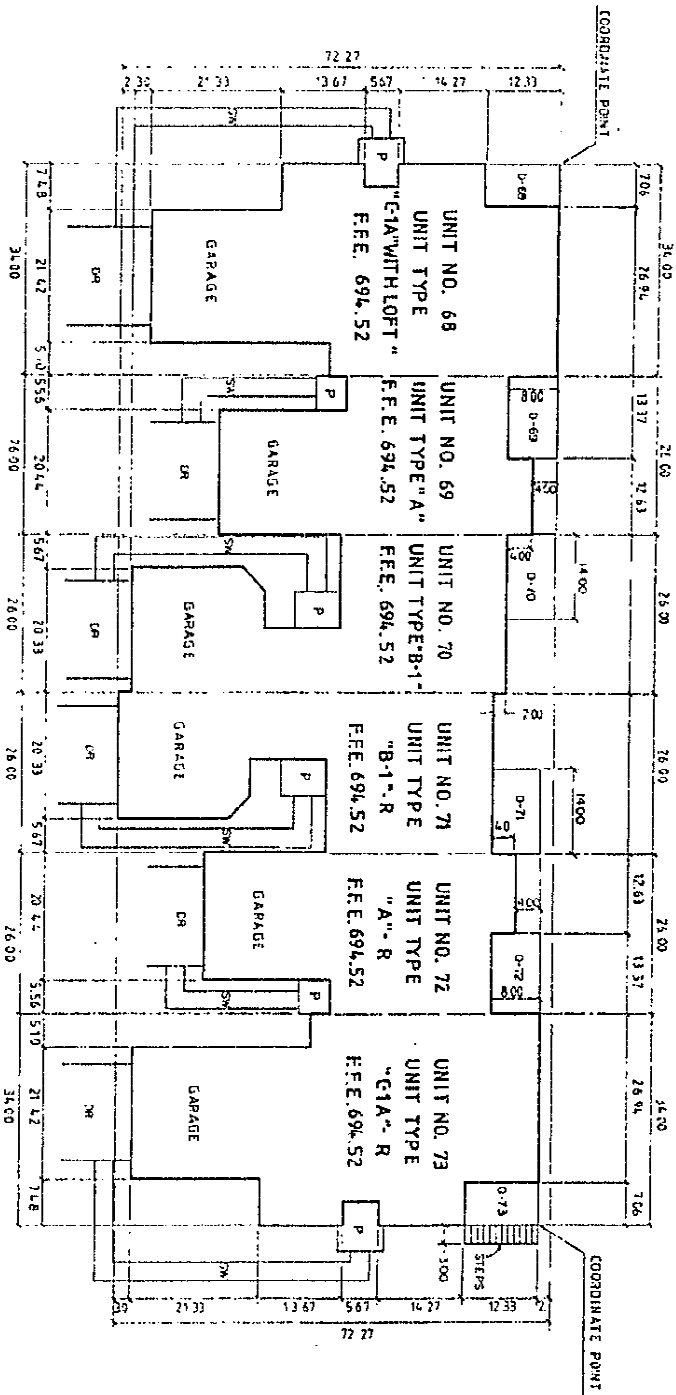

NOTES
 O-68 DENOTES DECK-UNIT ASSIGNMENT
 DR DENOTES DRIVEWAY
 SW DENOTES SIDEWALK
 P DENOTES PORCH
 LIMITED COMMON ELEMENT
 P DENOTES REVERSE OF TYPICAL UNIT

SCALE - 1/8" INCH = 1.0 FOOT
 0 5 10 20 30




James T. [Signature]

JUNE 11, 1993		AS BUILT	

LIBR 13999PG958


FIRST FLOOR PLAN

ALL WALLS ARE 0.33 UNLESS OTHERWISE NOTED

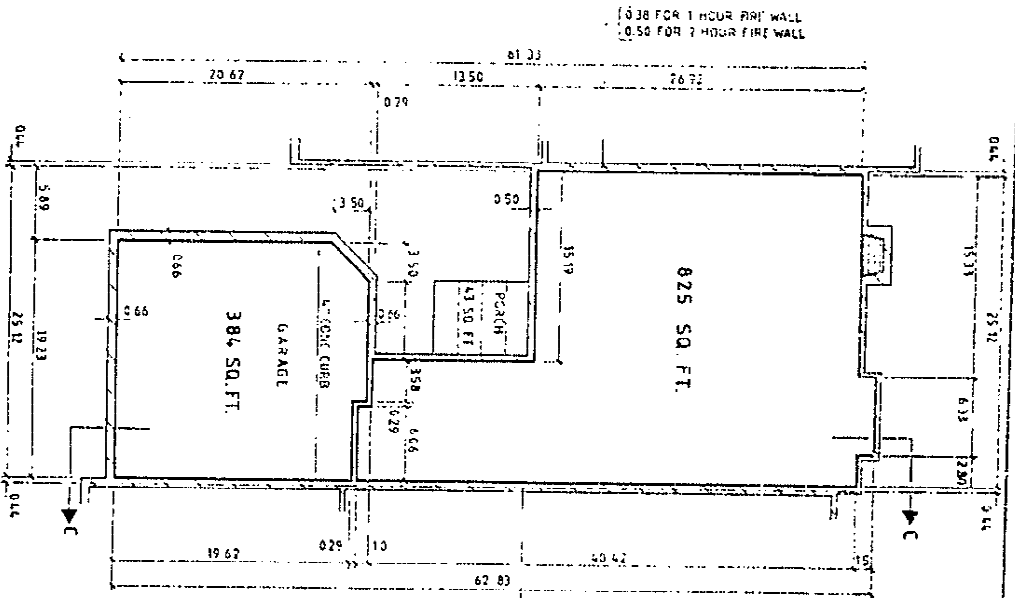

BASEMENT PLAN

ALL WALLS ARE 0.66 UNLESS OTHERWISE NOTED

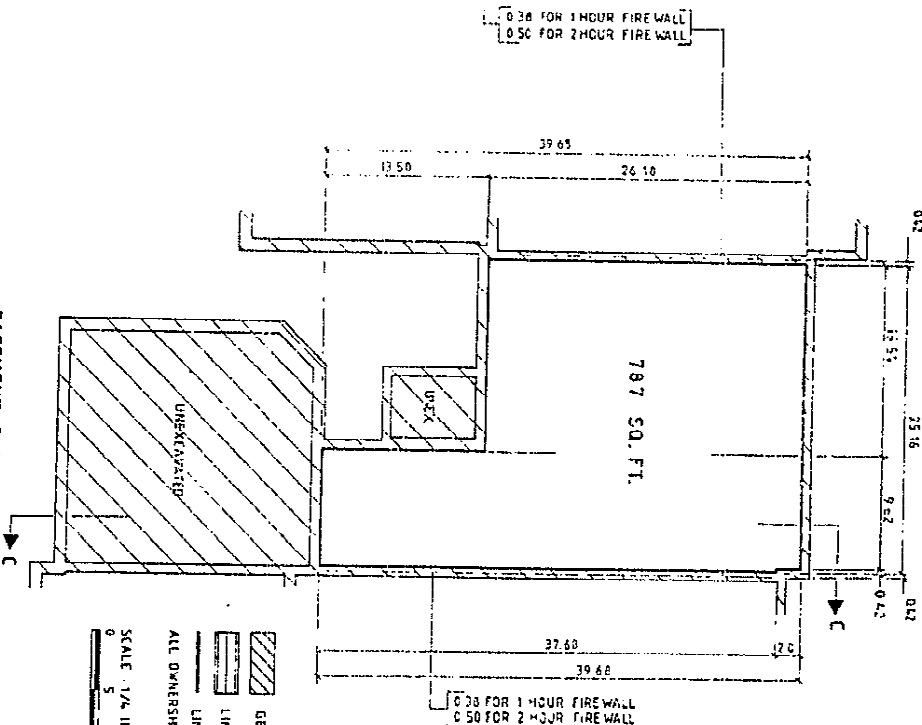


GENERAL COMMON ELEMENT
 LIMITED COMMON ELEMENT
 LIMITS OF OWNERSHIP
 ALL OWNERSHIP LINES ARE 90° TO EACH OTHER
 SCALE: 1/4" INCH = 1.0 FOOT
 0 5 10 15




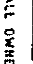


JUNE 1, 1993


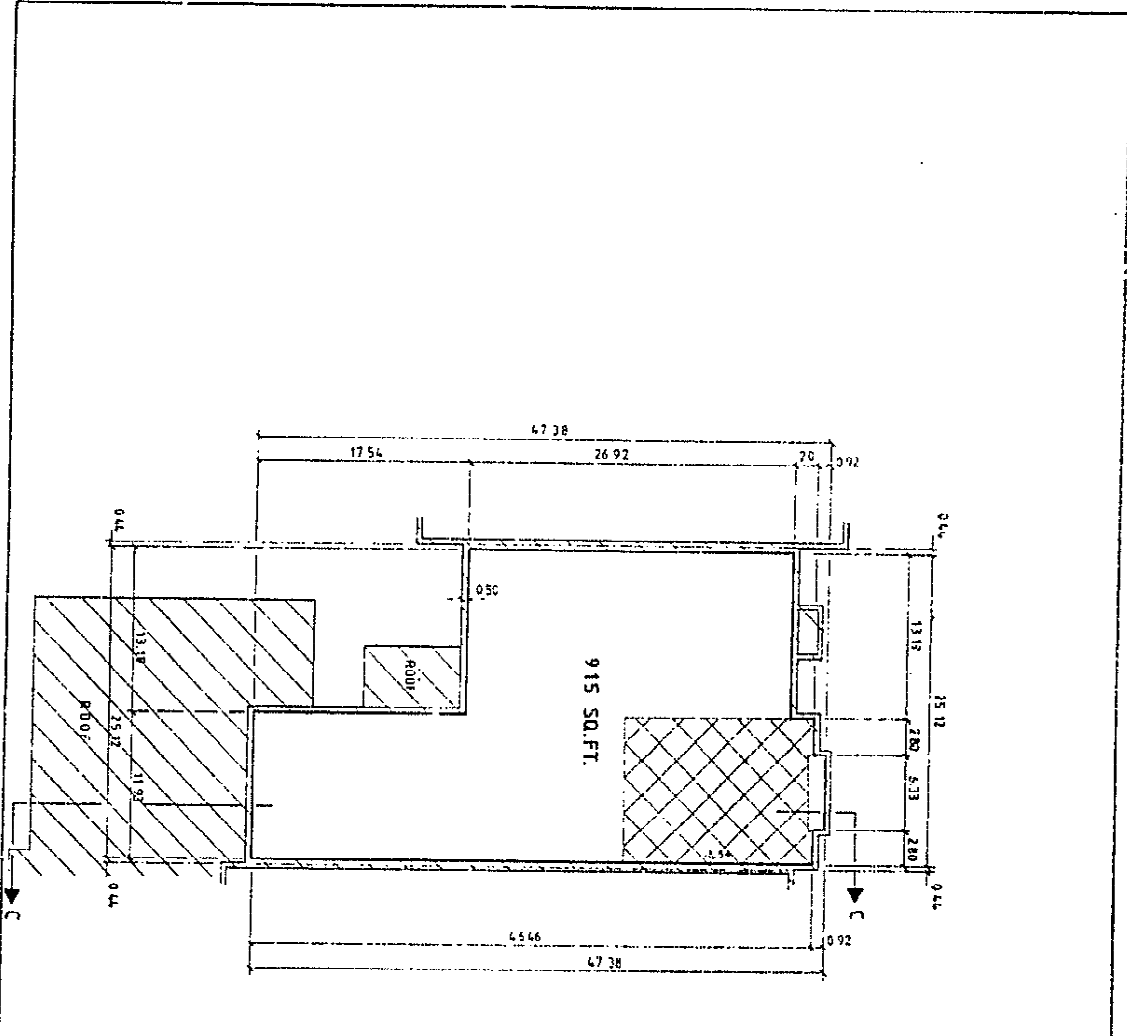LIBER 13999 PG 959



-  STOPPED CEILING
 -  GENERAL COMMON ELEMENT
 -  LIMITED COMMON ELEMENT
 -  LIMITS OF OWNERSHIP
- ALL OWNERSHIP LINES ARE 90° TO EACH OTHER
 ALL WALLS ARE 9.25 UNLESS OTHERWISE NOTED
 SCALE: 1/8 INCH = 10 FEET
- 0 5 10 15
 ENTER WALL




JUNE 1, 1993


THE FAIRMAYS CONDOMINIUM
 TYPICAL SECOND FLOOR PLAN
 FOR UNIT NO. 35
 AS-BUILT

35

LIBER 13999 PG 960

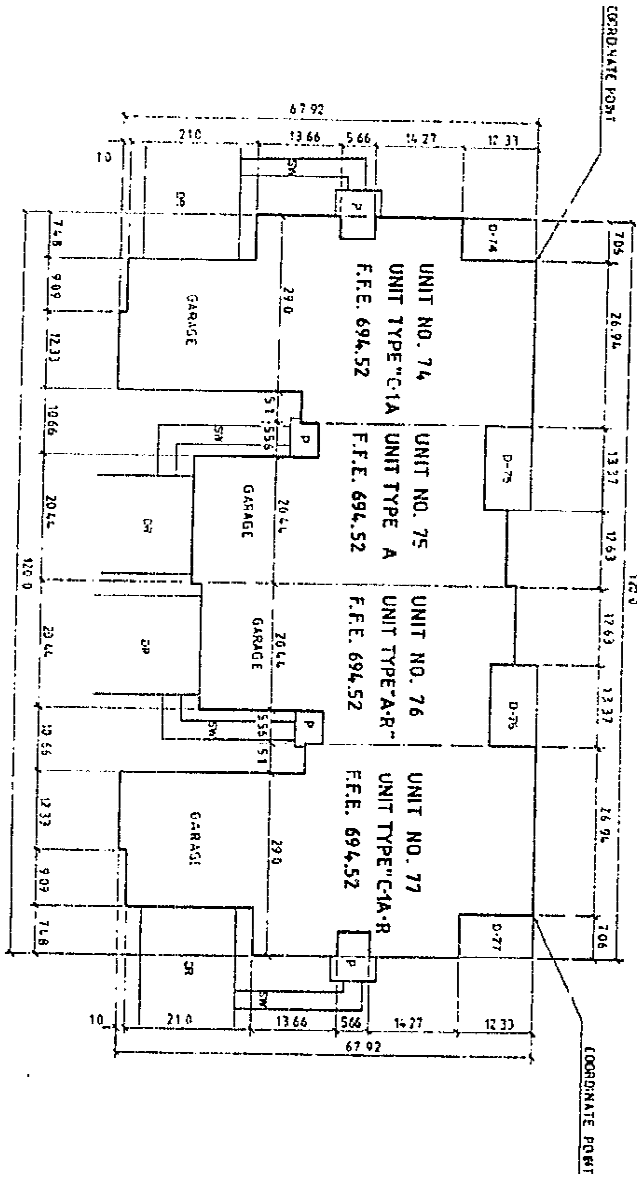

NOTES:
 D-74 DEMOTES DECK-UNIT ASSIGNMENT
 DR DEMOTES DRIVEWAY
 SW DEMOTES SIDEWALK


P DEMOTES PORCH
 LIMITED EJECTION ELEMENT
 R DEMOTES REVERSE OF TYPICAL UNIT
 CENTERLINE

SCALE : 1/8 INCH = 10 FOOT
 0 5 10 20 30



JUNE 1, 1993		AS-BUILT	

LIBER 13999 PG 961

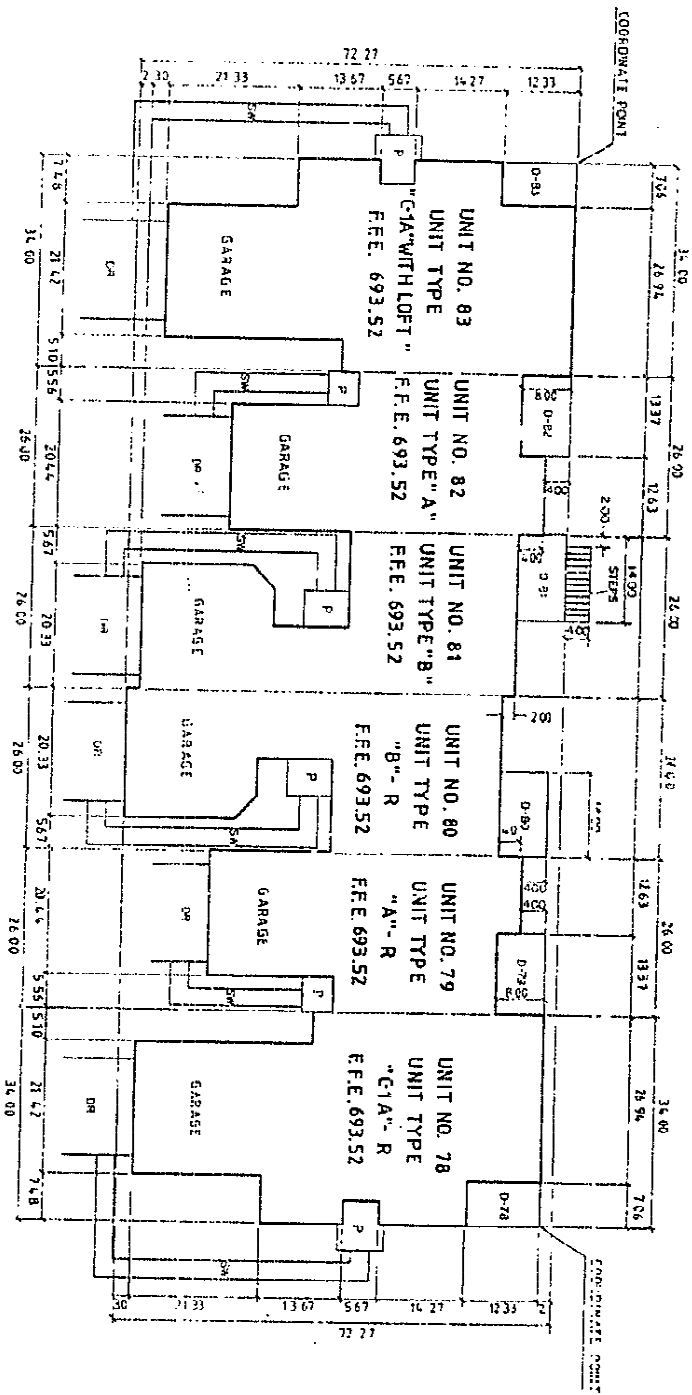

NOTES:

- D-B3 DENOTES DECK-UNIT ASSIGNMENT
- DR DENOTES DRIVEWAY
- SM DENOTES SIDEWALK
- P DENOTES PORCH
- LIMITED COMMON ELEMENT
- R DENOTES REVERSE OF TYPICAL UNIT









JUNE 1, 1993	
THE FAIRWAYS CONDOMINIUM	
PERIMETER PLAN	
FOR BUILDING 2	
37	

LIBER 133990962

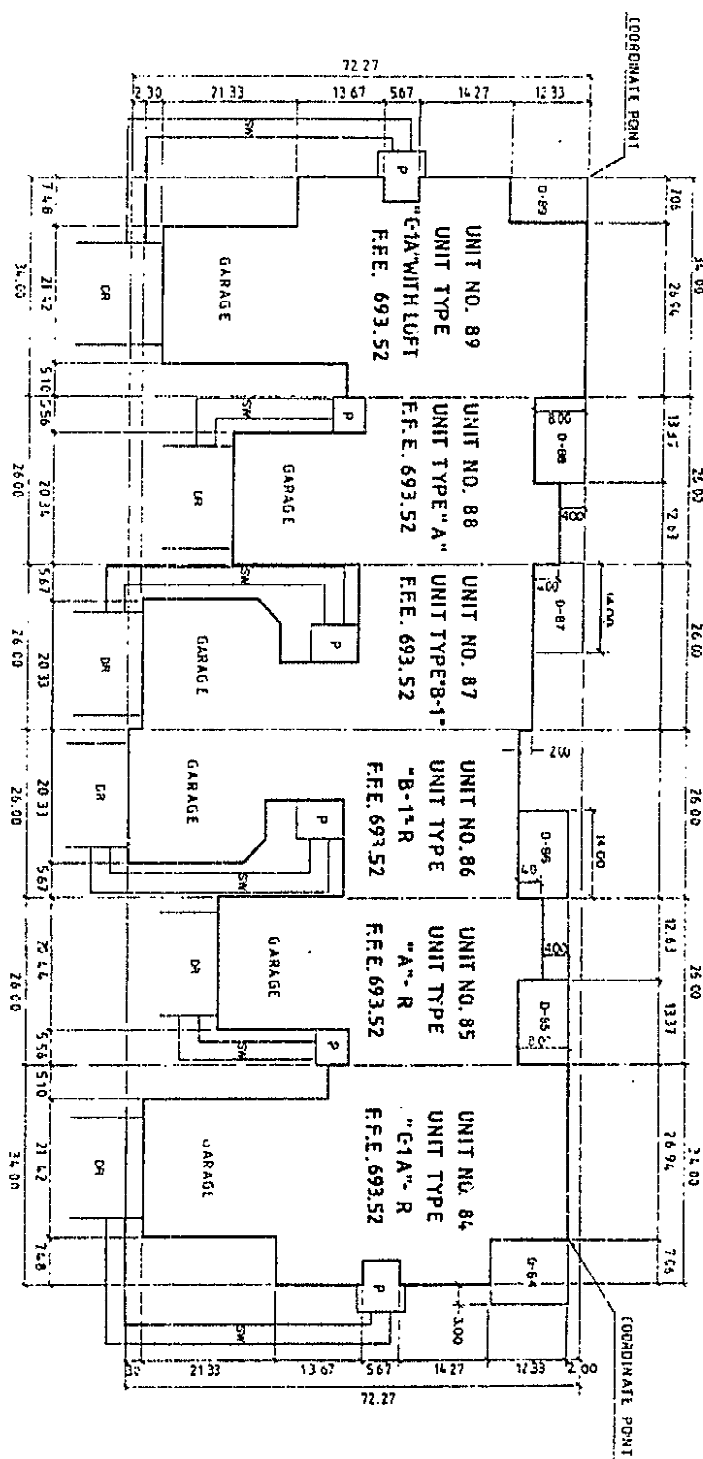

NOTES
 P DENOTES PORCH
 R DENOTES REVERSE OF TYPICAL UNIT
 DR DENOTES DRIVEWAY
 SW DENOTES SIDEWALK
 LIMITED COMMON ELEMENT


SCALE: 1/4" INCH = 1'0" FOOT
 0 5 10 20 30



NO.	DATE	REVISION
1	JUNE 1, 1993	AS-BUILT

THE FARWAY'S CONDOMINIUM
 PERMETER PLAN
 FOR BUILDING 3
 30

LIBR 13999 0963

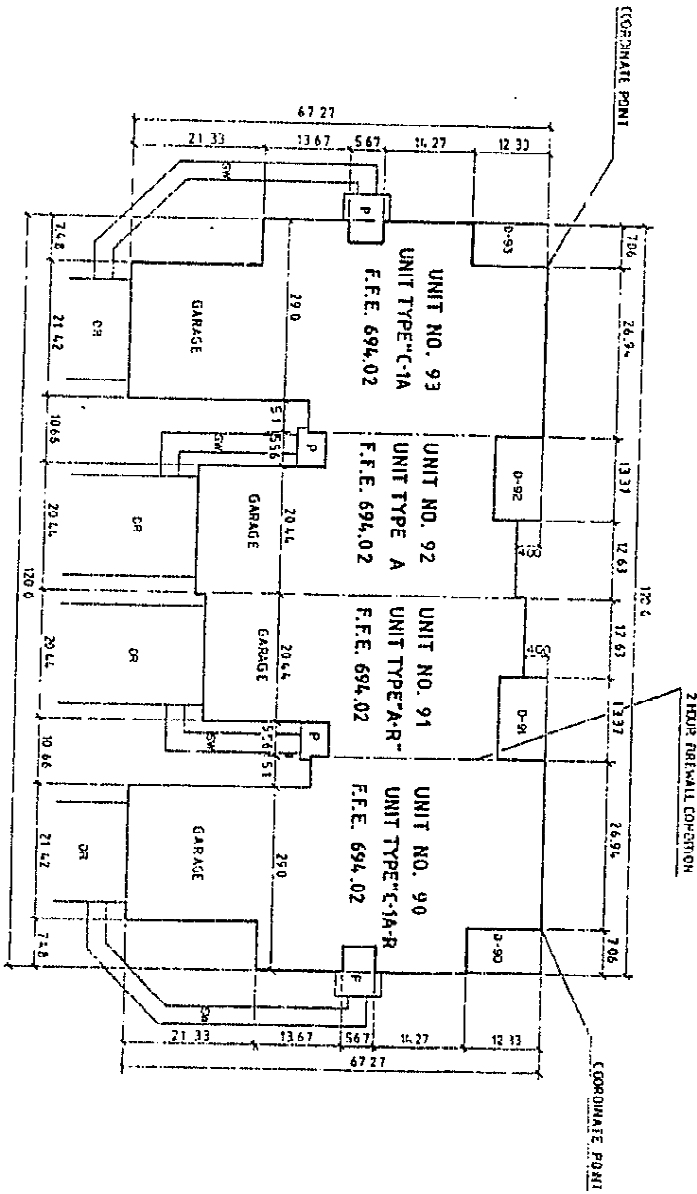

- NOTES
- D-93 DENOTES DECK-UNIT ASSIGNMENT
 - SK DENOTES DRIVEWAY
 - SW DENOTES SIDEWALK
 - P DENOTES PORCH
 - LIMITED COMMON ELEMENT
 - R DENOTES REVERSE OF TYPICAL UNIT CENTERLINE

SCALE : 1/8" INCH = 1'-0" FOOT
 0 5 10 20 30




JUNE 4, 1993

REVISION	DATE	BY	DESCRIPTION

AS-BUILT

THE FABRAYS CONDOMINIUM
 PERMETER PLAN
 FOR BUILDING 1

LIBER 13999 PG 964

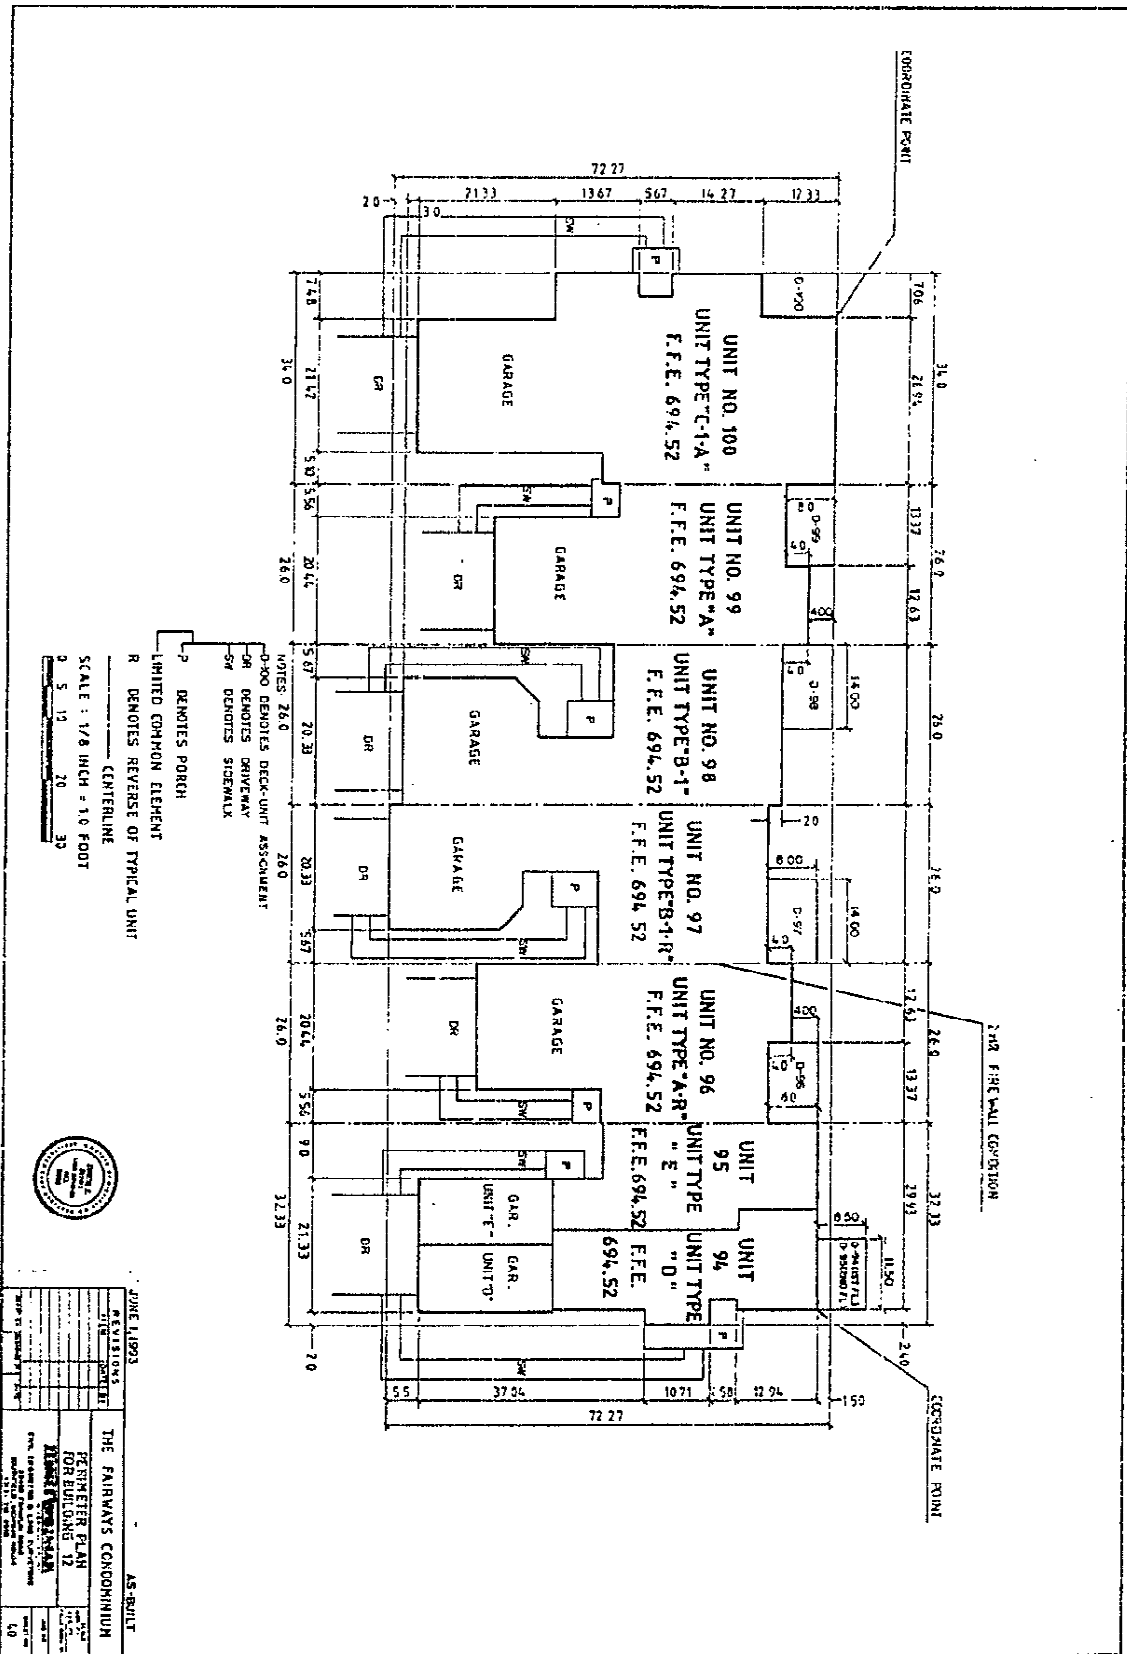

- P DENOTES PORCH
- LIMITED COMMON ELEMENT
- R DENOTES REVERSE OF TYPICAL UNIT
- CENTERLINE
- D-300 DENOTES DECK-UNIT ASSIGNMENT
- DR DENOTES DRIVEWAY
- SW DENOTES SIDEWALK

SCALE: 1/8" INCH = 10' FOOT
 0 5 10 20 30




REVISIONS	DATE	BY	DESCRIPTION

AS-BUILT

THE FAIRWAYS CONDOMINIUM

PENNIETER PLAN FOR BUILDING 12

LIBER 13999 PG 964


SCALE: 1/8" = 10'

10